


PLAN AND PROFILE

OF THE PROPOSED STREET IMPROVEMENT OF


COVER STREET

BETWEEN BROCKTON AVE. AND PALM AVENUE
 ENG DEPT. RIVERSIDE, CALIF. MAY 1934.
 FIELD BOOK 284 PAGES 40-53
 CITY (U.S.G.S) DATUM PLANE

Constructed by Street Dept. 1934

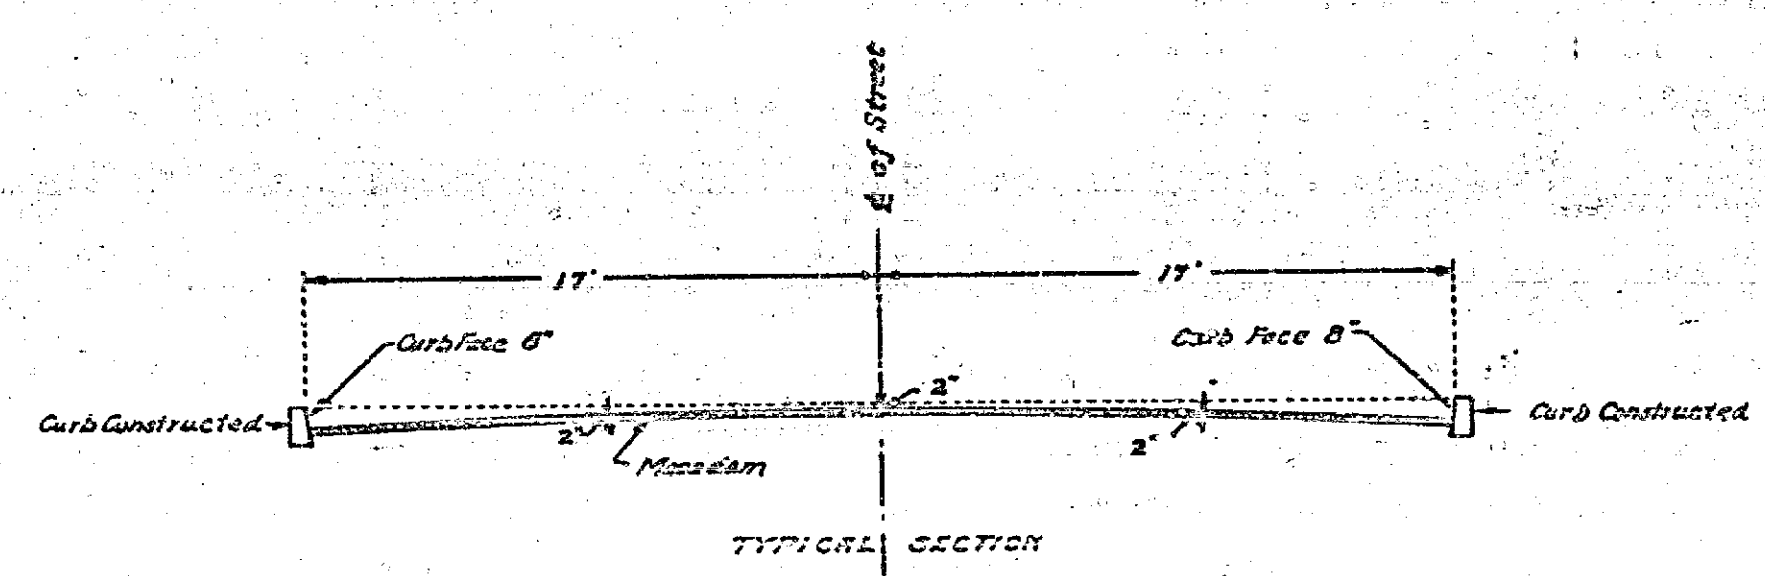

SCALE
 HOR. 1"=40'
 VER. 1"=4'

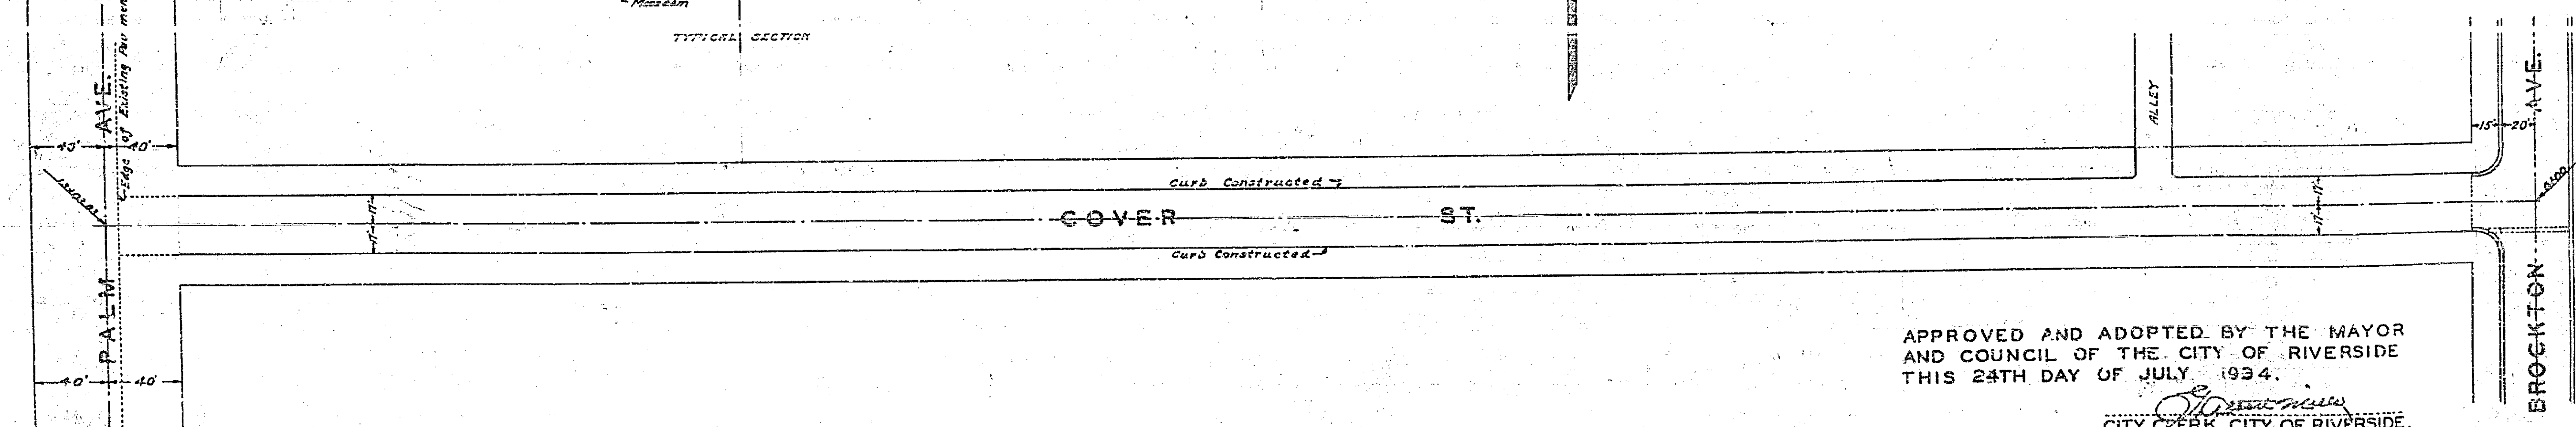

APPROVED AND ADOPTED BY THE MAYOR
 AND COUNCIL OF THE CITY OF RIVERSIDE
 THIS 24TH DAY OF JULY 1934.

CITY CLERK, CITY OF RIVERSIDE.

532