


RIVERSIDE CALIF. NINTH ST. & VINE ST.

U. P. R. R. CROSSING NO 3-574

APRIL 9, 1945.

SCALE HOR. 1"=20'
VER. 1"=6'

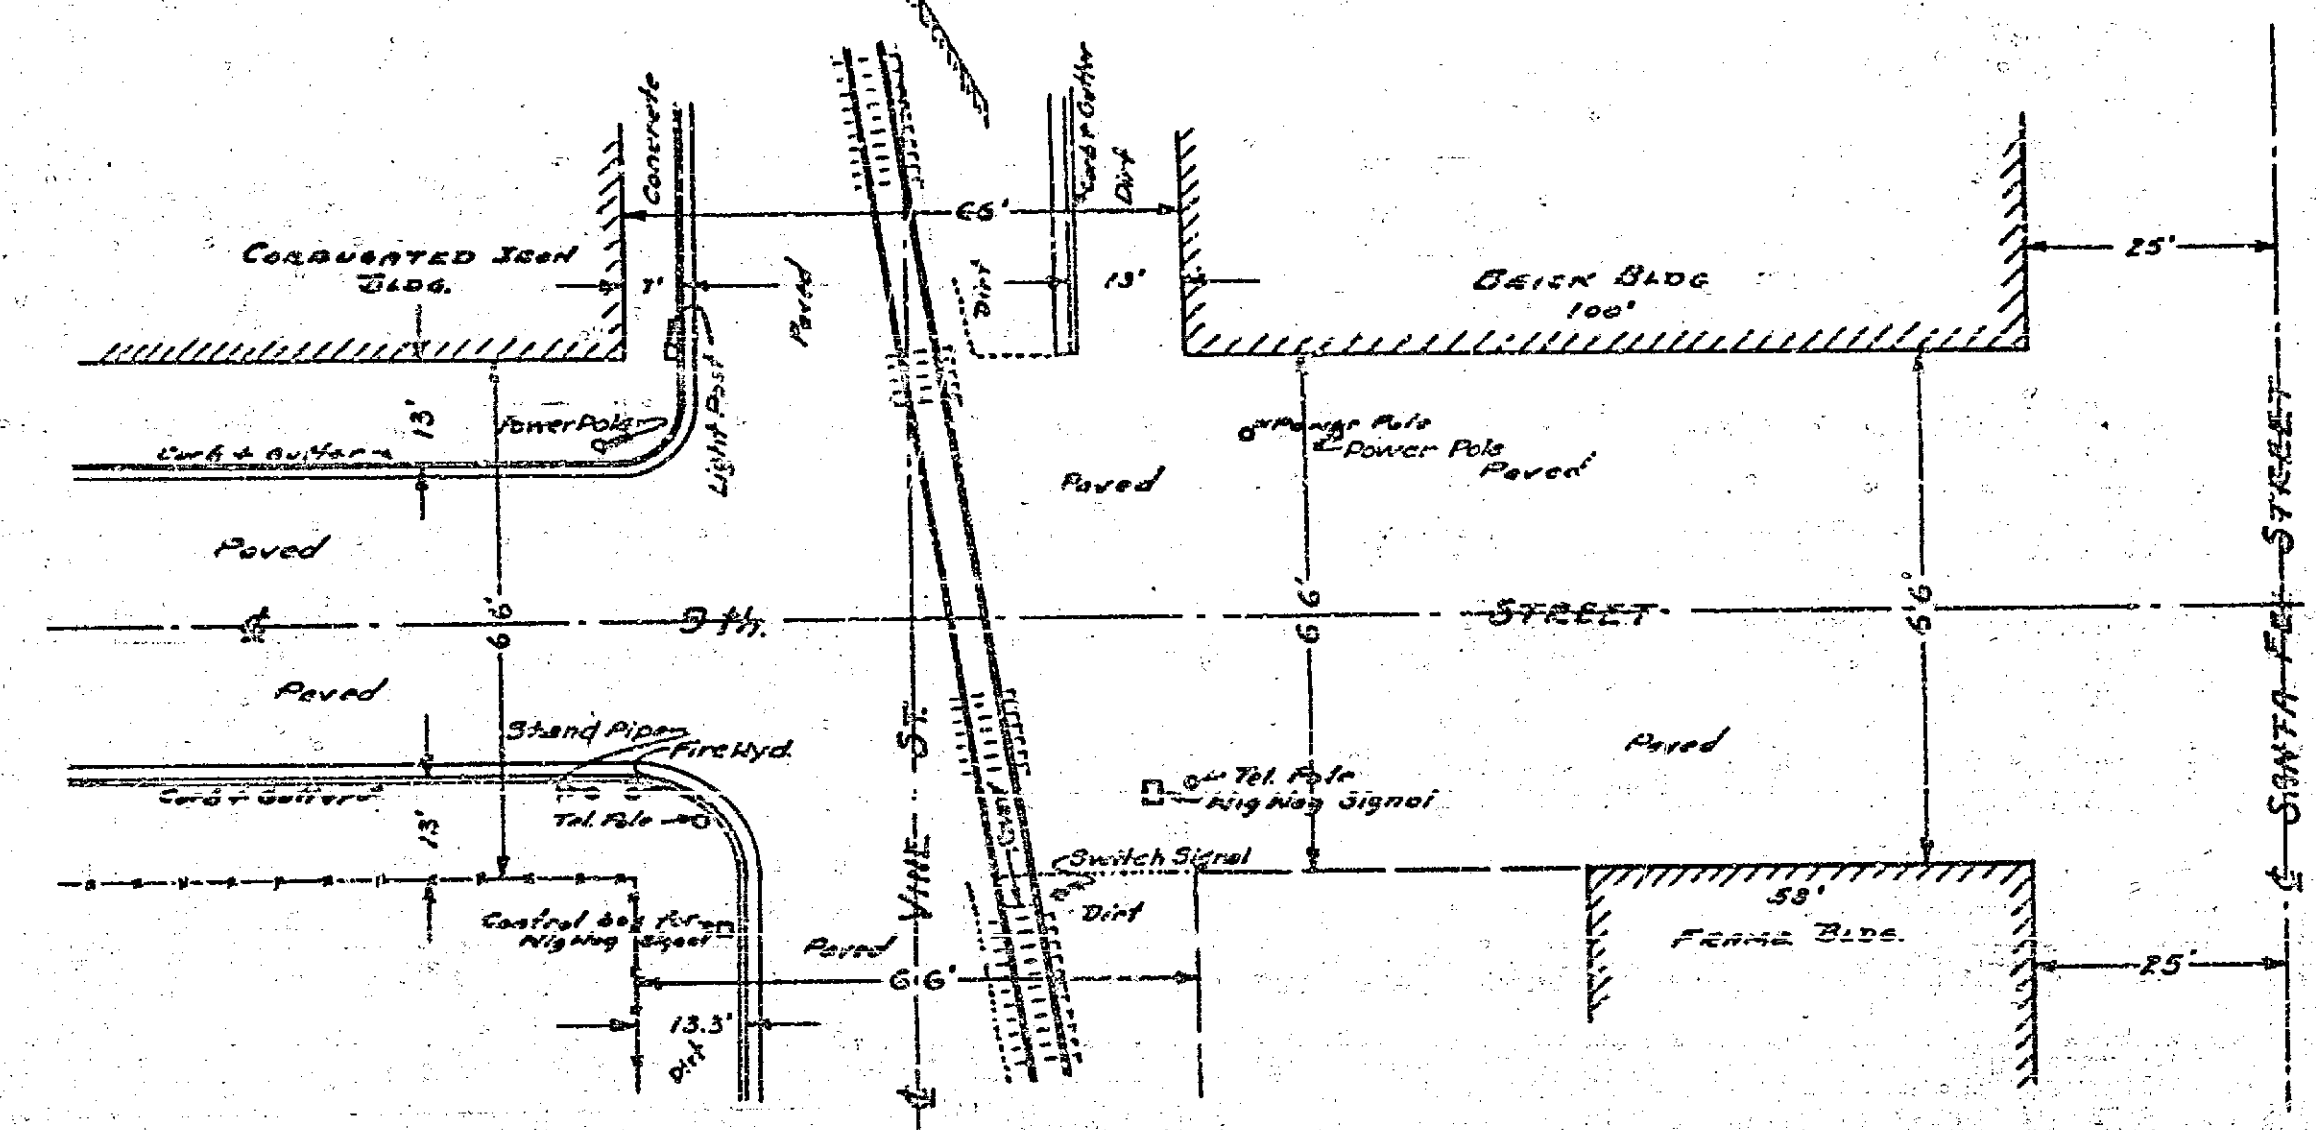

539

539