


40

B.L. Ry. Co.
Paper profile 540
321/13-16

ALLEY - BLOCK 6, RIVERSIDE			
DRAWING NUMBER	SHEET NUMBER	TOTAL SHEETS	PLANS
540	1	1	527
DRAWN BY		CHECKED BY	APPROVED BY
G.S.M. 3/25/16			

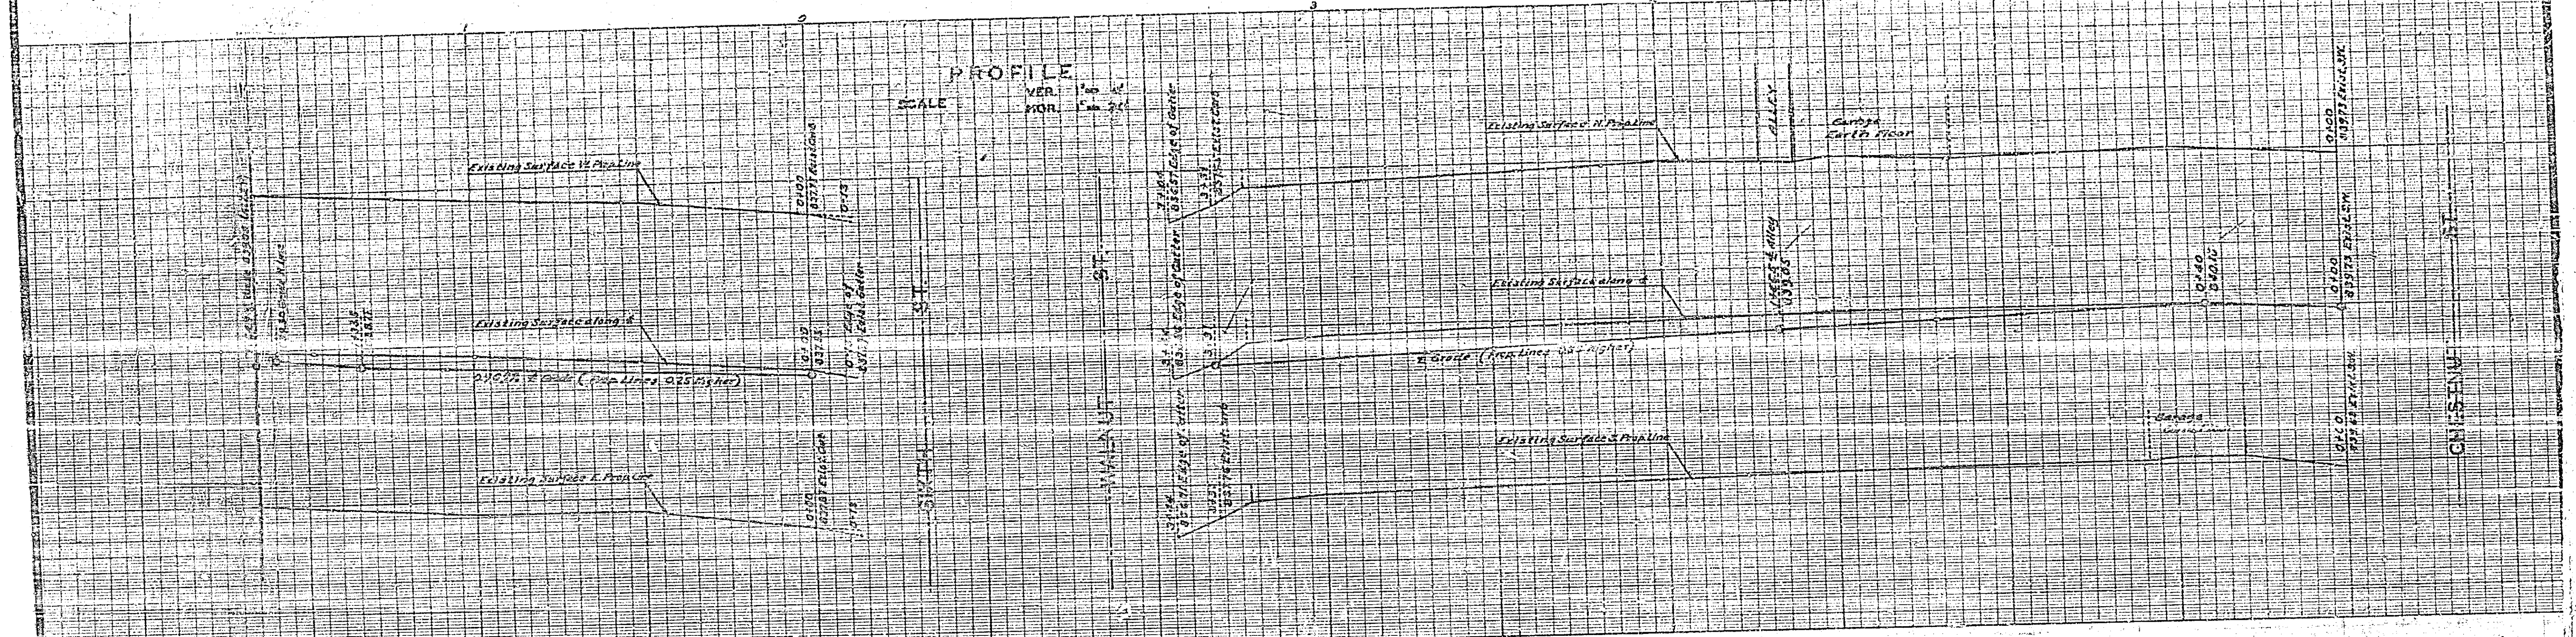

PLAN AND PROFILE

OF THE PROPOSED IMPROVEMENT ON

ALLEY BLK 6 RG 10


BETWEEN WALNUT ST. & CHESTNUT ST.

ENGINEERING DEPT. RIVERSIDE CALIF. 1935.
 CITY (U.S.G.S.) DATUM PLANE
 FIELD BOOK 321 PAGES 13-16
 Grades 321/64

APPROVED _____
 CITY ENGINEER

SCALE VER. 1" = 4'
 HOR. 1" = 20'

SCALE VER. 1" = 4'
 HOR. 1" = 20'

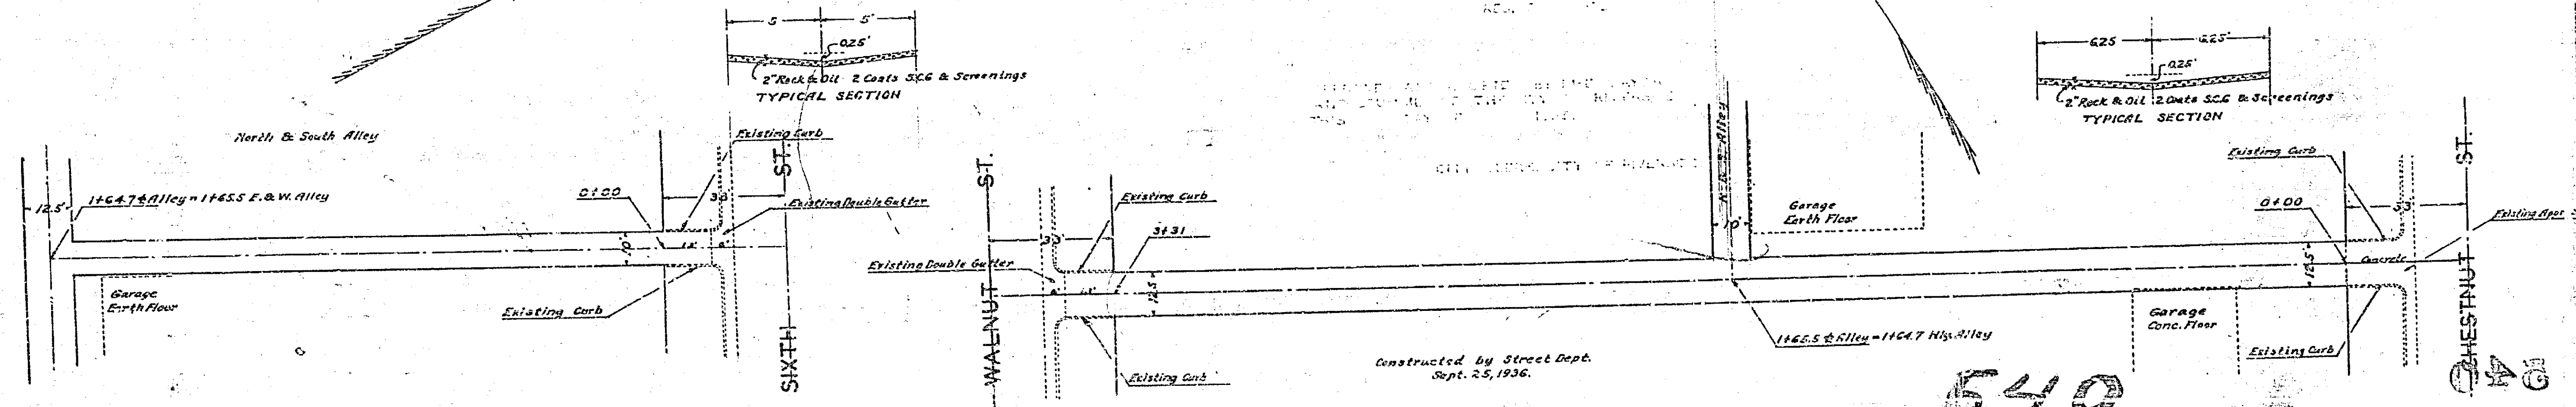

540

61