
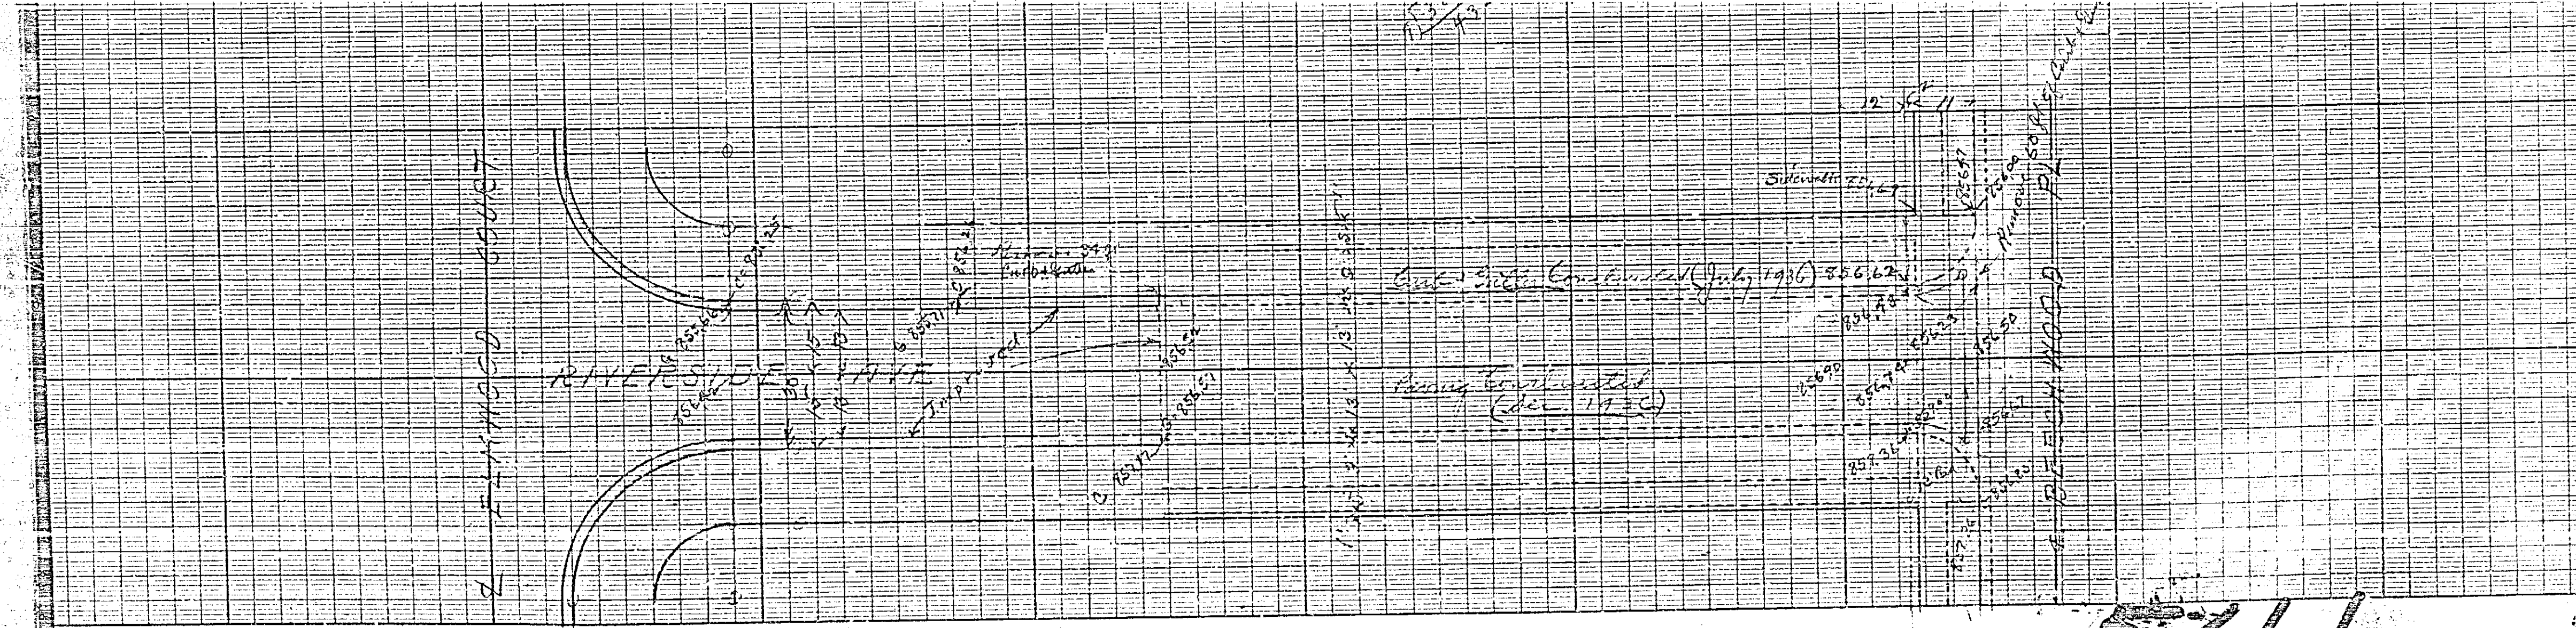


Riverside Ave between Elmwood Court & Beechwood Pl.
BK 323 Pg 54-58

264
124
140

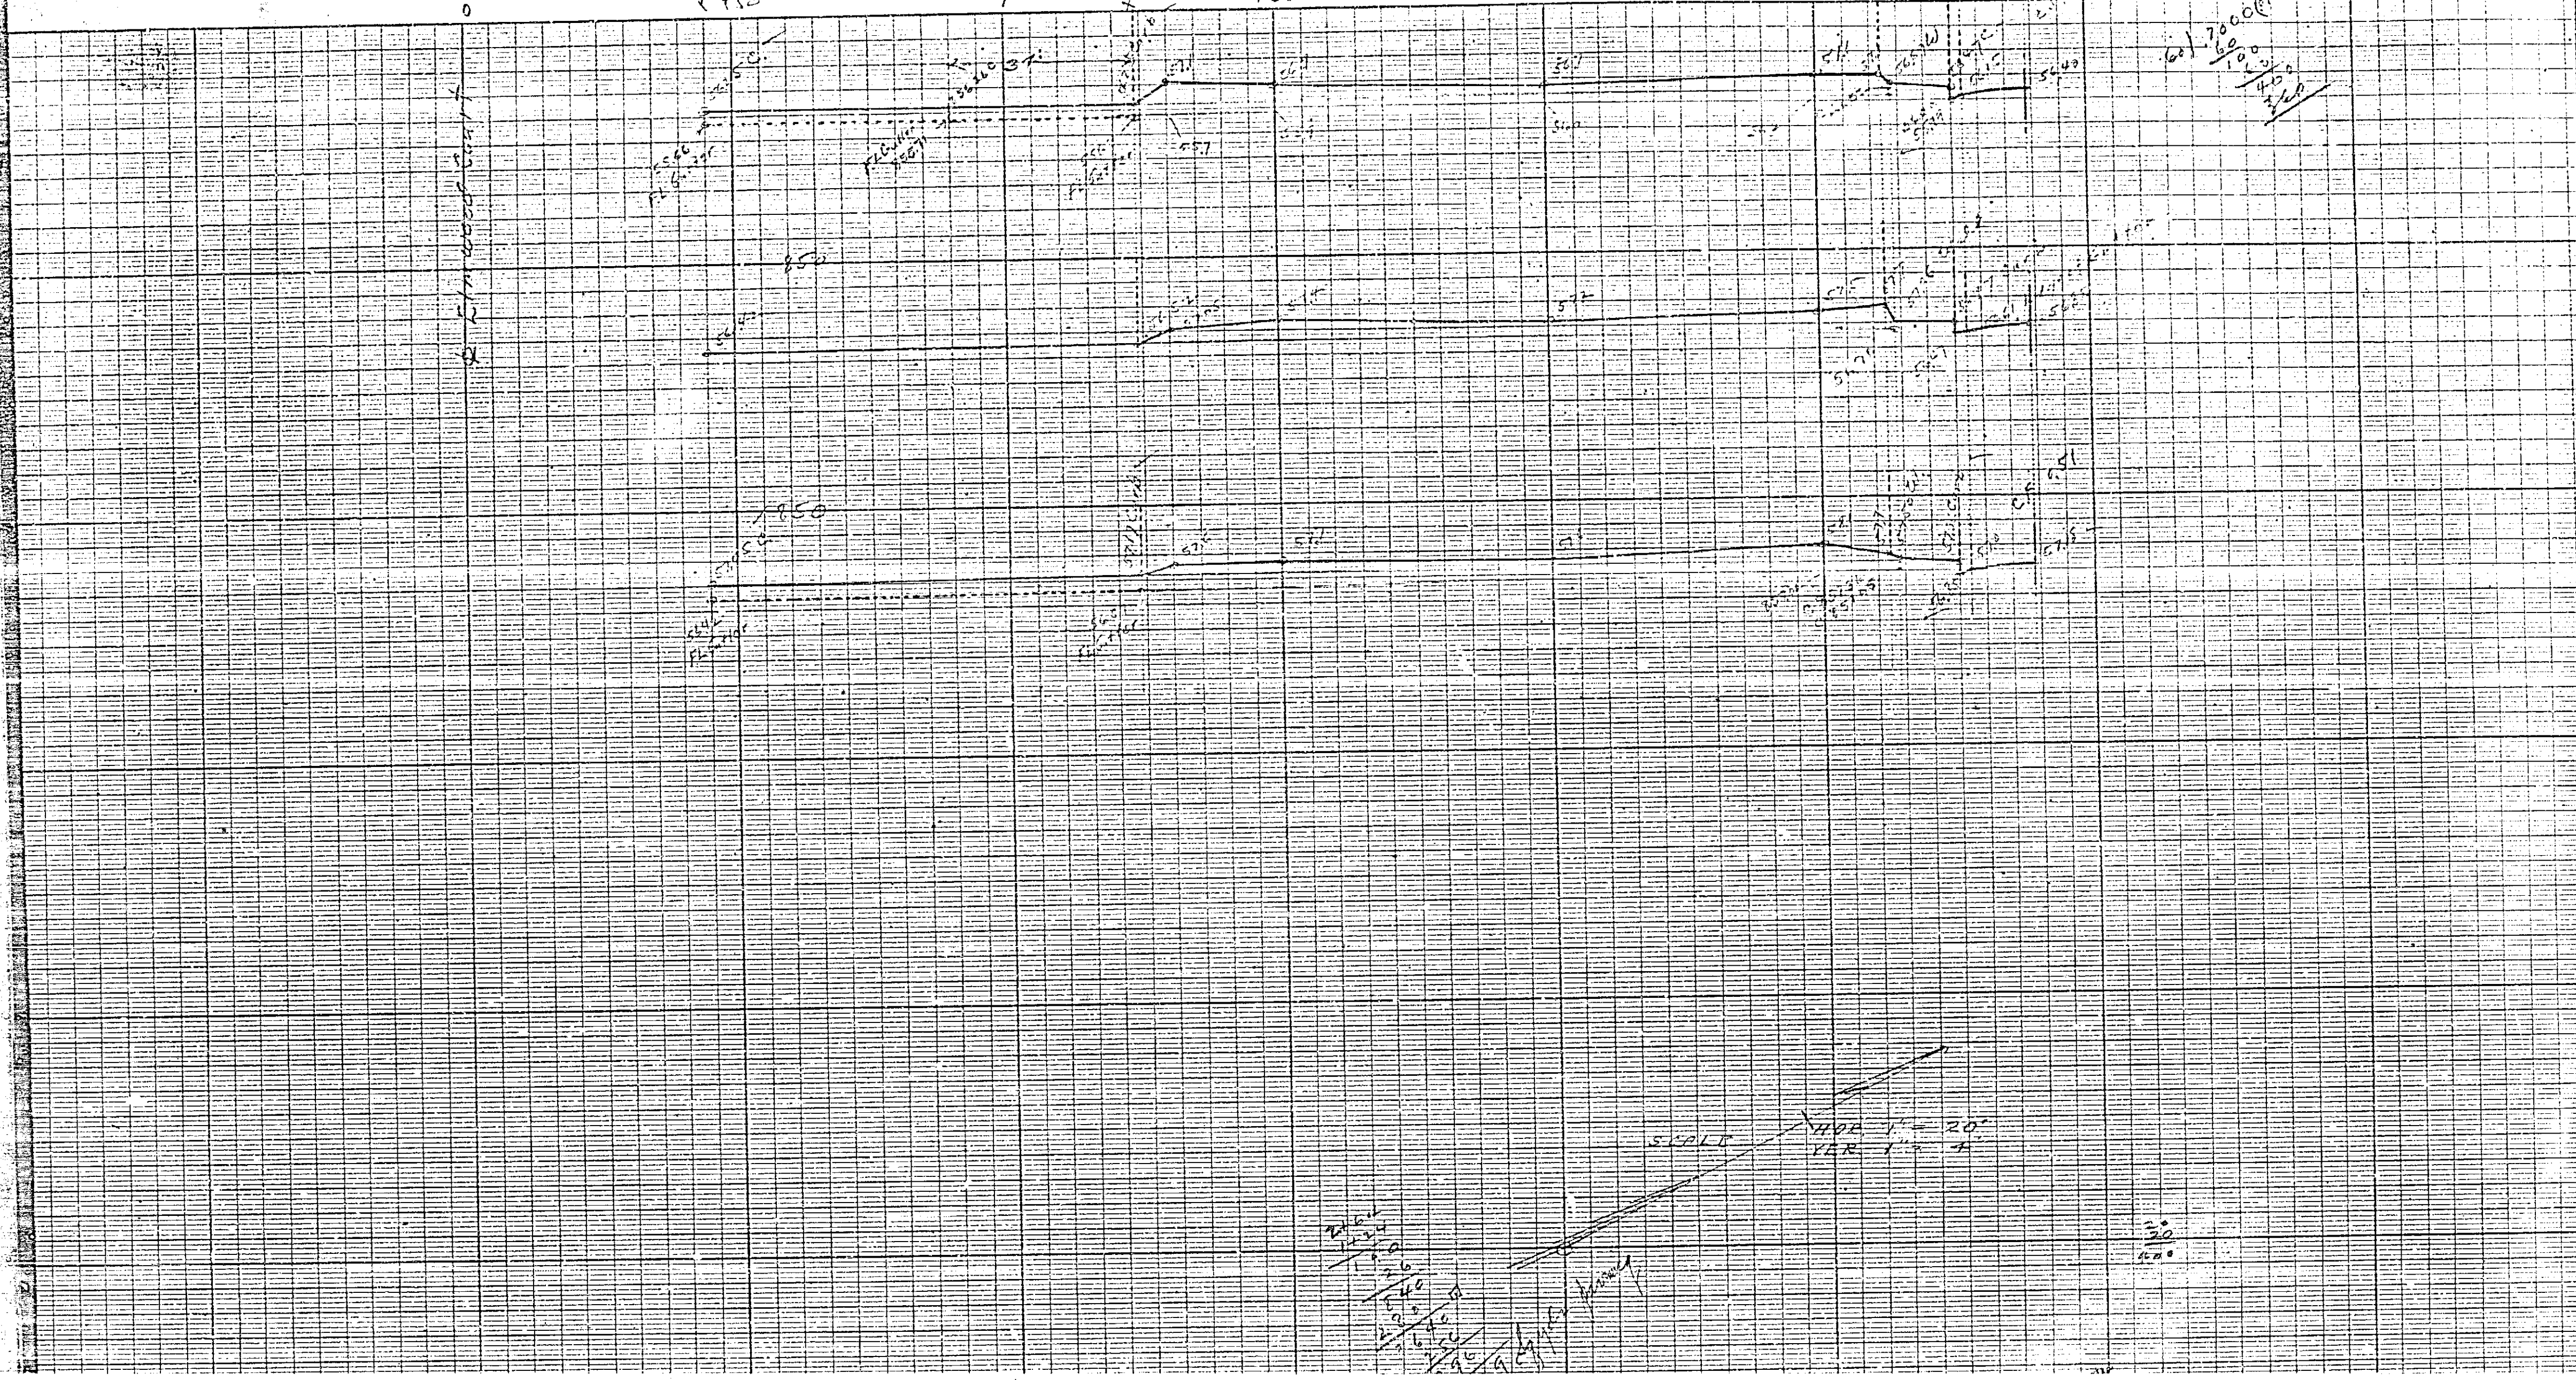

541