

KANSAS AVENUE

BLAINE ST. TO MASSACHUSETTS AVE.

ENGINEERING DEPT. RIVERSIDE, CALIF. JUNE, 1945.

CITY (U.S.G.S) DATUM PLANE

F.B. 413; PG. 25
430


APPROVED
CITY ENGINEER.

DRAWING NUMBER	SHEET NUMBER	TOTAL SHEETS	FIELD BOOKS
554			1/3
DRAWN BY	CHECKED BY	APPROVED BY	
RED	RED		

BLAINE ST.


MONTGOMERY DR.

MASSACHUSETTS AVE.

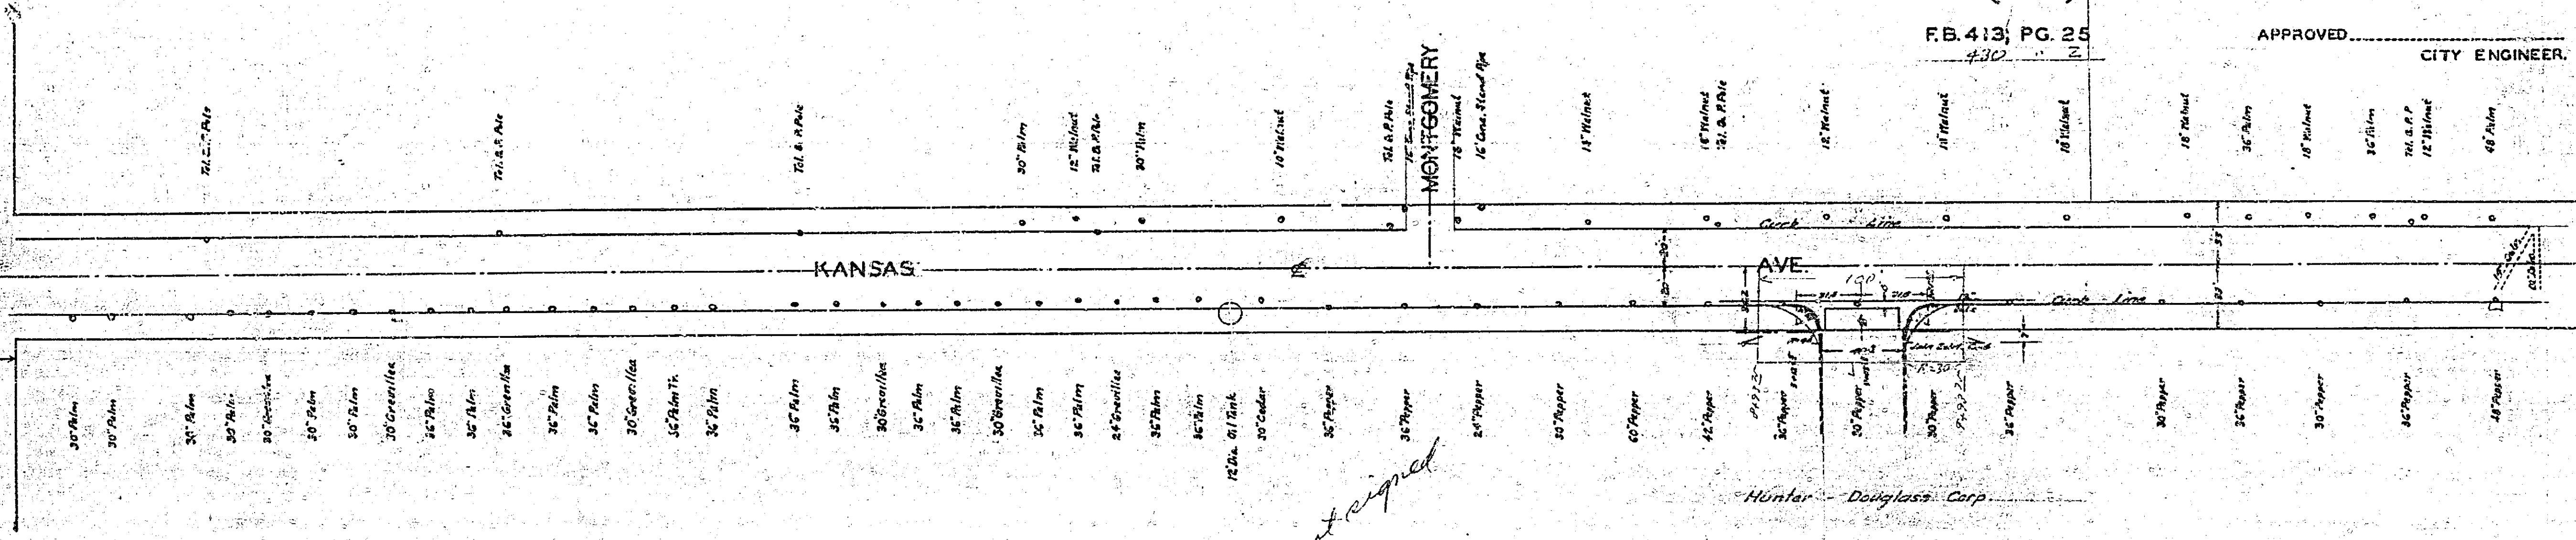

Notes subject to change, tracing not signed

SCALE
HOR. 1" = 40'
VER. 1" = 4'

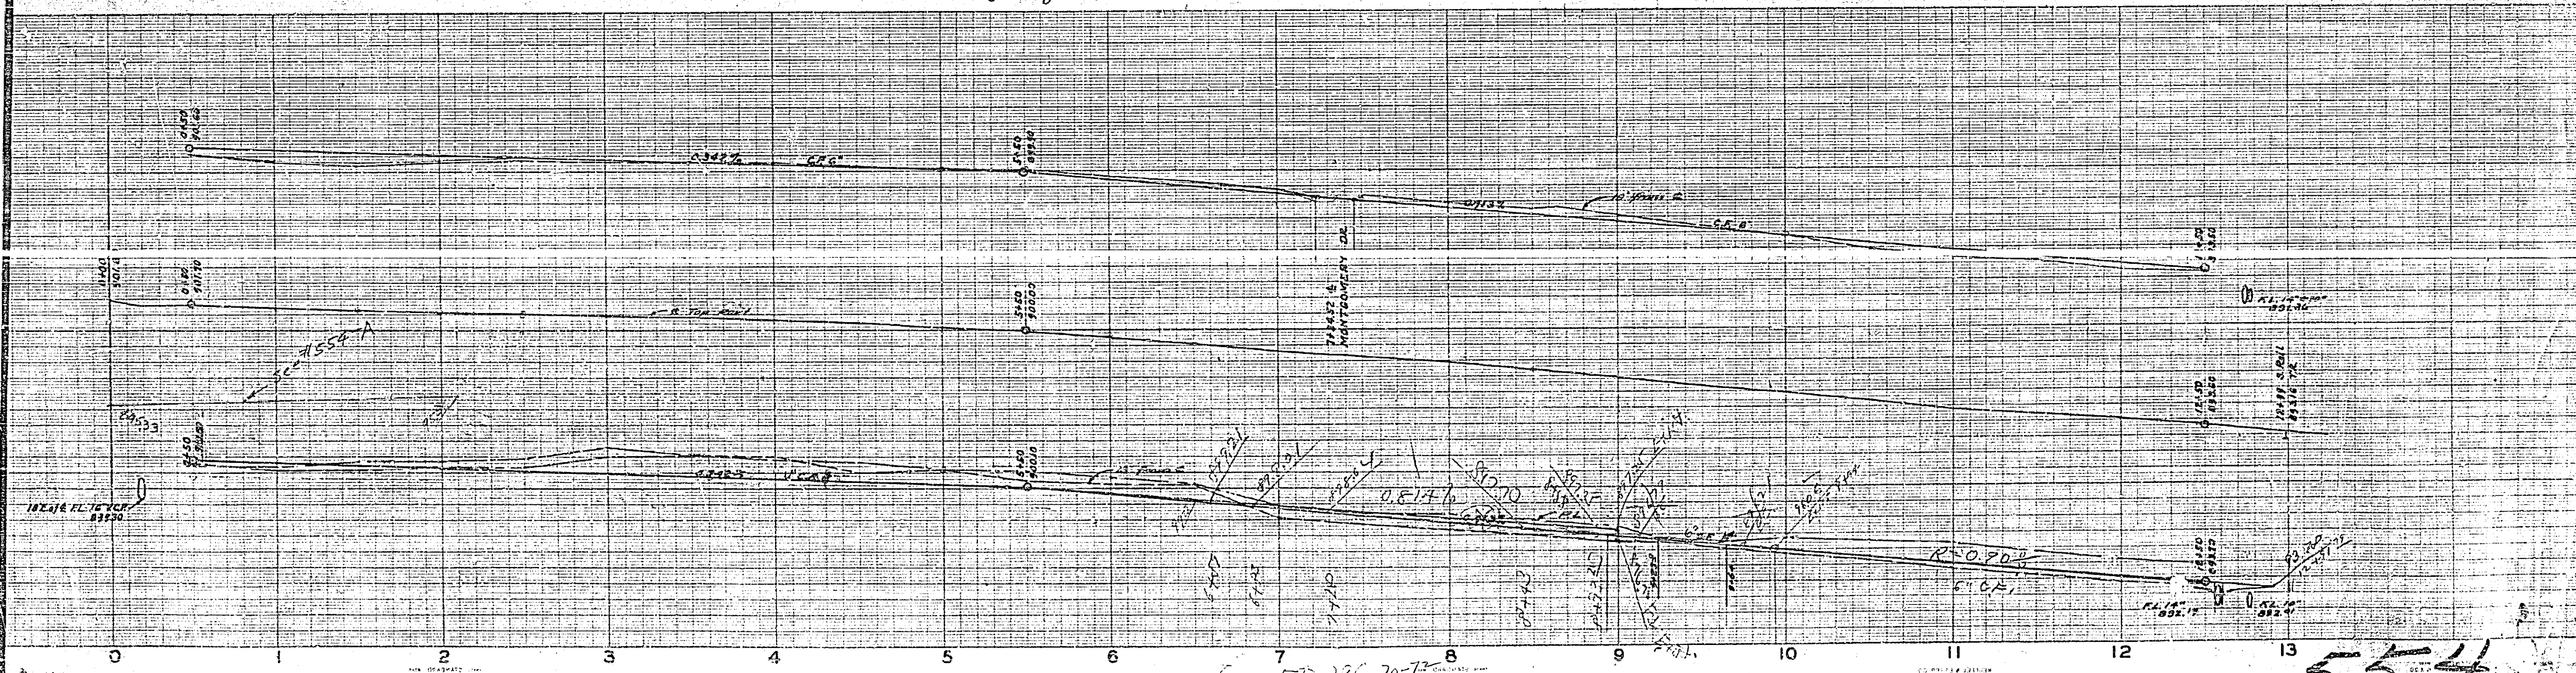

F.B. 376-70-17
cut sheet 12-17-51
00816

554