



UNIVERSITY MANOR  
 McDERMOTT TRACT  
 Sub. 5, 6, 7 & 8, Paved  
 PLANS AND PROFILES  
 Mar. 1950 Scale 1/4" = 10'-0"  
 Moody St. shown on Sheet 3 of Section P-15  
 Approved 1950 P. H. J. J. J.  
 City Engineer  
 Drawn by J.M.  
 Sheet 2 of 3 sheets

577A

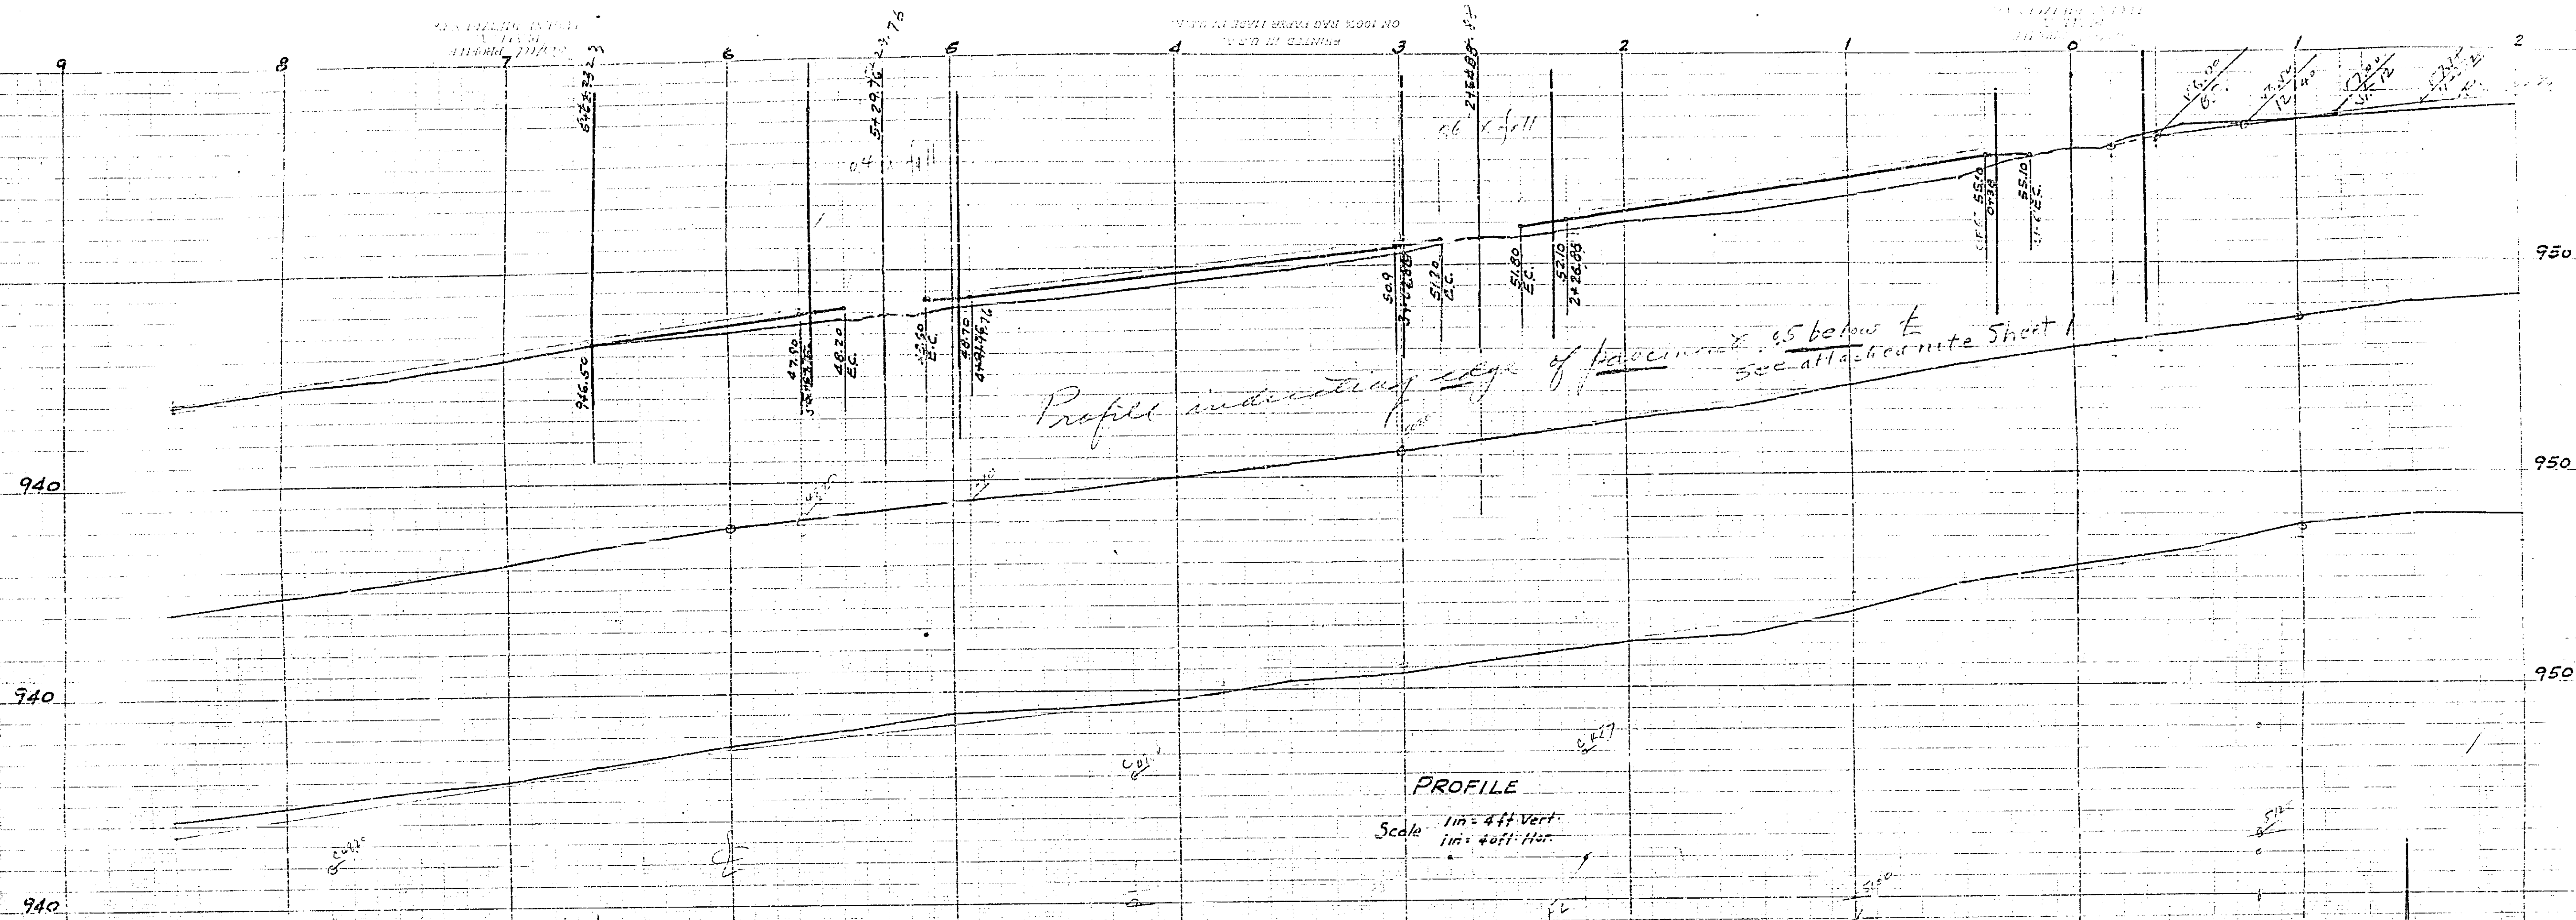

PROFILE  
Scale: 1 in = 4 ft Vert.  
1 in = 40 ft Hor.

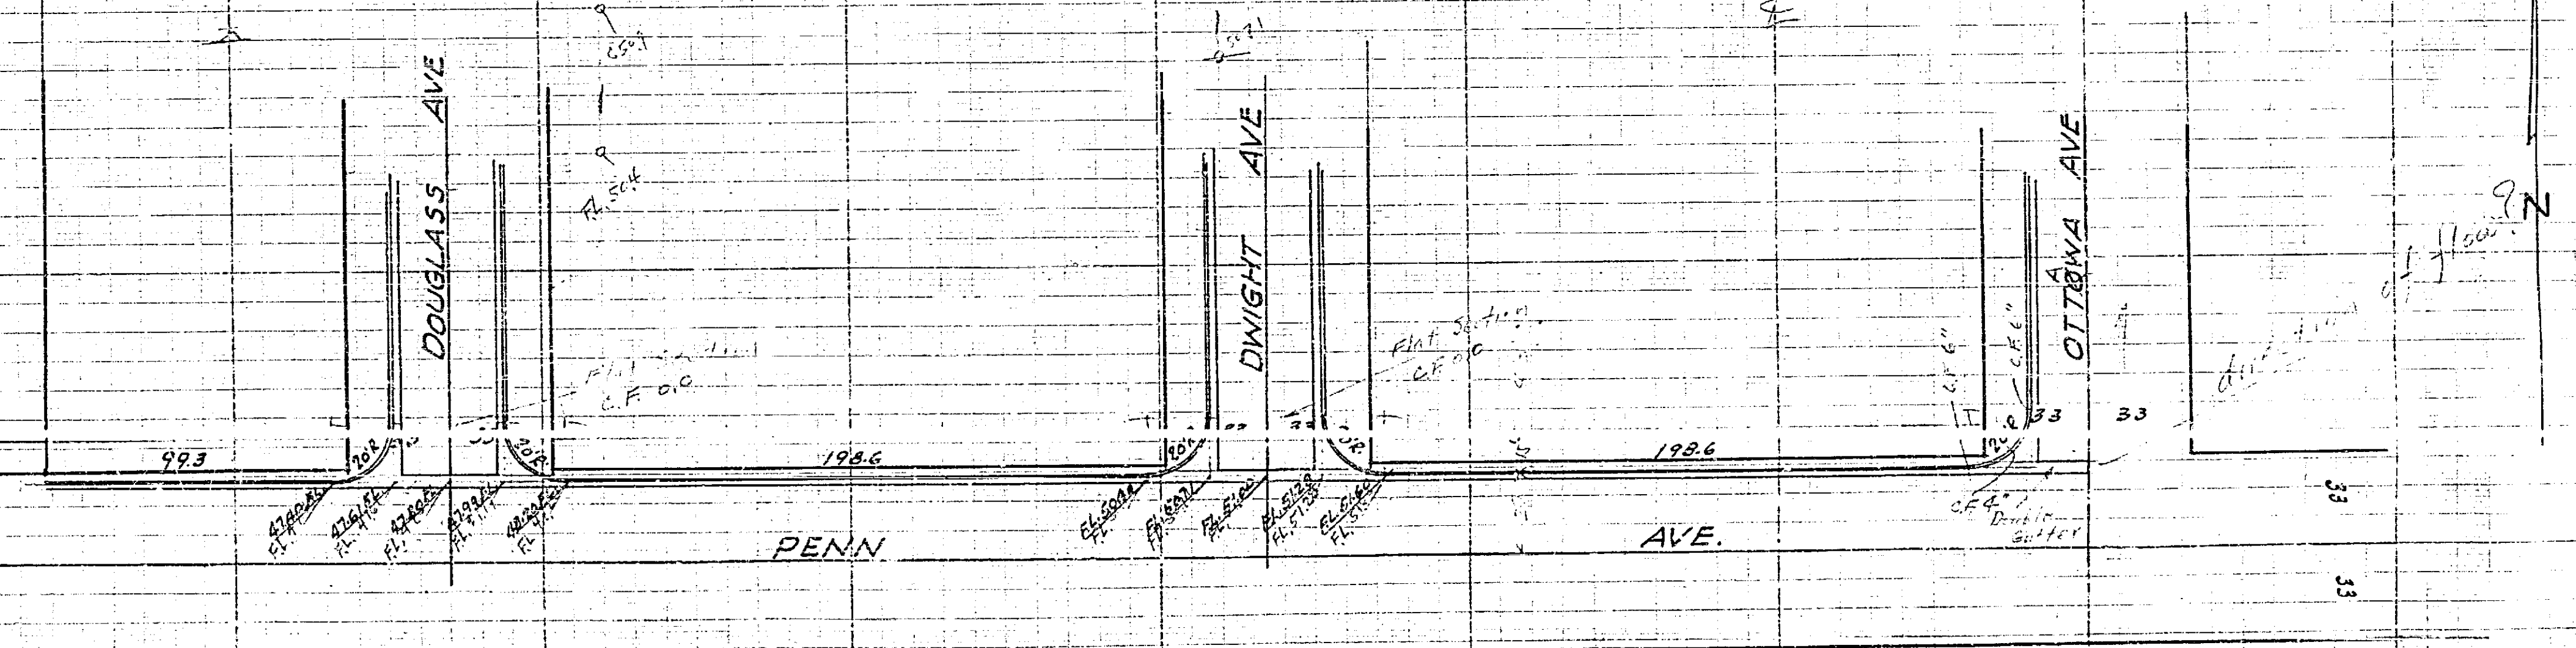

PLAN  
Scale: 1 in = 40 ft.

UNIVERSITY &  
MONTGOMERY TRACT  
Curb, Gutter & Pavement  
PLANS AND PROFILES  
Mar. 1950 Scale 1 in = 40 ft  
Moody St. shown in Sheet 3 of Sewer  
Approved 1950 W. M. Swanson  
City Engineer  
Drawn by D.J.M. Sheet 3 of 3 Sheets.

577A