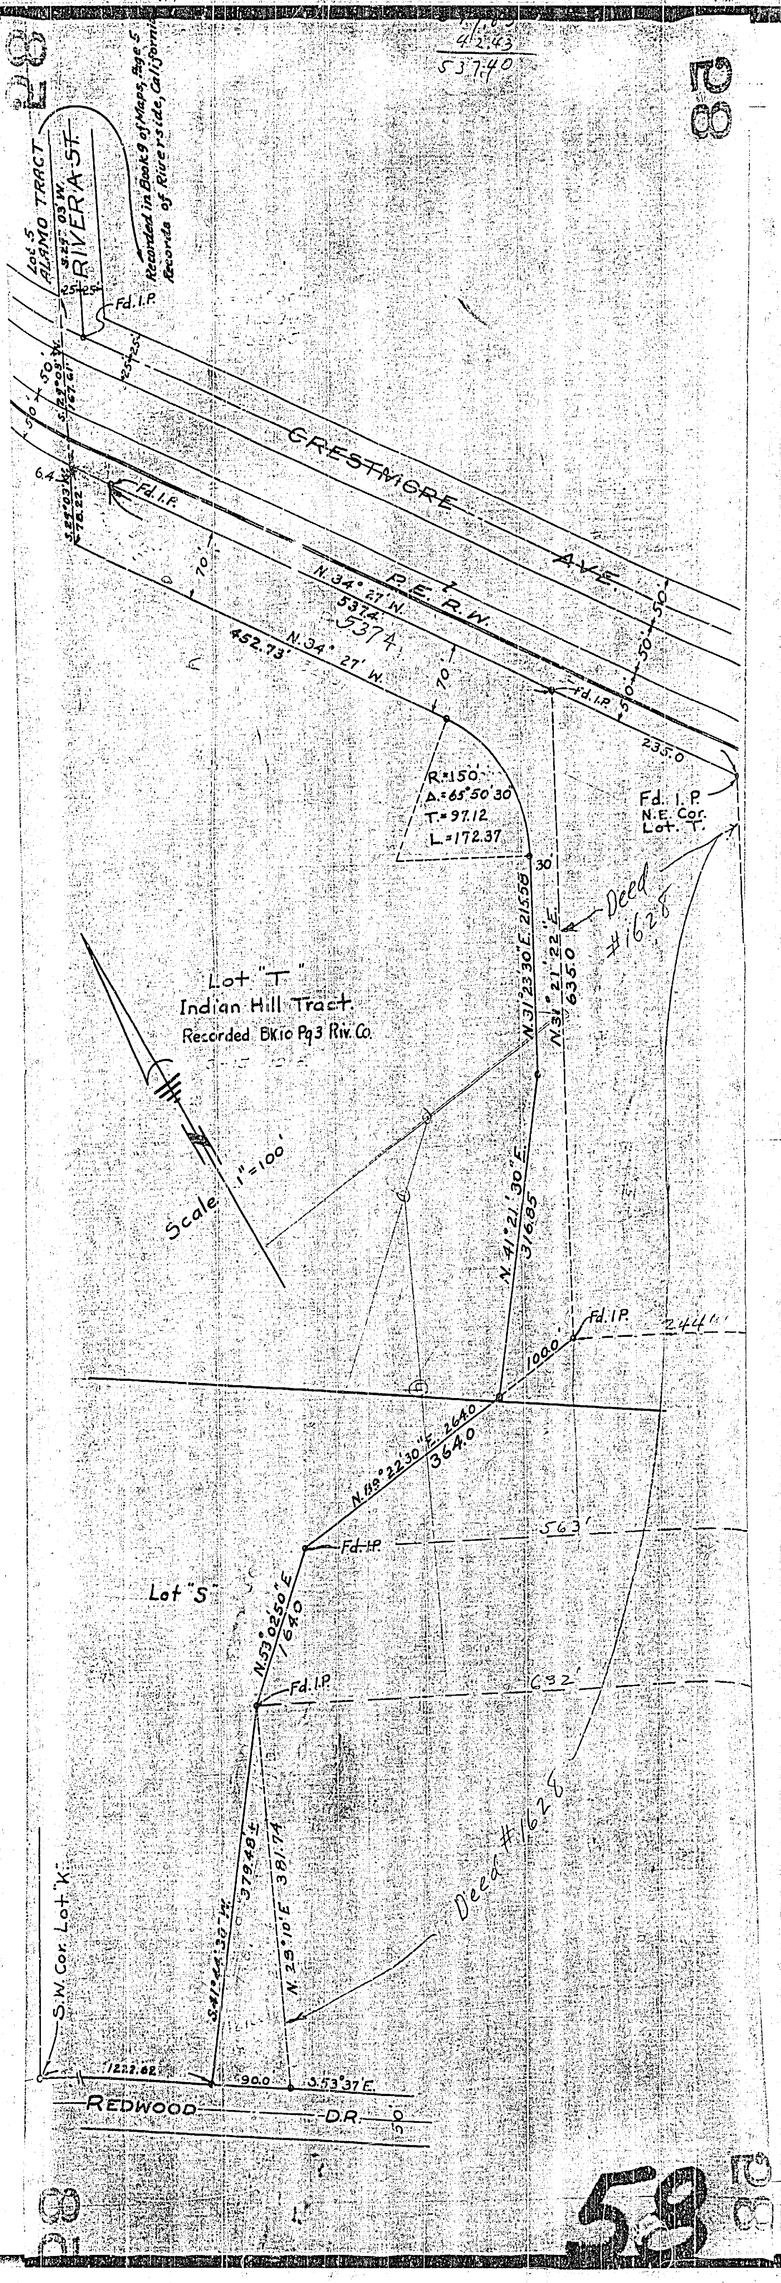

Lot 5 ALAMO TRACT
RIVERA ST.
Recorded in Book 9 of Maps, Page 5 Records of Riverside, California
Fd. I.P.
CRESTMORE AVE.
P.E.R.W.
N. 34° 27' W.
5374
452.73'
R.=150'
Δ.=65°50'30
T.=97.12
L.=172.37
235.0
Fd. I.P. N.E. Cor. Lot. T.
Deed #1628
Lot "T"
Indian Hill Tract
Recorded Bk.10 Pg3 Riv. Co.
Scale 1"=100'
N. 31°23'30"E. 215.58
N. 31°21'22"E. 635.0
N. 41°21'30"E. 316.85
100.0
244'
N. 88°22'30"E. 264.0
364.0
563'
Lot "S"
N. 53°02'50"E. 164.0
632'
S. 41°44'30"W. 379.48±
N. 29°10'E. 381.74
S.W. Cor. Lot "K"
1222.62
90.0
S. 53°37'E.
REDWOOD D.R.