


PLAN AND PROFILE  
 No 580A  
 SHOWING  
 SANITARY SEWER  
 ON  
 MAIN STREET  
 BETWEEN  
 SANTA ANA ST AND STRONG ST  
 IN THE  
 CITY OF RIVERSIDE  
 CALIFORNIA

Approved: *M. H. Jarvis*  
 CITY ENGINEER  
 Registered Civil Engineer  
 No 3011


NOT CONSTRUCTED

Scale  
 Hor. 1" = 100'  
 Ver. 1" = 5'

U.S.G.S. Datum  
 F.B. 416-53  
 December 1948

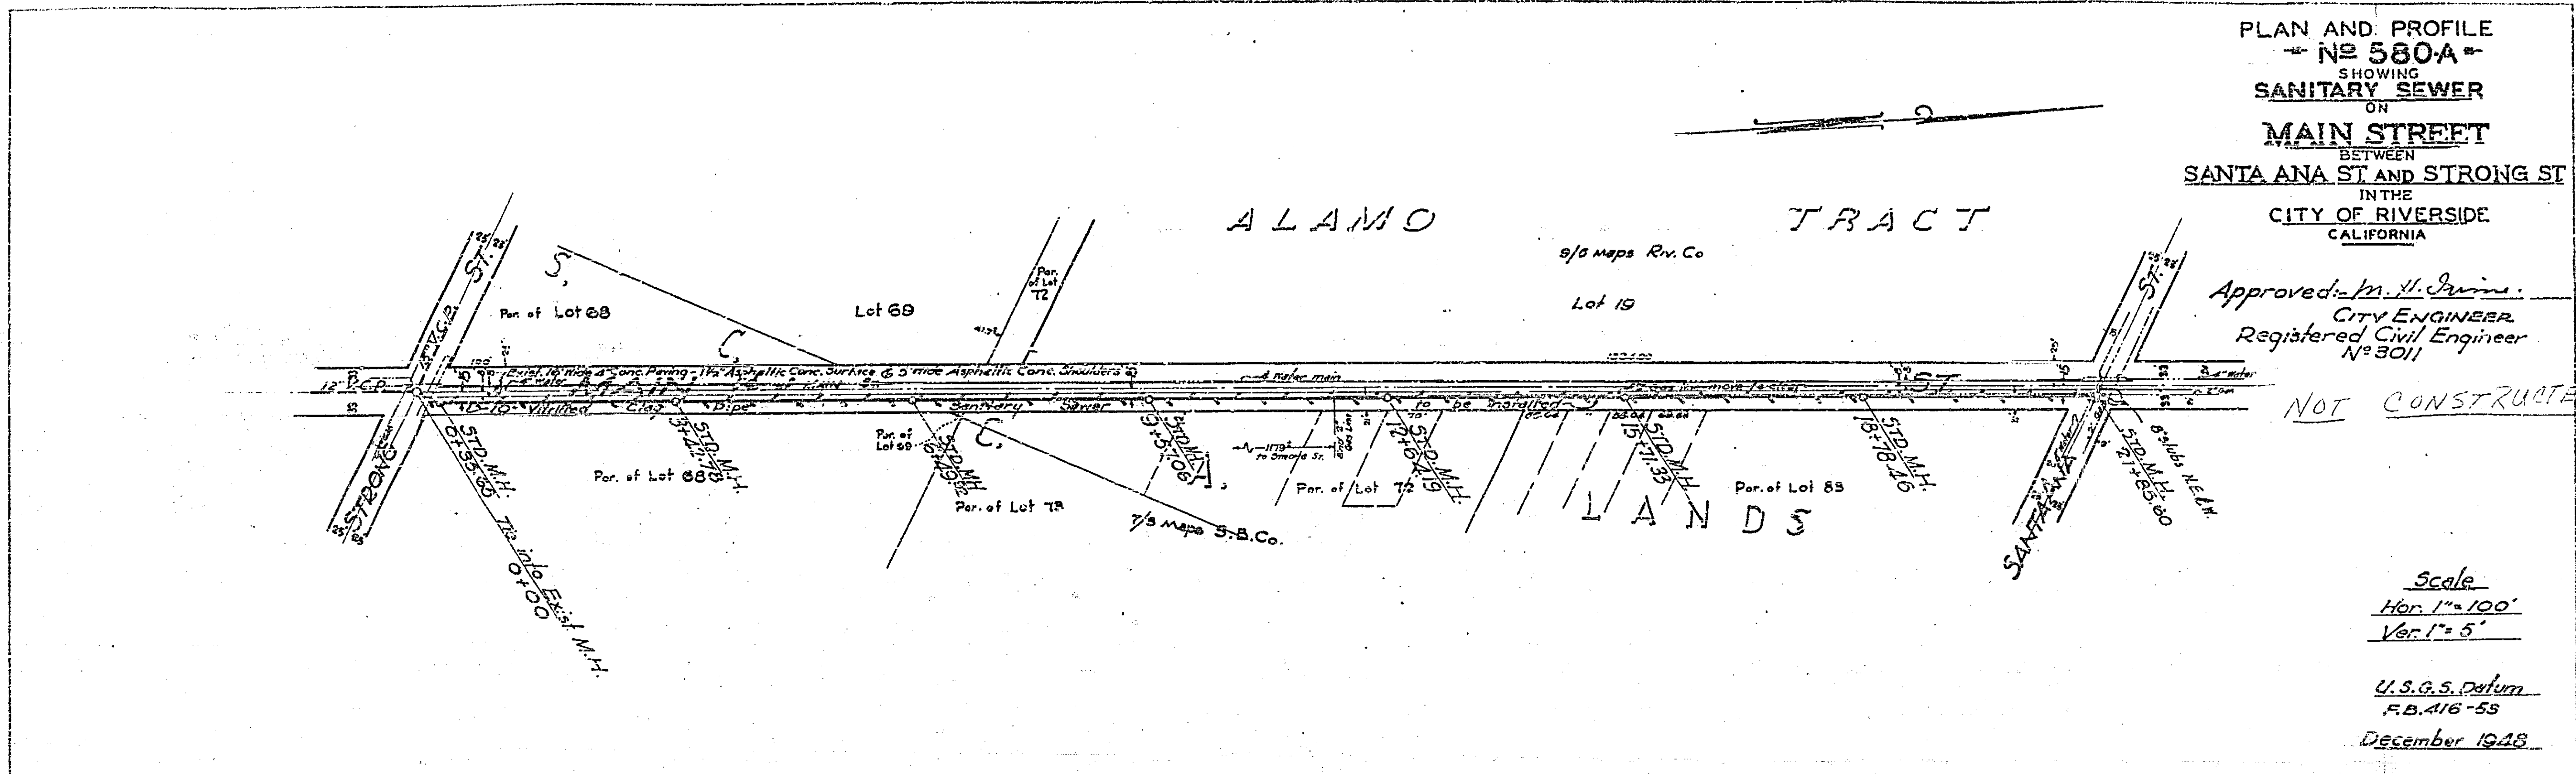

BENCH MARK Spike & Lead in  
 W. curb of MAIN ST.  
 5'-S. of S. E. of STRONG  
 ST. ELEV. = 806.639

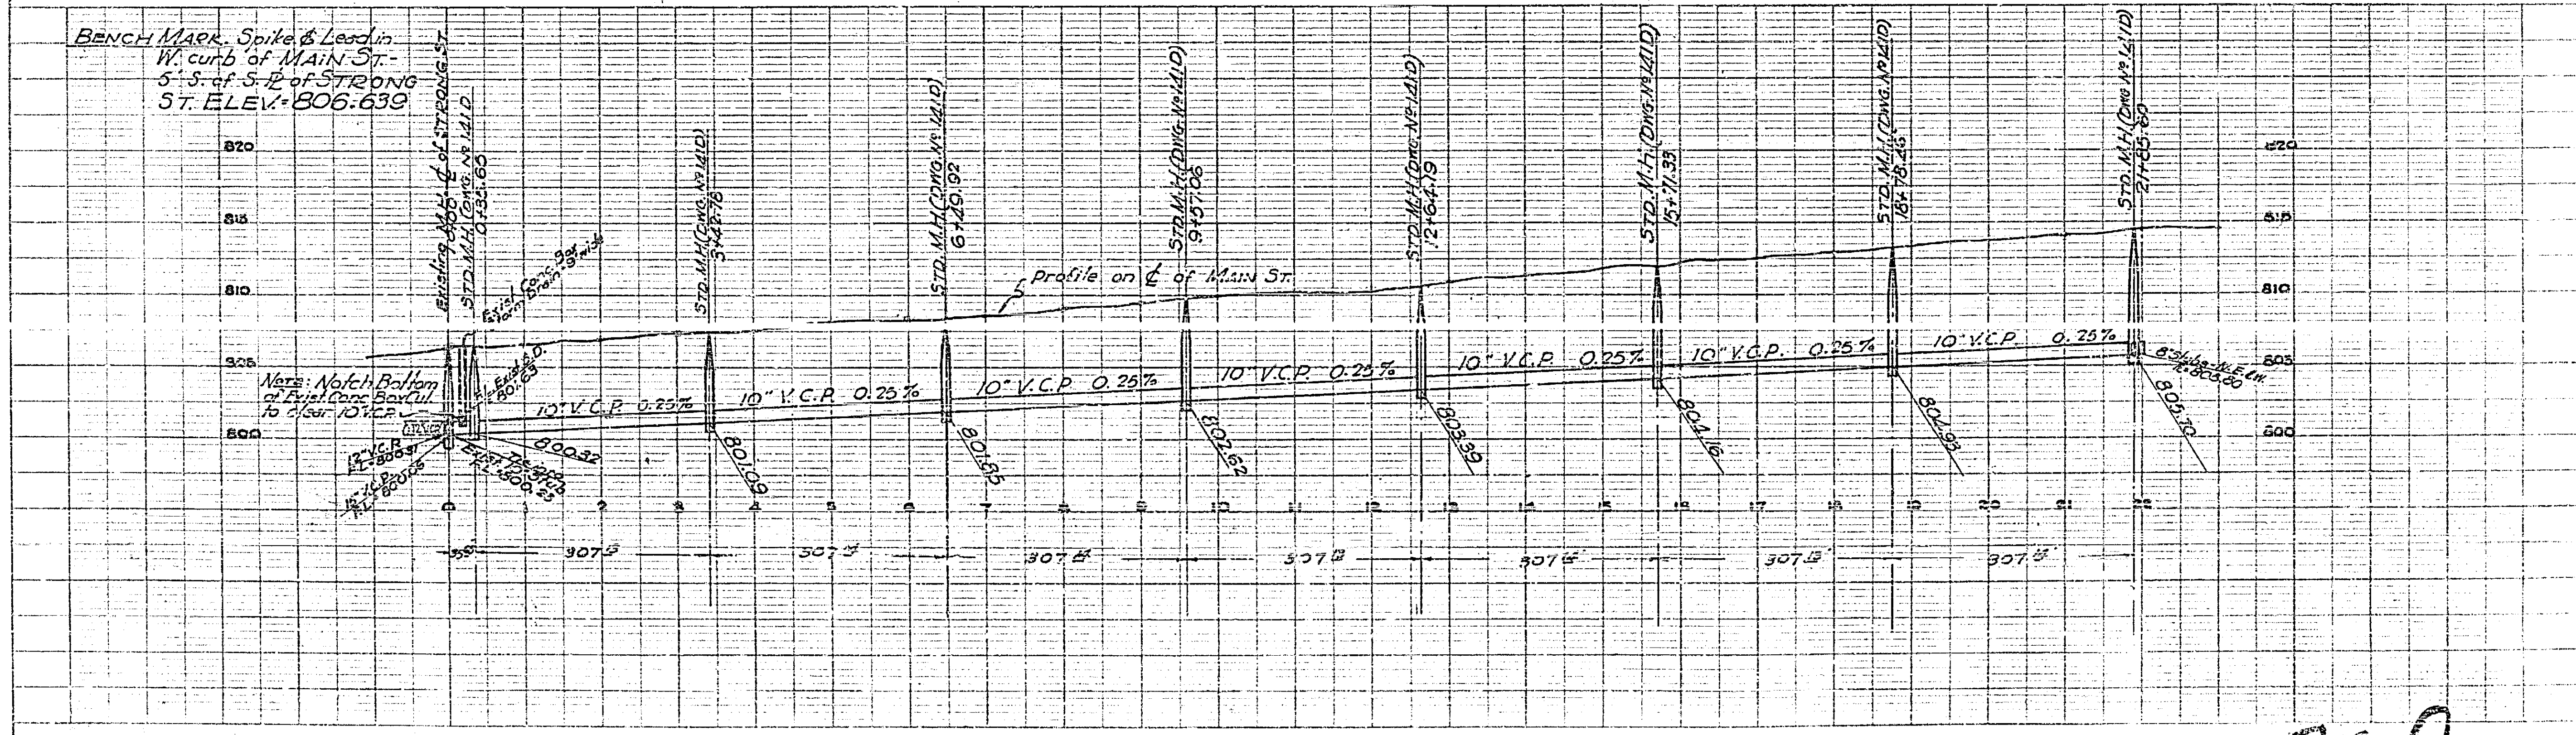

580A

PLAN	DATE	BY
NOTED		
REVISION		
NO.		

PROFILE	DATE	BY
NOTED		
REVISION		
NO.		