
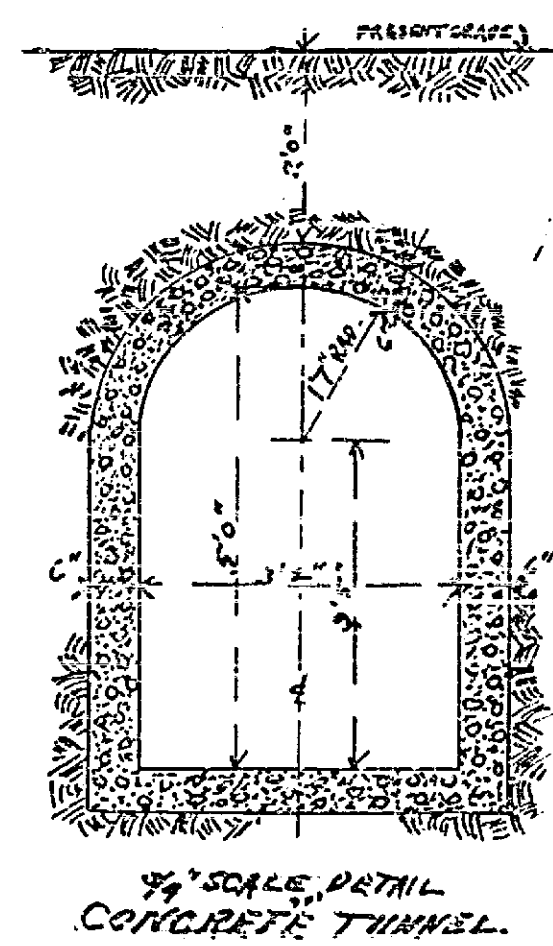
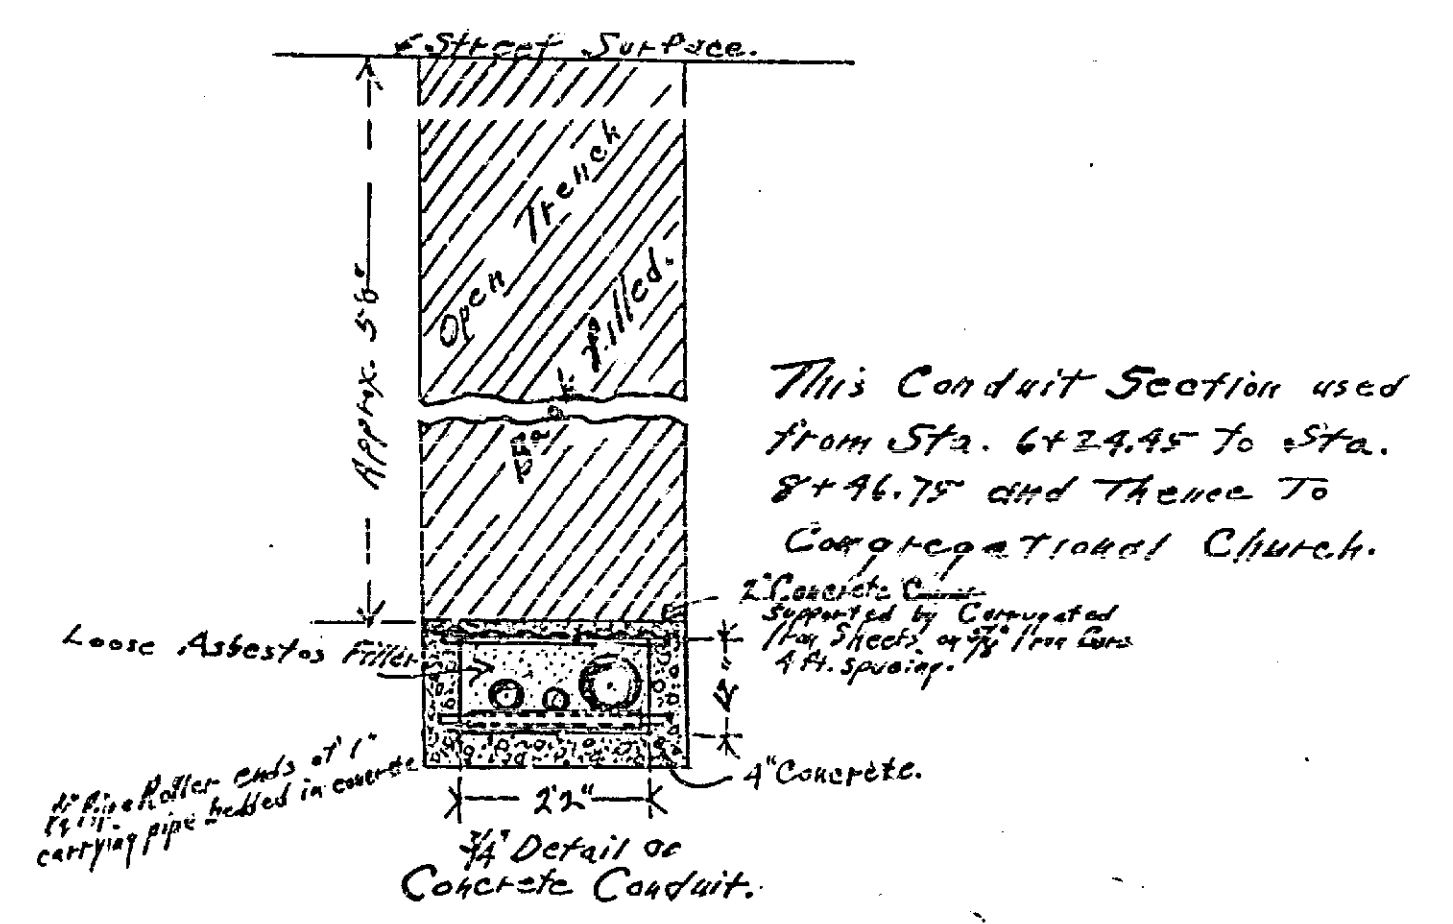


**Construction Plan**  
 Showing  
**Concrete Tunnel and Conduit**  
 Glenwood Mission Inn to First Congregational Church.

SCALE 1/8" = 1'  
 (Survey Notes in Feet and Tenths)

**Steam Pipes in Above Structures.**

- Sizes (b) and (d) only, Connect with Post Office and Victoria Block. (Sept 22, 1914 by R.R.K.)

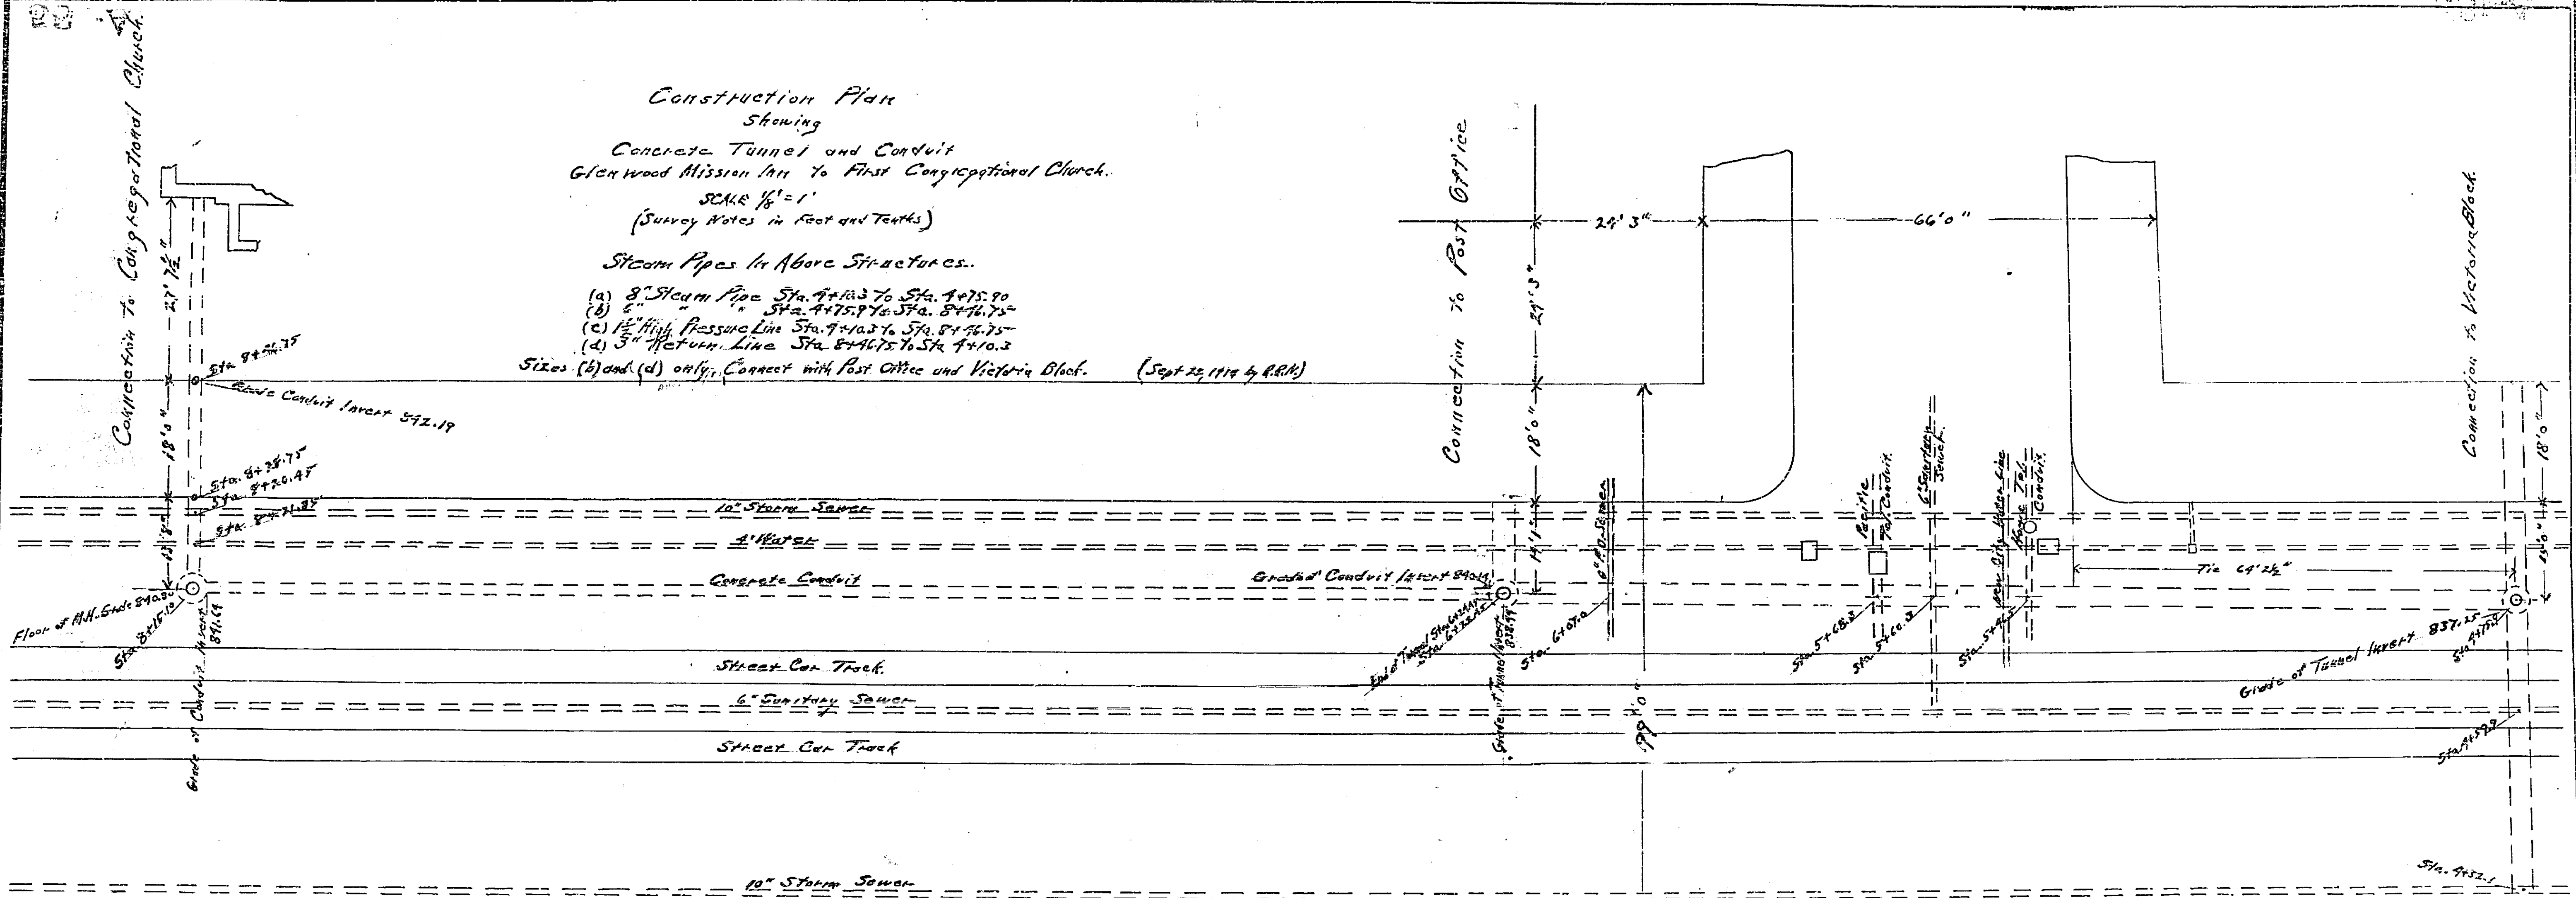

This Tunnel Section used from Sta. 7+10.3 to Sta. 6+24.45 including connections to Post Office and Victoria Block as shown.

DRAWN BY

Glenwood Mission Inn.  
 581 A