Constructed

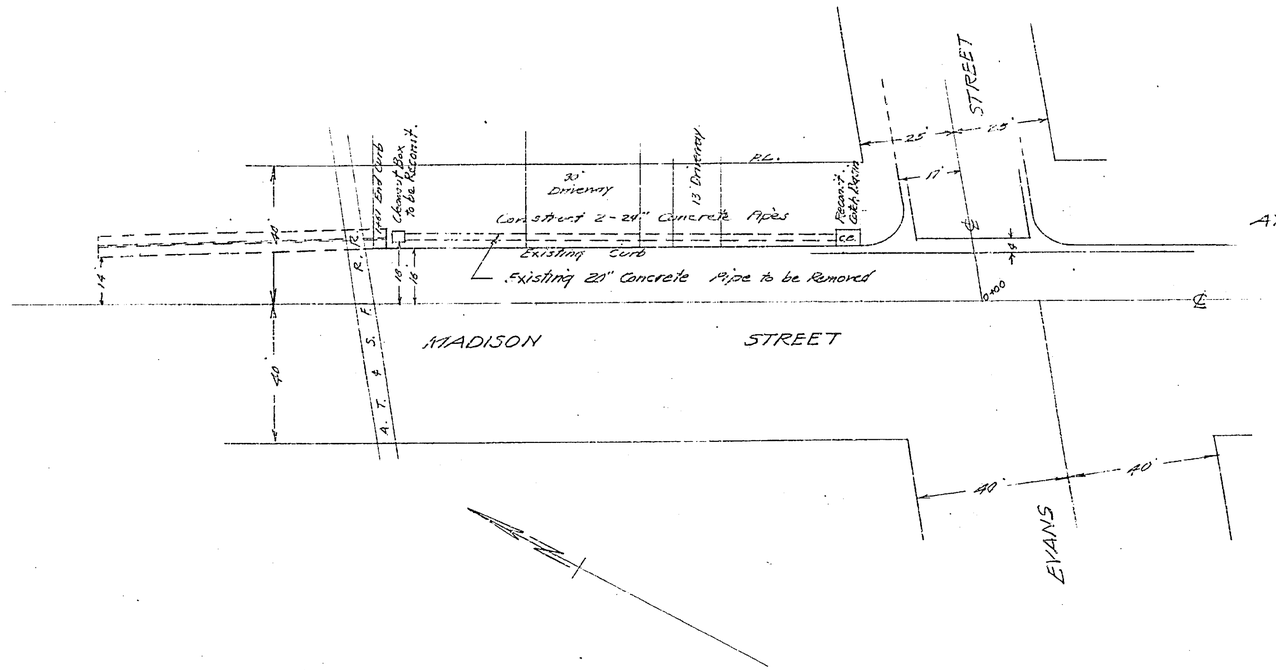

PLAN No

SHOWING PROPOSED

ADDITIONAL DRAIN

AT MADISON & EVANS STREETS

CITY OF RIVERSIDE

F.B. 511-66 FEB. 1952

SCALES: HOR. 1 IN. = 20 FT.
VERT. 1 IN. = 4 FT.

APPROVED _____
M.M. IRVINE
CITY ENGINEER

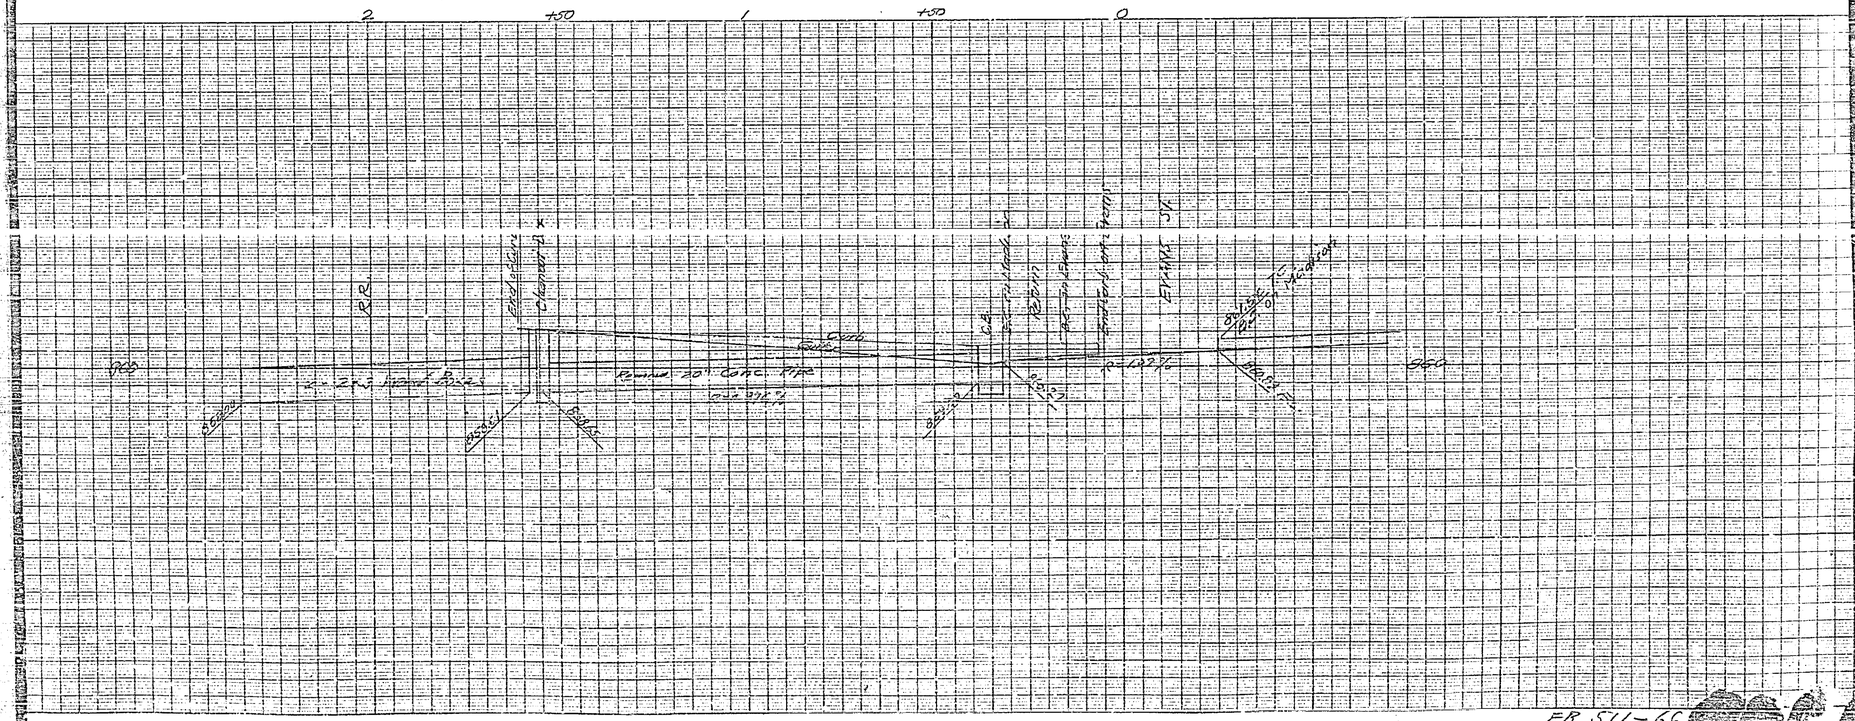
2 +50 1 +50 0
RR
Curb
Gutter
Curb
Gutter
