

CORTEZ ST

0

1

2

3

4

5


6

7


8

9

MADISON

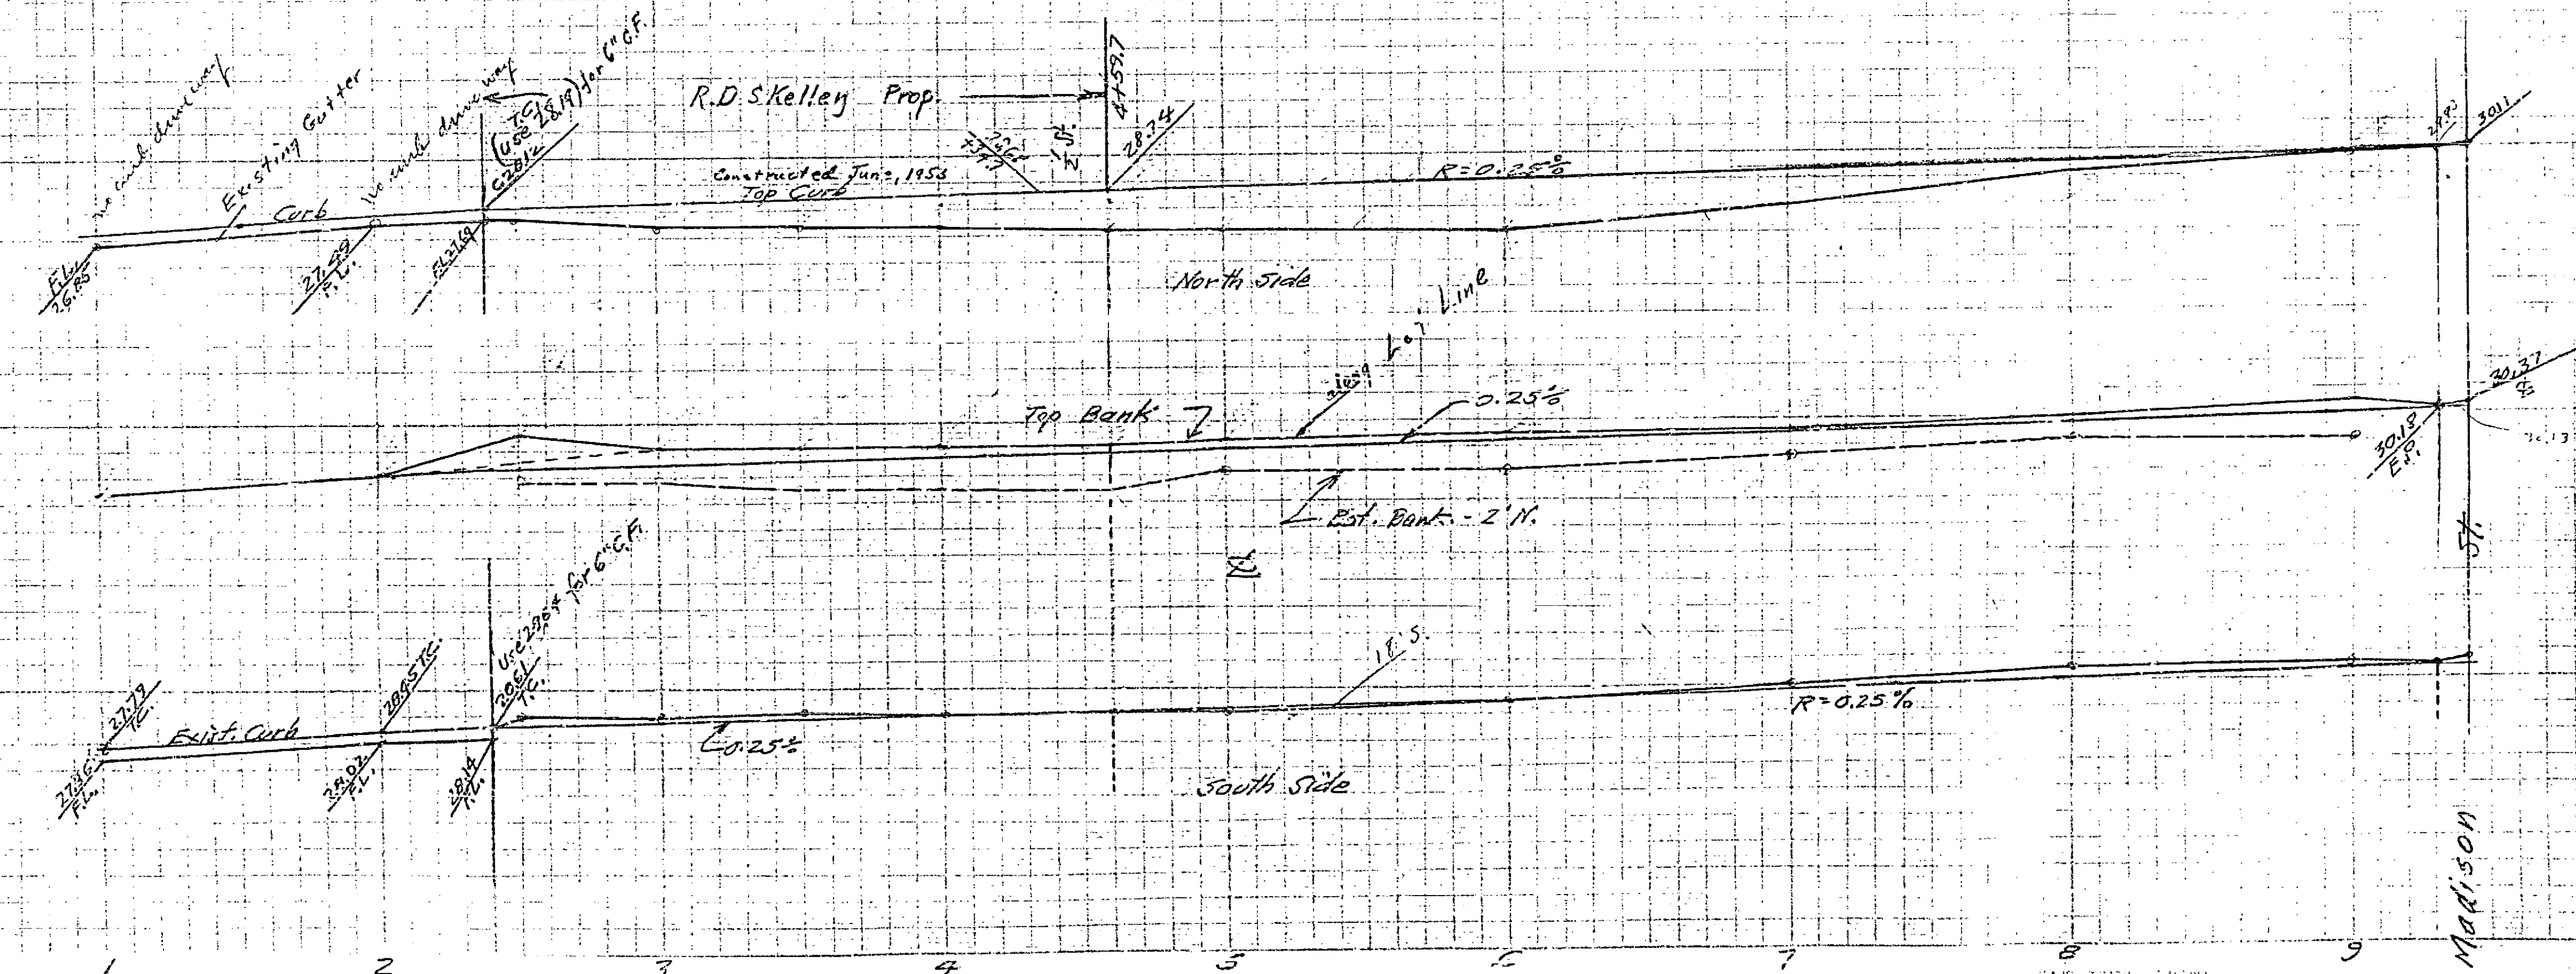

No 608-B  
 ORCHARD ST. EXTENSION  
 F.B. 533-64  
 Hor. 1" = 40'  
 Vert. 1" = 4'

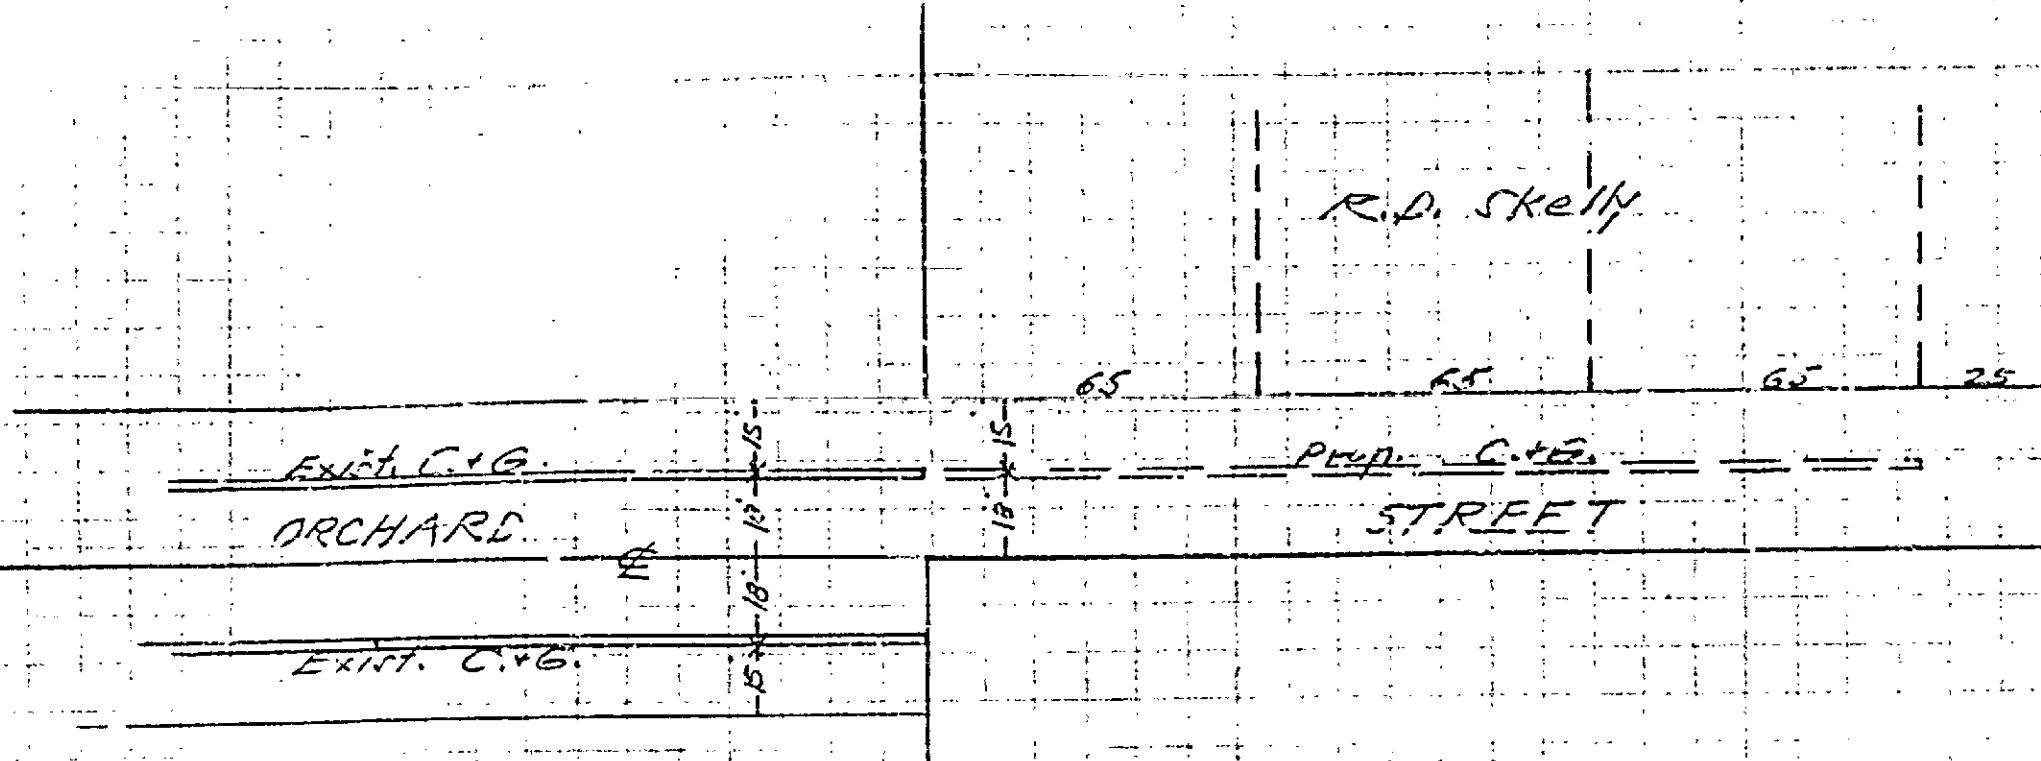

MADISON STREET

608-B