


EDGEWOOD PLACE			
Drawing No.	Sheet No.	Total Sheets	Field Book
#16	1	307	307
Plotted	1	Checked	
3-8-36 CSM		Appr. by	3/11/36

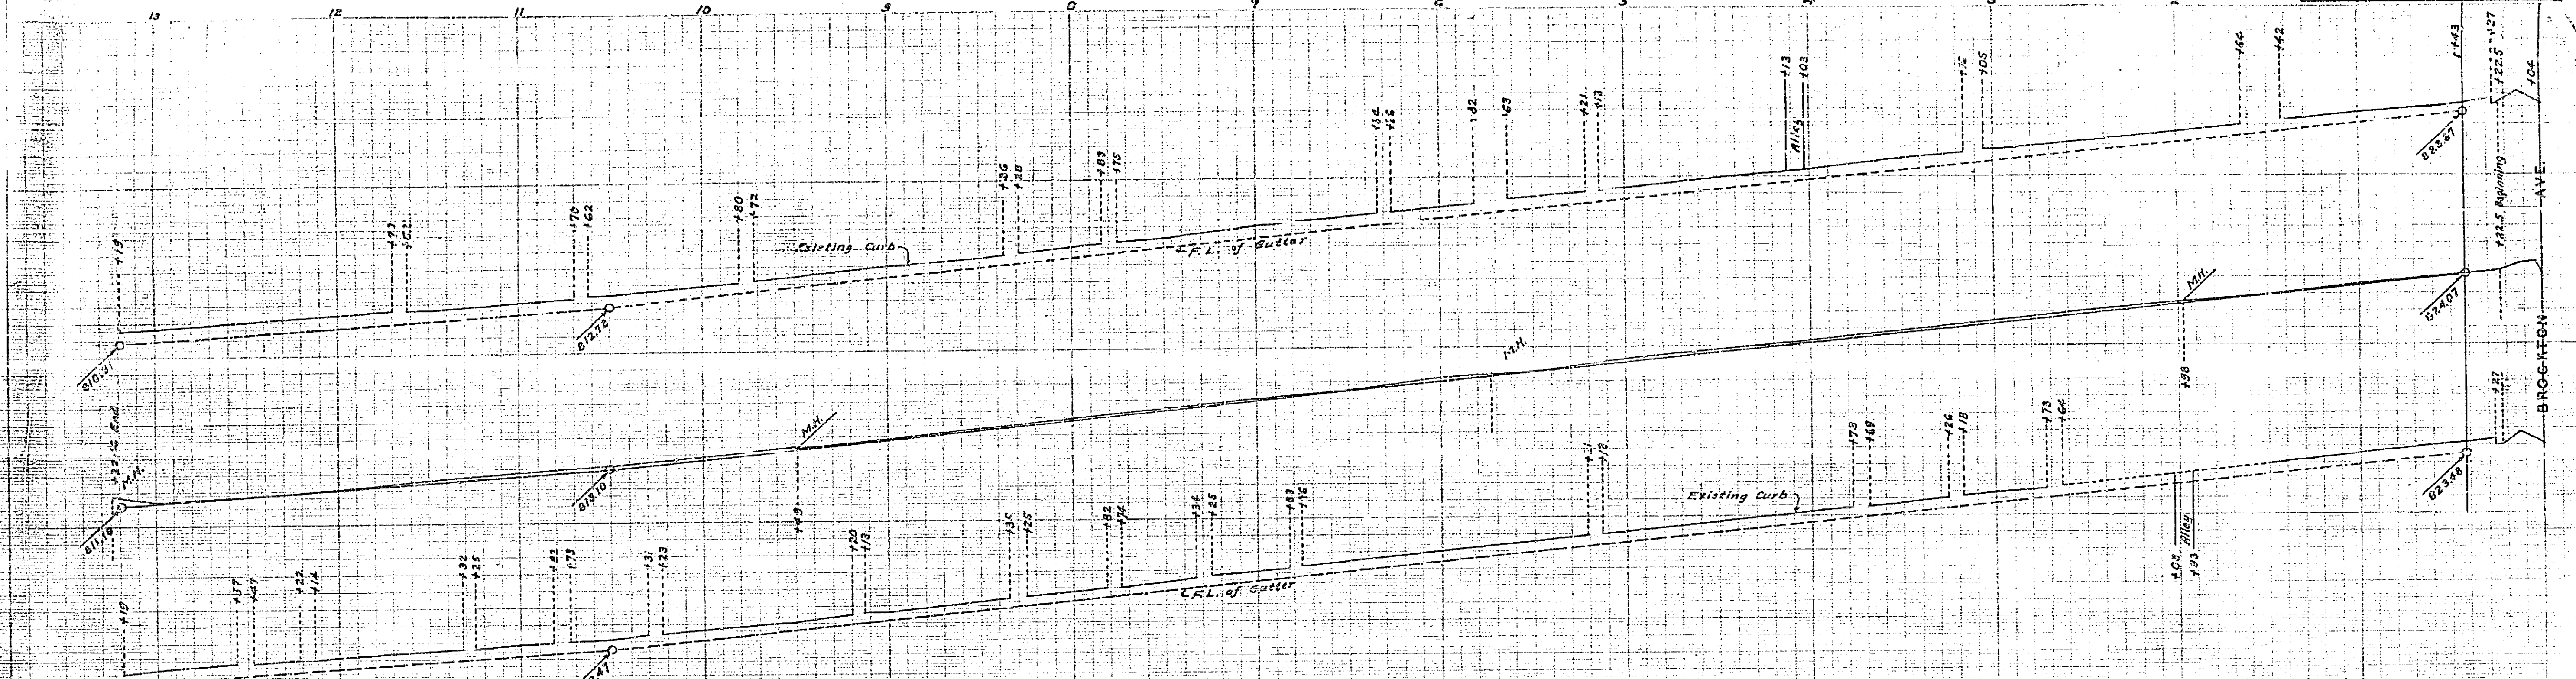


PLAN AND PROFILE OF THE PROPOSED IMPROVEMENT ON EDGEWOOD PLACE BETWEEN BROCKTON AVE. & PALM AVE.

ENGINEER DEPT. RIVERSIDE CALIF. 1936.
CITY (U.S.G.S.) DATUM PLANE
FIELD BOOK 307 PAGES 32-48

SCALE HOR. 1"=40' Constructed by Street Dept. 1936 W.P.A. Labor

APPROVED *[Signature]*
CITY ENGINEER.

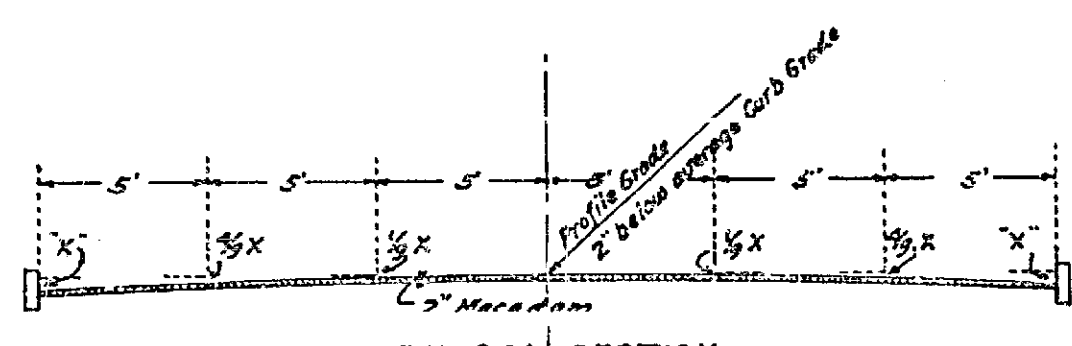

TYPICAL SECTION
Scale: 1"=5'
X = Difference in elevation of G and
F.L. of Gutter, at right angles to G

APPROVED AND ADOPTED BY THE MAYOR
AND COUNCIL OF THE CITY OF RIVERSIDE
THIS 10TH DAY OF MARCH 1936.

[Signature]
CITY CLERK, CITY OF RIVERSIDE.

615