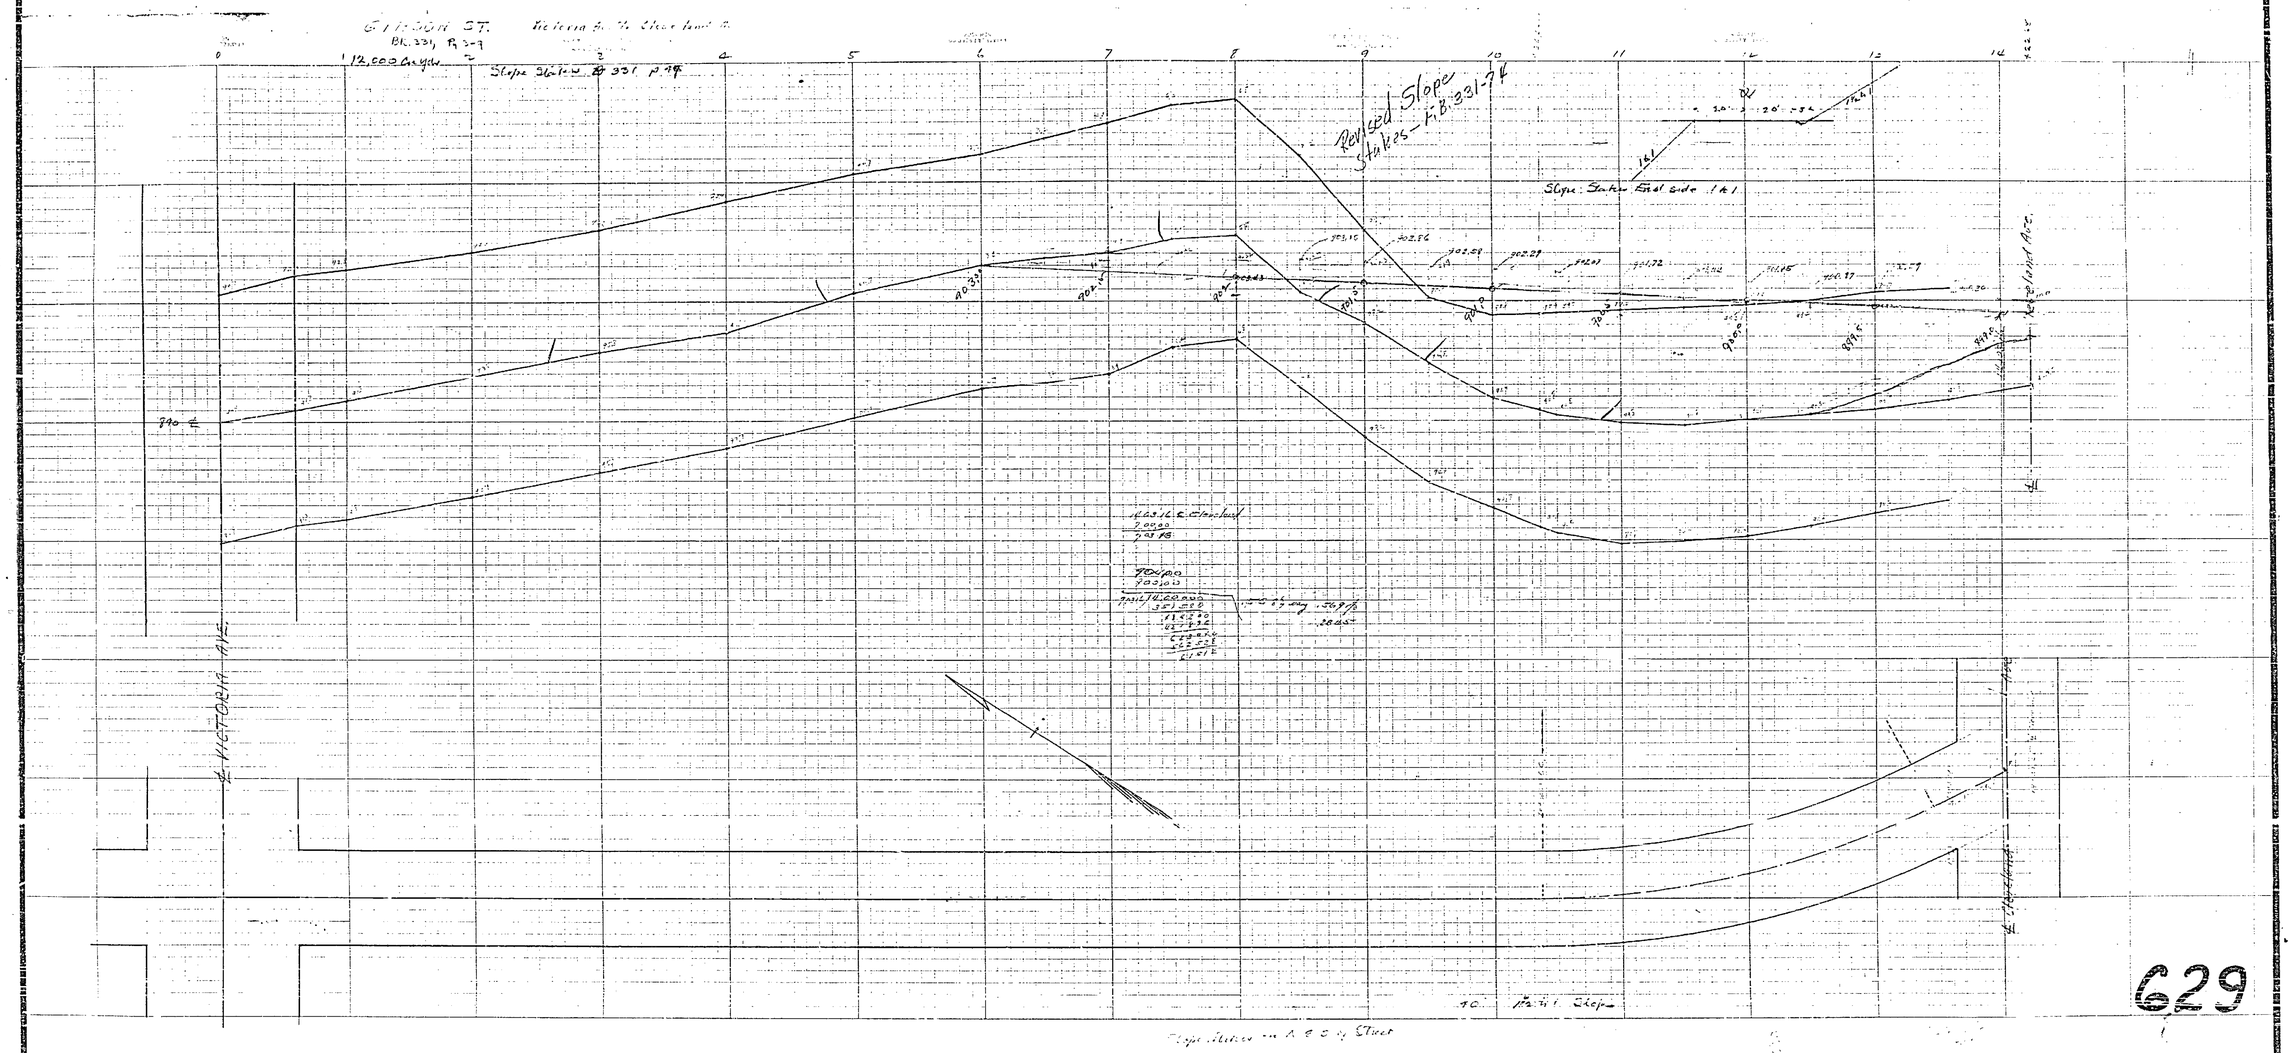

Revised Slope Stakes - F.B. 331-74
Slope: Stakes End side 1 to 1
12,000 Cu yds
Slope Stakes B 331 p 79
Victoria Ave.
Kerchland Ave.


629