


PLAN	DATE
REVISED	
NOTED	
NOTE BOOK	
NO. 1	
NO. 2	
PROFILE	DATE
REVISED	
NOTED	
NOTE BOOK	
NO. 1	
NO. 2	
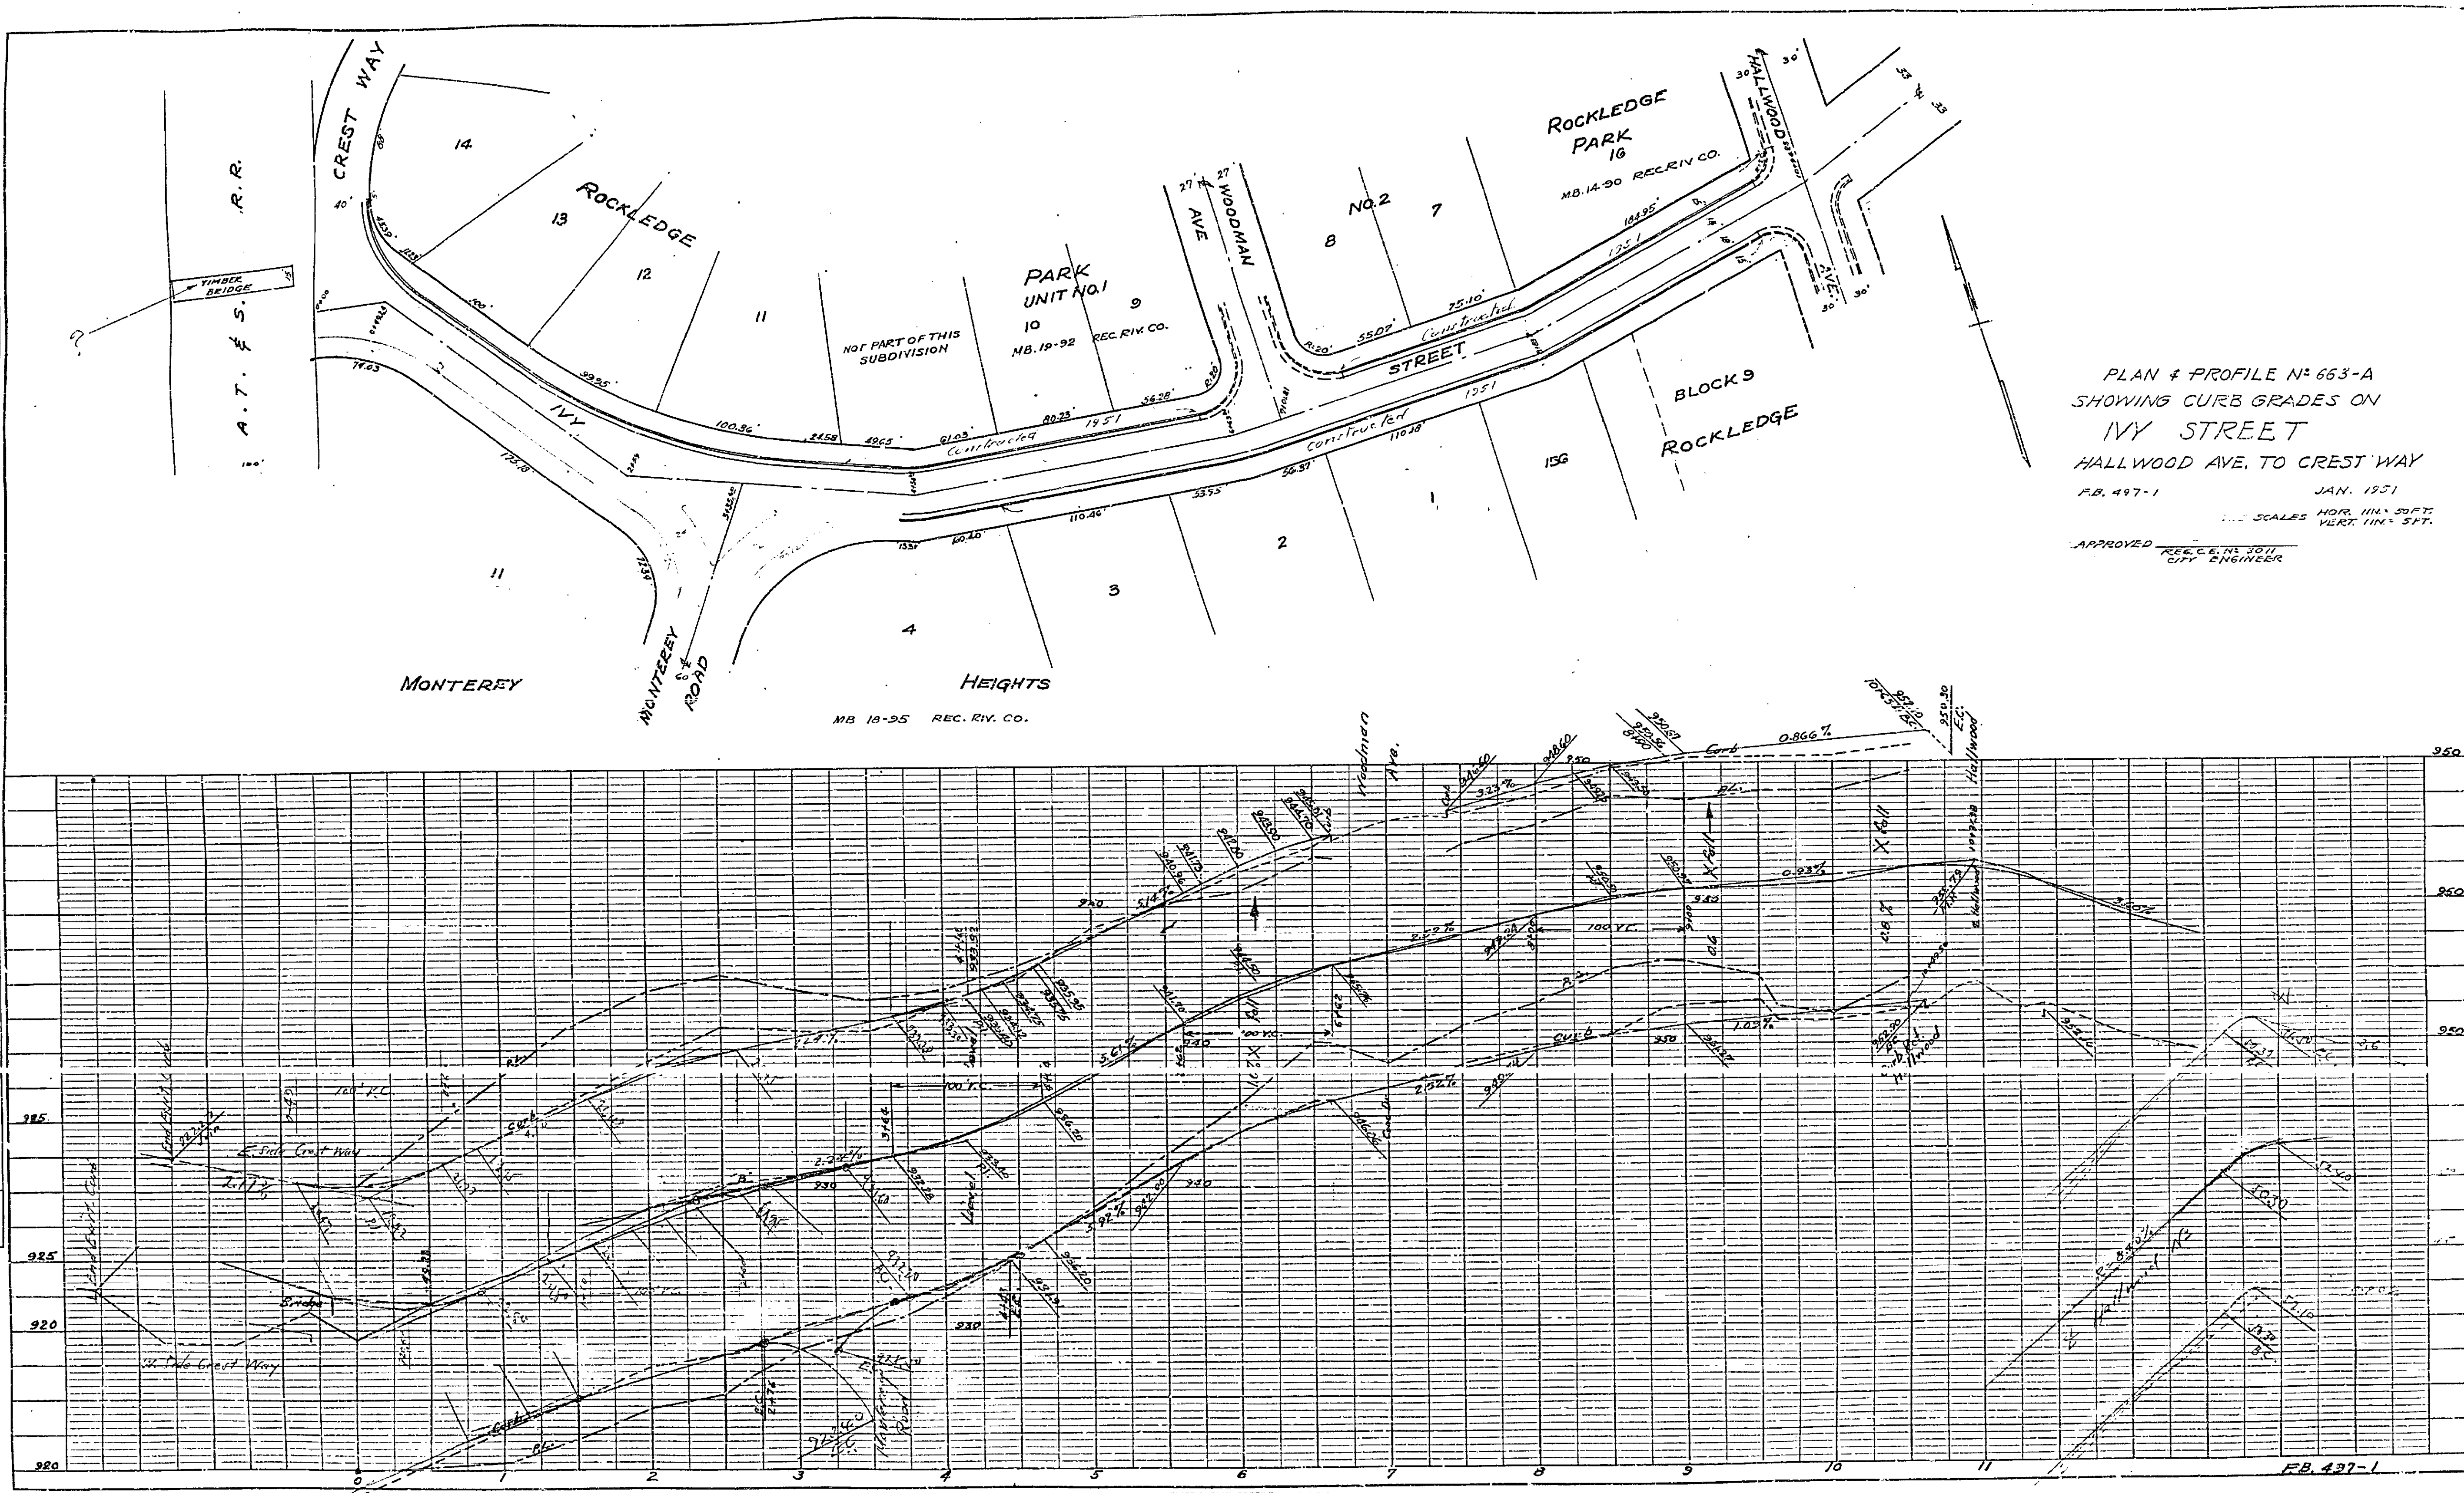

PLAN & PROFILE N° 663-A
 SHOWING CURB GRADES ON
 IVY STREET
 HALLWOOD AVE. TO CREST WAY
 F.B. 497-1
 VERT. SCALE 1" = 5 FT.
 APPROVED _____
 CITY ENGINEER

PLATE 1 - PLAN - PROFILE OF P. R. & R. E.
 CLEARPRINT PAPER COMPANY, S. F. CA.
 No. 10091-1

663-A