



Jackson

Lincoln Ave

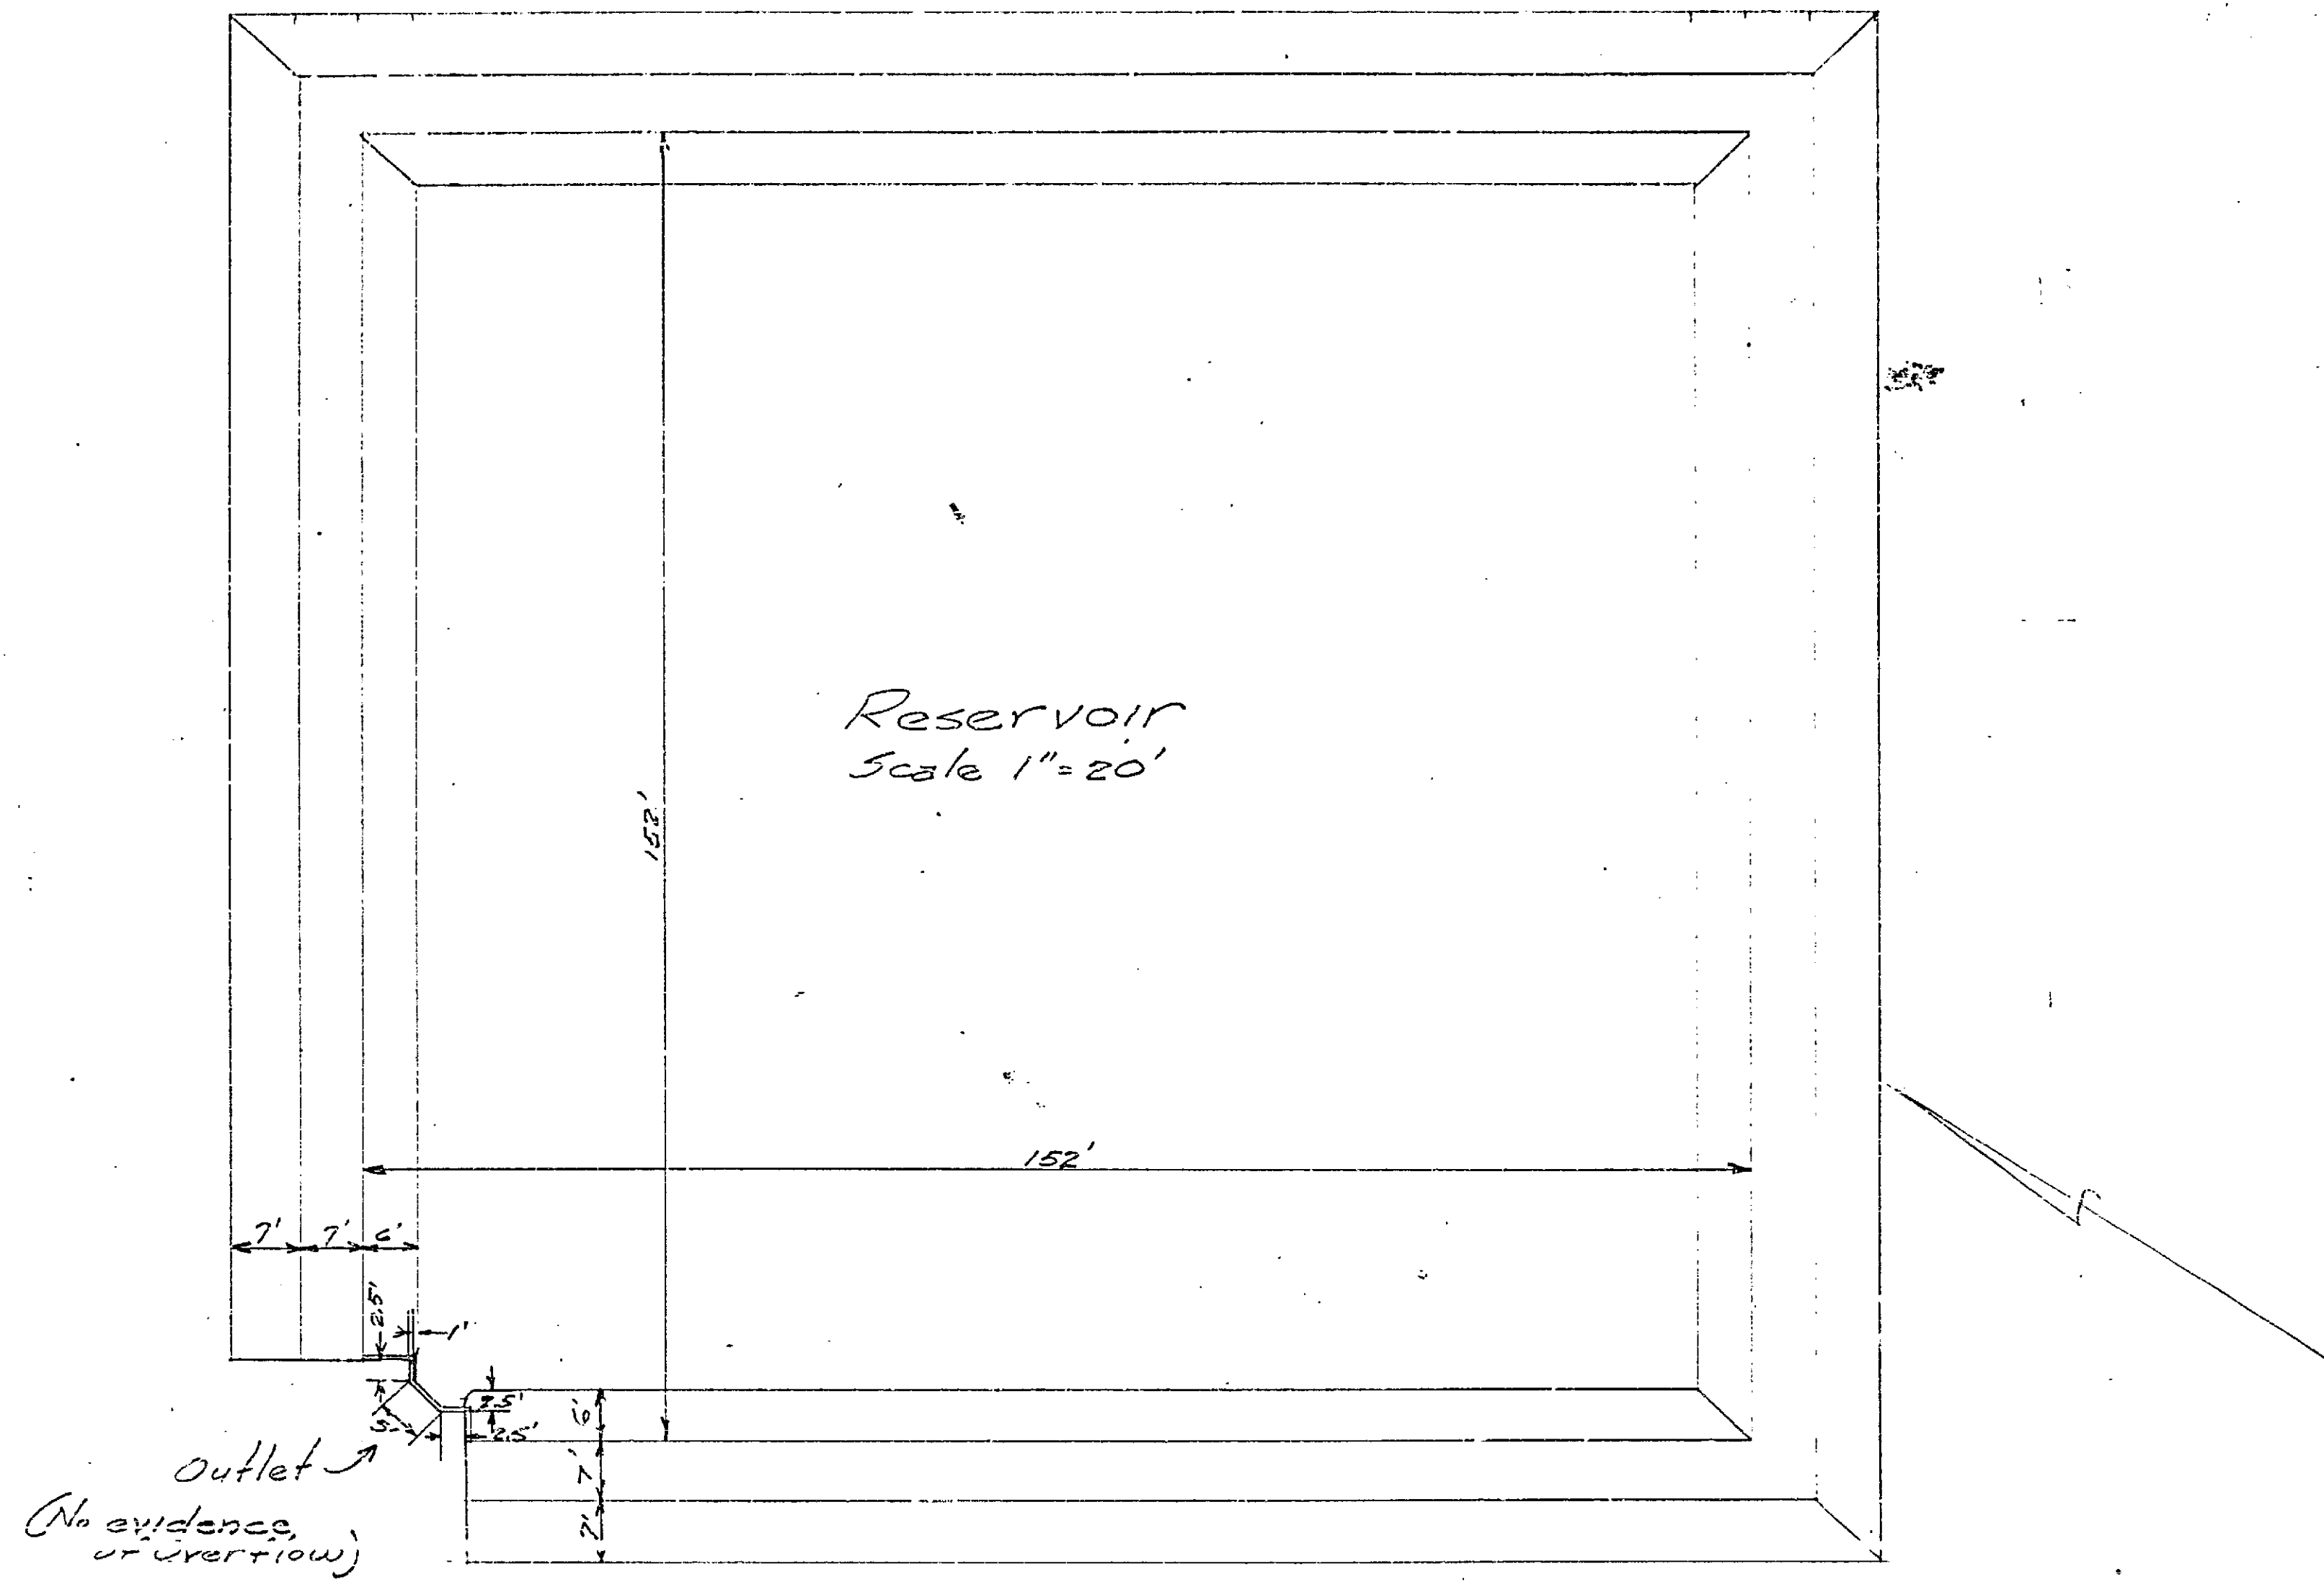

Reservoir Cap. = 709,000 gal.

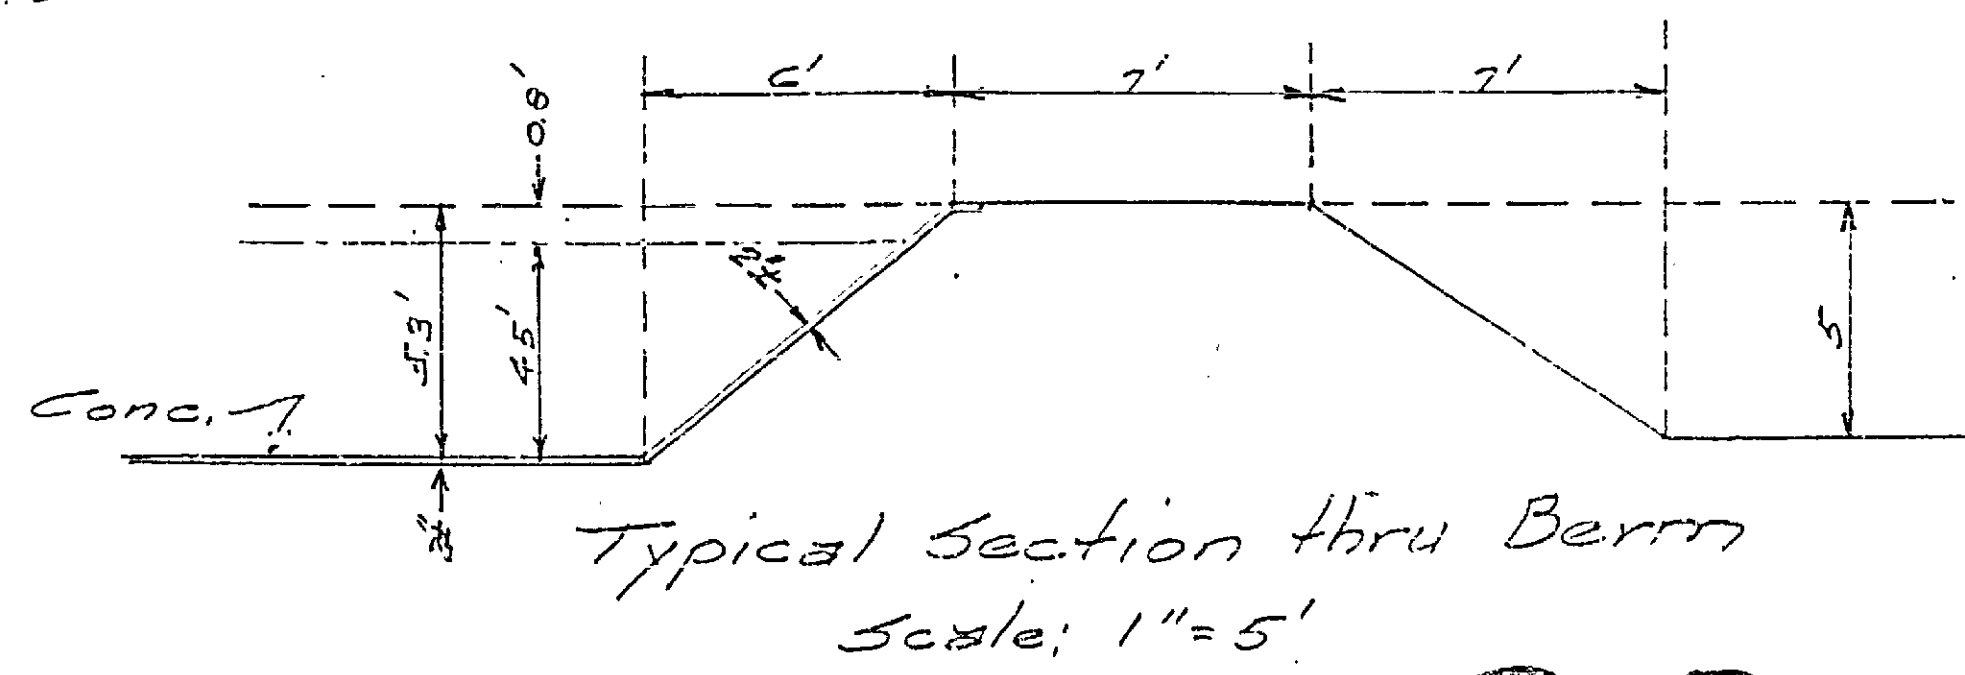

638