


MADE IN U.S.A.
DIERICH-POST
TRAFFIC LIGHTS



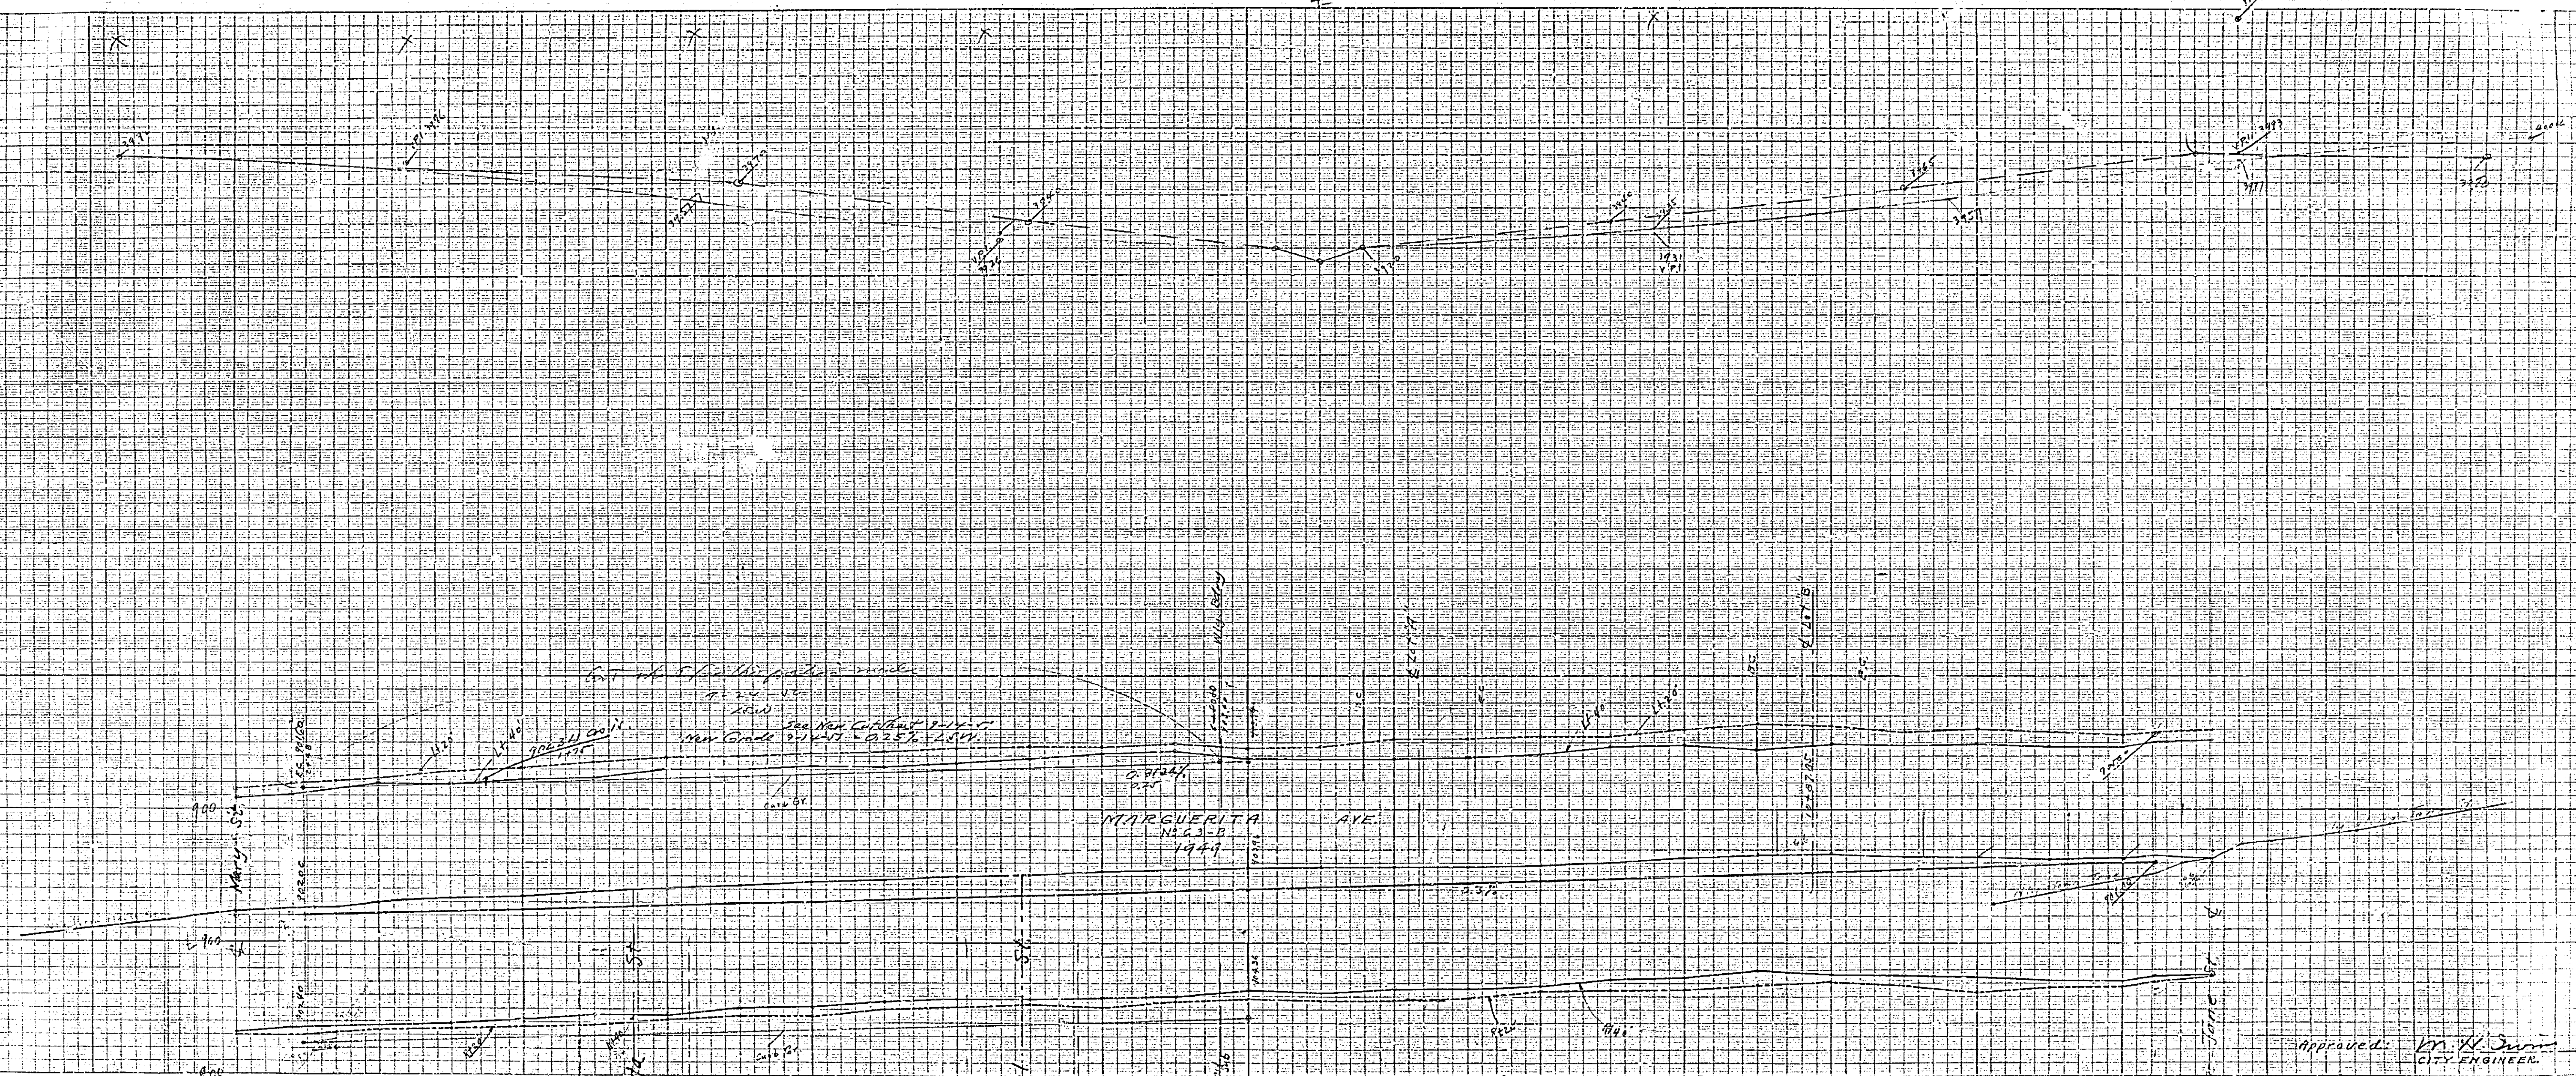

Levels 459/51-54
Tops 457/62-69

Beattie St
Curb stakes 453/32-34

Mignel St

1300
1200
1100
1000

1300
1200
1100
1000

63-B