Alley South of 11th St E'ly from Howard Ave
F.B. 5440, P. 26

Scale:
Vert. 1"=4'
Hor. 1"=40'

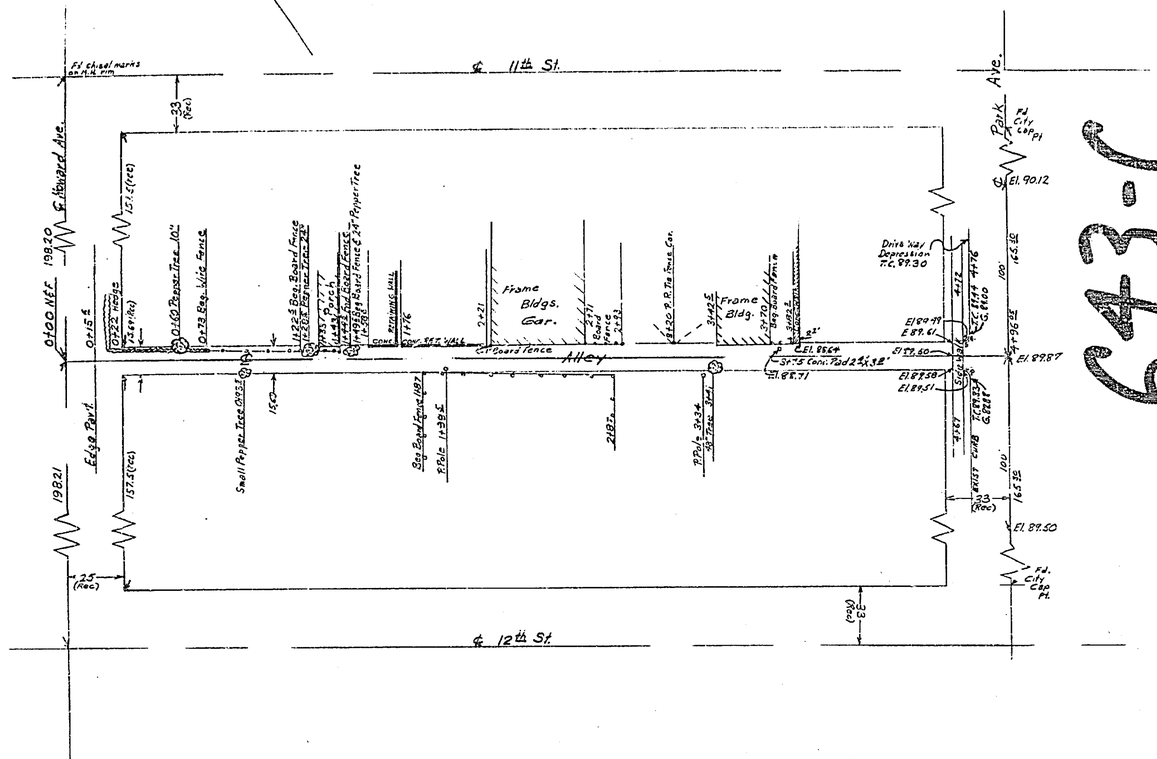

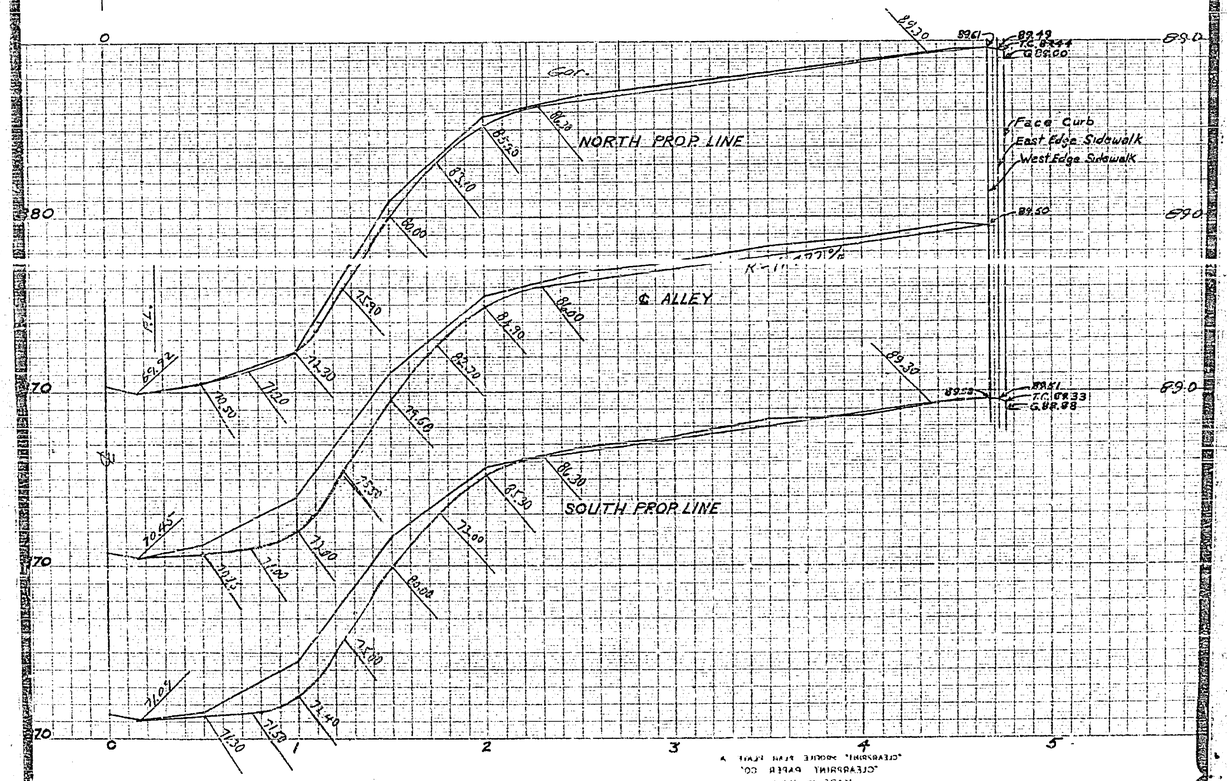

"CLEARPRINT" PRINTED FROM FILM
"CLEARPRINT" PAPER CO.
MADE IN U.S.A.

43-7