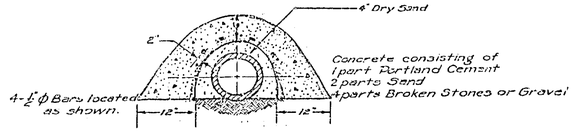

CROSS SECTION
OF
PIPE ENCASEMENT
Scale 1"=1'

A PORTION OF N.W.¼, N.E.¼, SEC. 24, T. 2S., R. 5W

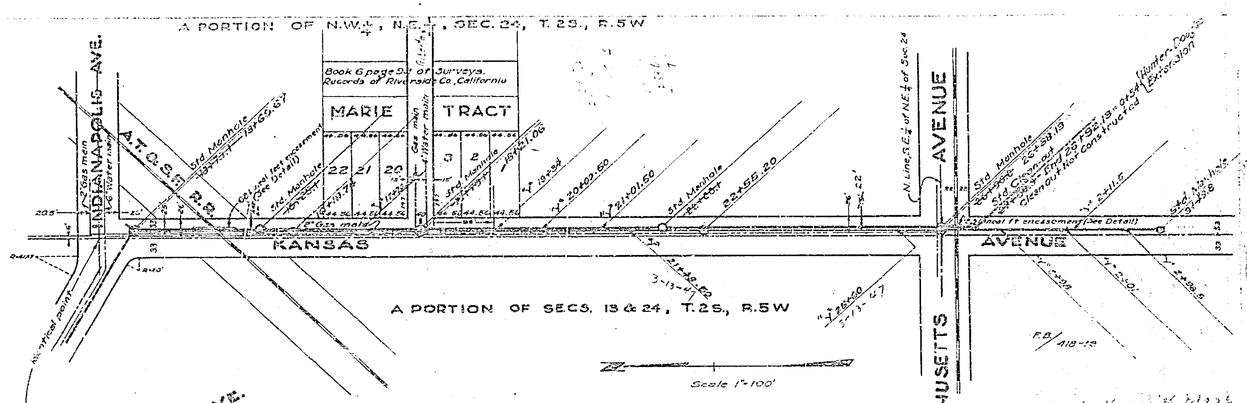

A PORTION OF SECS. 13 & 24, T. 2S., R. 5W

Scale 1"=100'

0+00 MH. Kansas & Mass
+38 " W
2+01 " E
2+11.5 " W
2+98.5 " W
3+49.8 MH. for Hunter Douglas Mfg.
10" Line
10" x 24" "

LEGEND

- Existing Vitrified Clay Pipe Sewer
- Vitrified Clay Pipe Sewer to be constructed
- Existing Manhole (Exist M.H.)
- Standard Manhole (M.H.) to be constructed
- " Clean-out (C.O.) to be constructed
- Vitrified Clay Pipe Wye Branch

Red line shows change as constructed FB/419/31

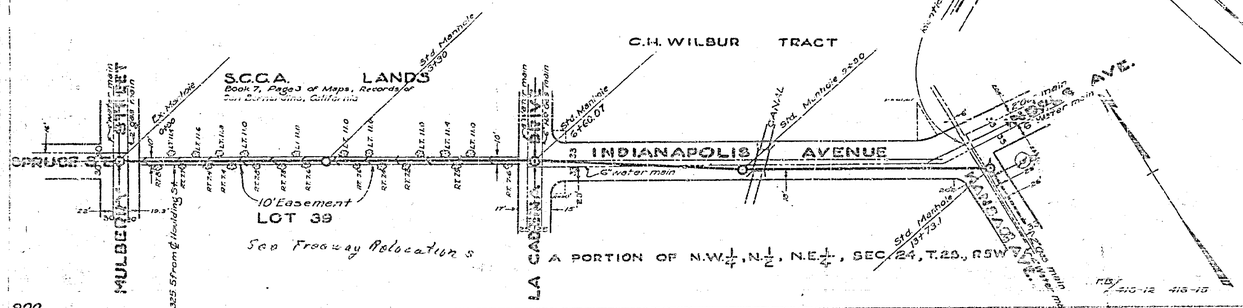

A PORTION OF N.W.¼, N.½, N.E.¼, SEC. 24, T. 2S., R. 5W

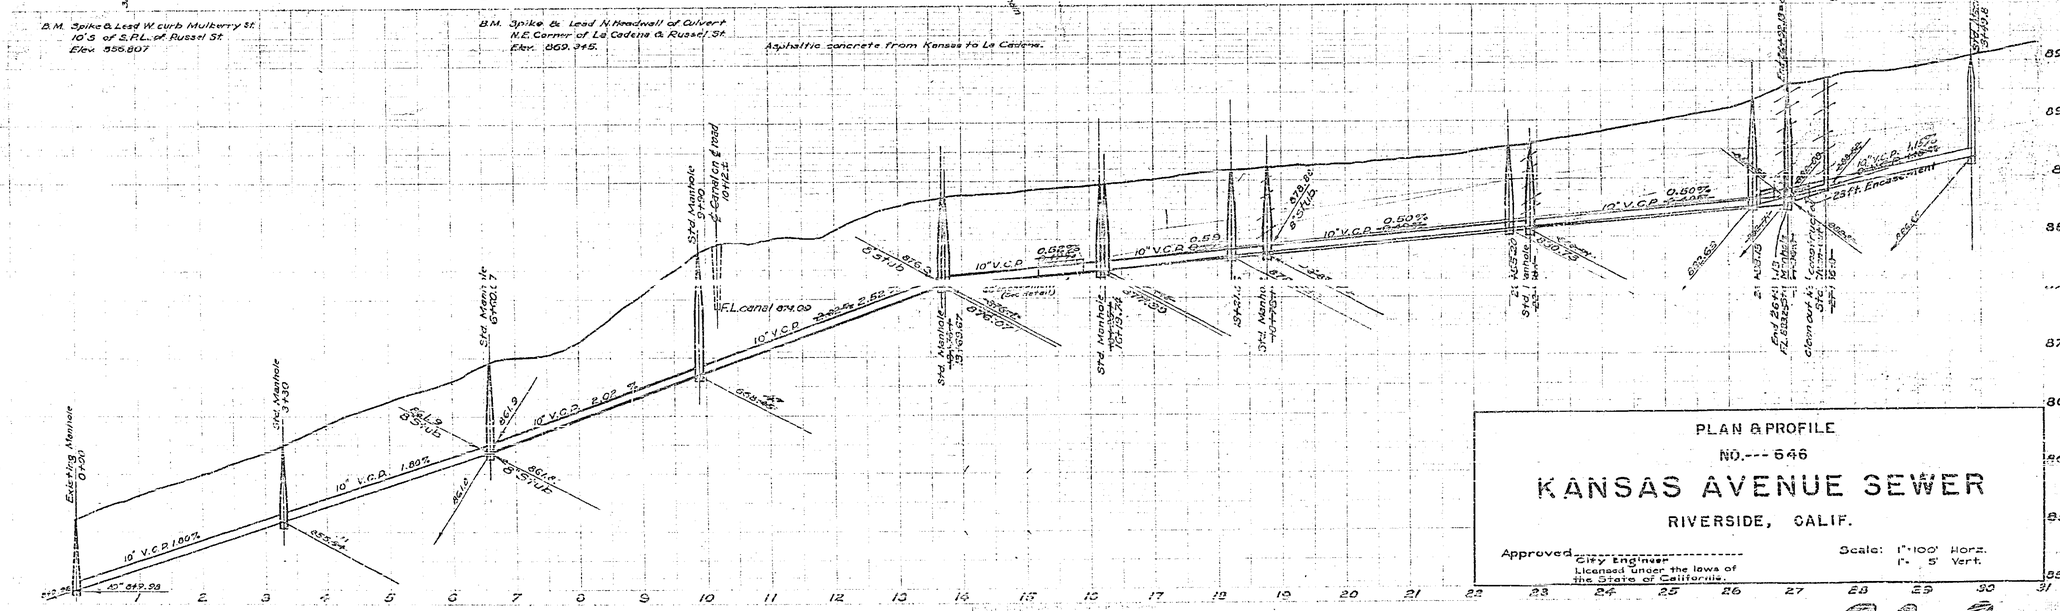

PLAN & PROFILE

NO.--- 646

KANSAS AVENUE SEWER

RIVERSIDE, CALIF.

Approved _____ City Engineer
Licensed under the laws of the State of California.

Scale: 1"=100' Horz.
1"= 5' Vert.

646