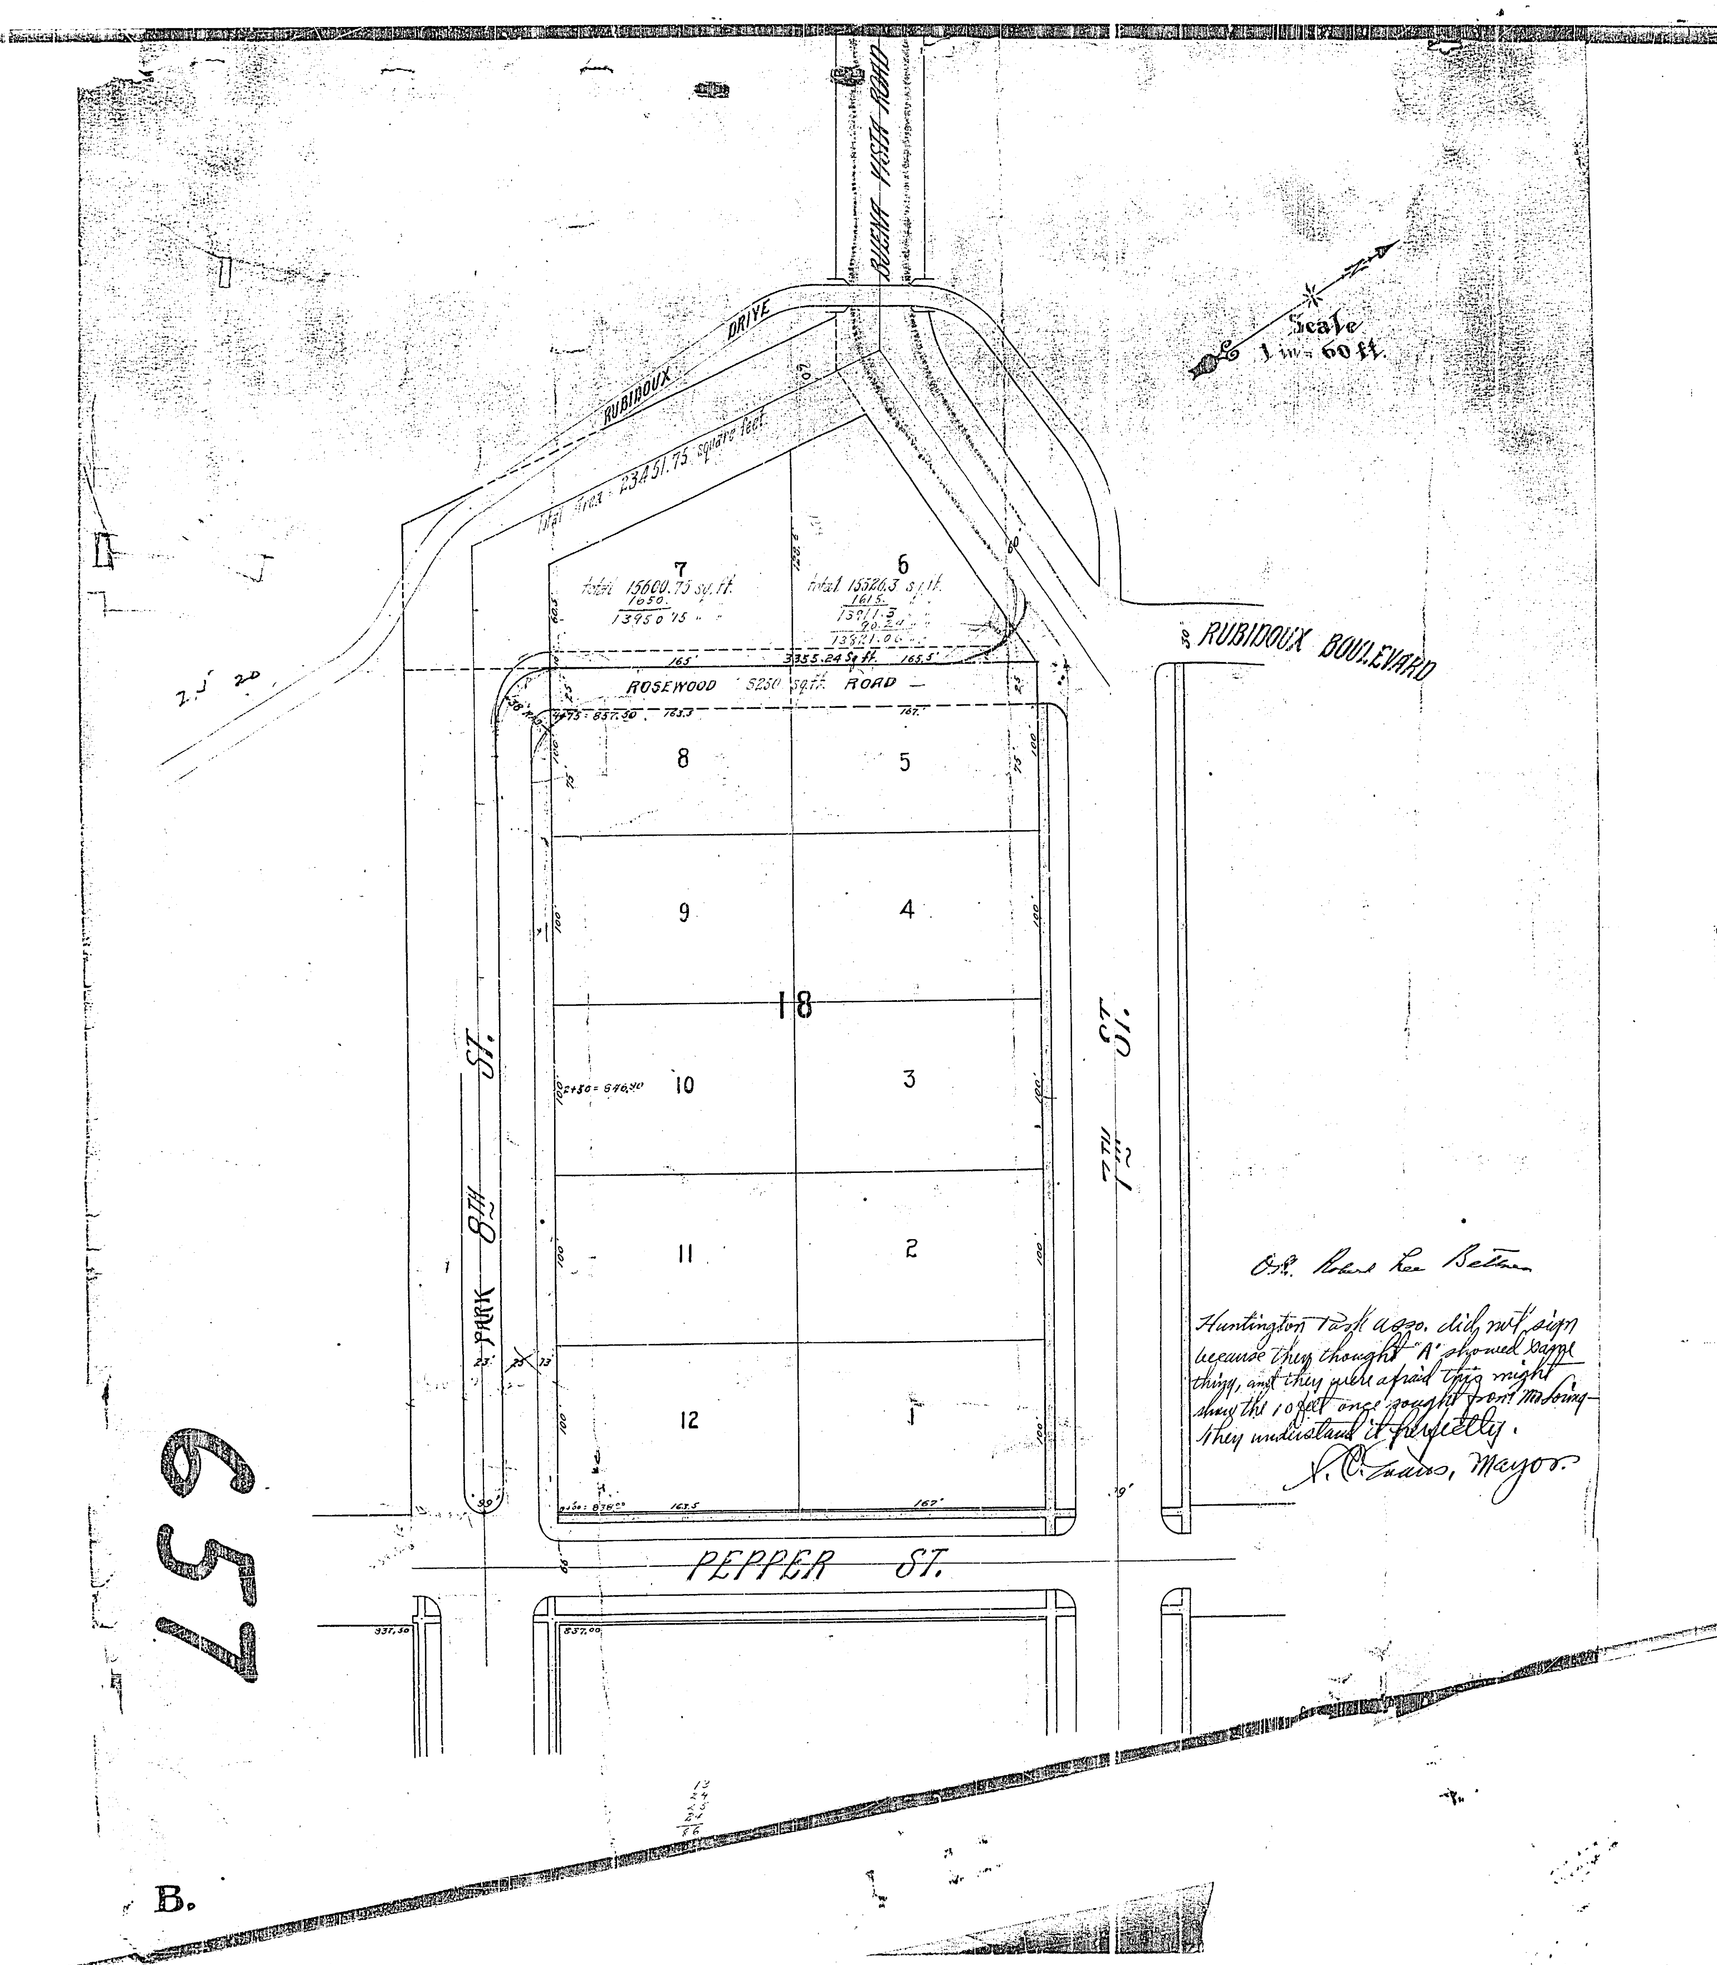

Ord. Board Res Below

Huntington Park ago. did not sign because they thought "A" showed same thing, and they were afraid they might show the 10 feet once bought from Mabony they understand it perfectly.

N. C. Evans, Mayor.


B.