


SLAB LOADS

Live load	100 ^{lb} /ft ²
Dead load	50 ^{lb} /ft ²
Total	150 ^{lb} /ft ²

N.B. From Sta. 3+7500 to Sta. 4+54.38, make uniform wall transition from height of 4'-5\"/>

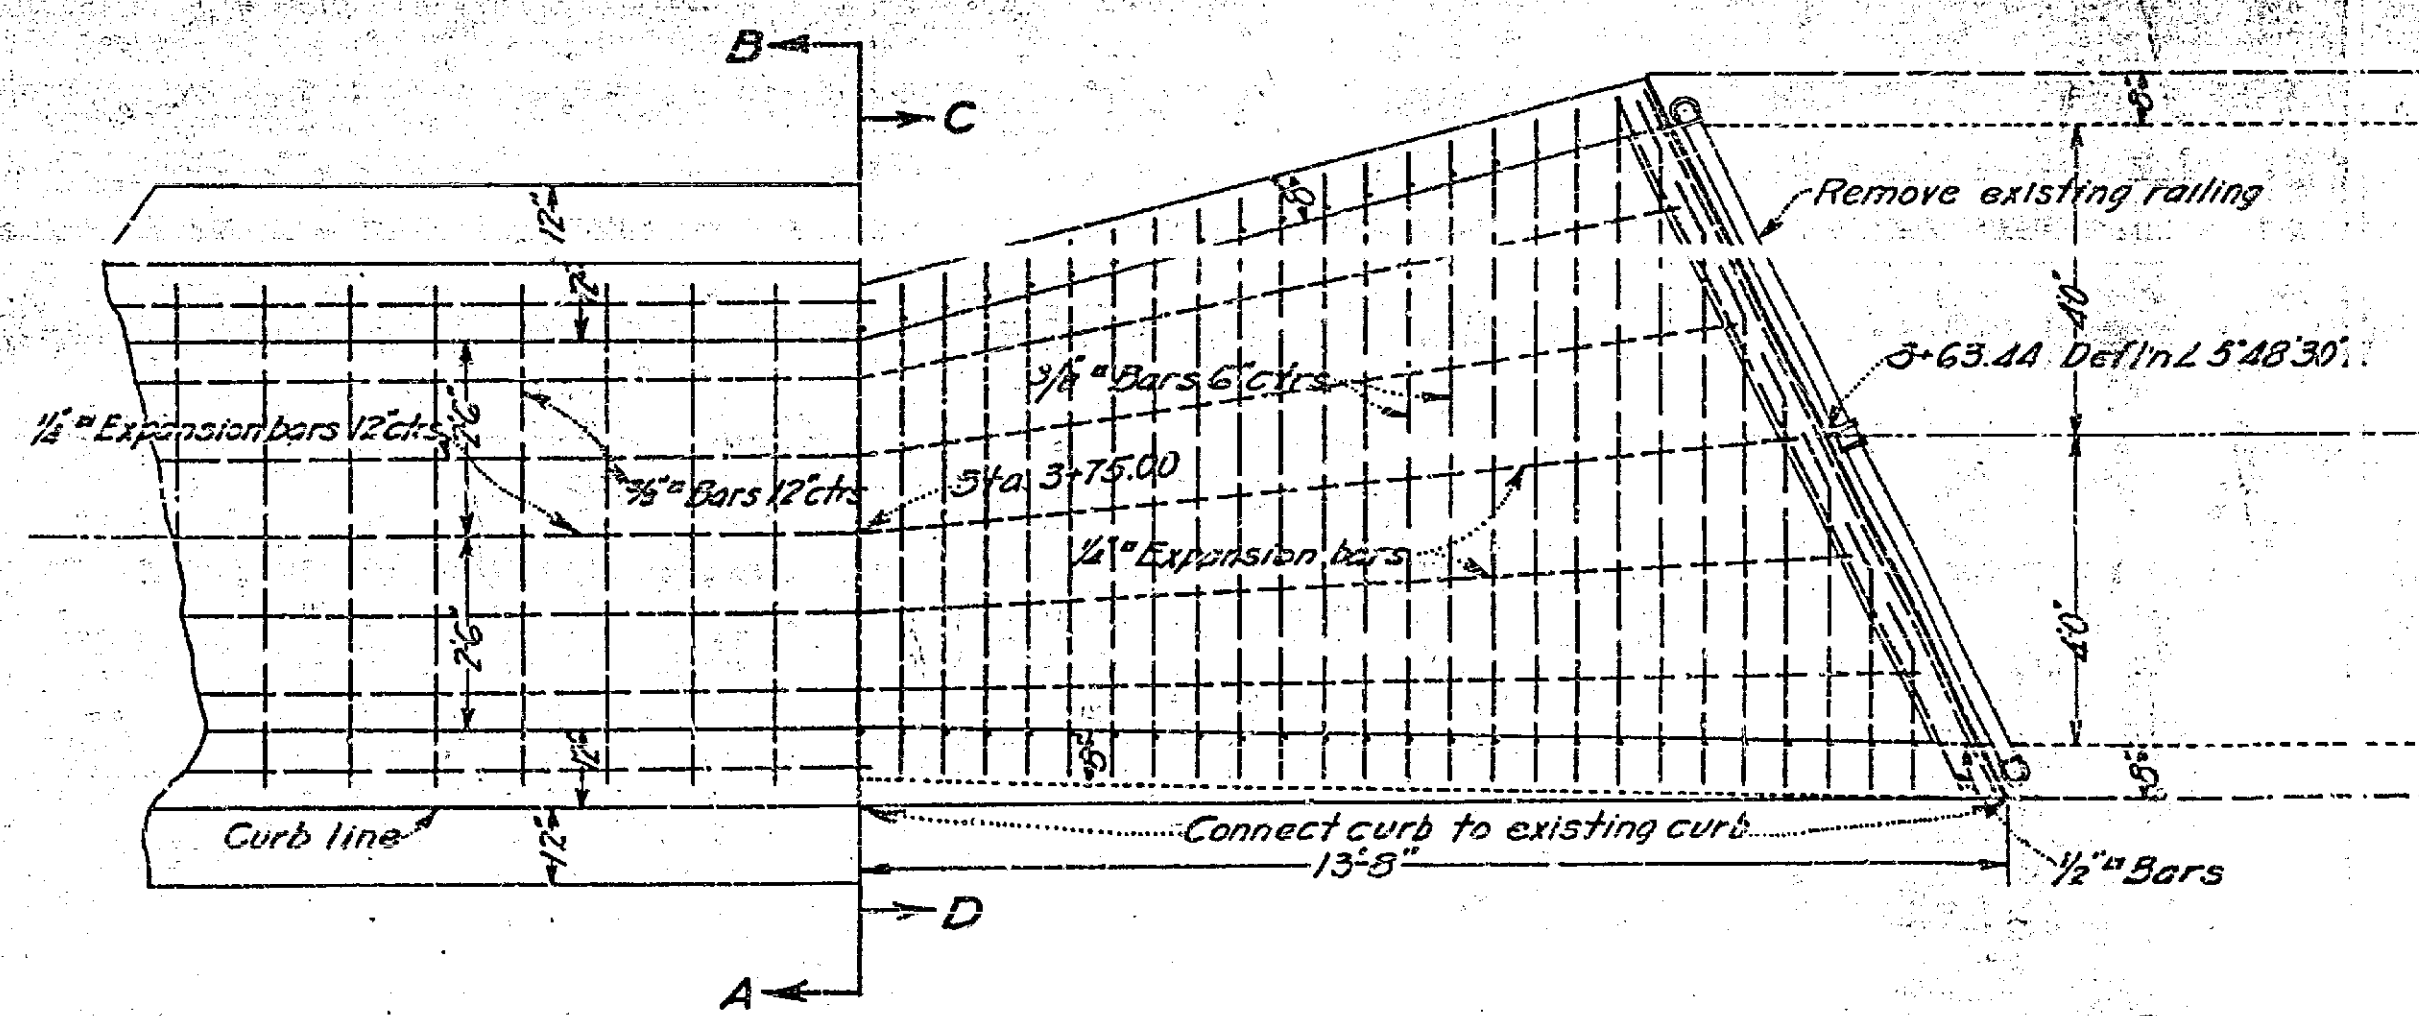

685

FRAME 1 OF 2

BY THE BOARD OF PUBLIC WORKS

14

13

12

11

10 BY THE BOARD OF PUBLIC WORKS

8

7


6

5


APPROVED *[Signature]* **CITY ENGINEER**



APPROVED BY THE BOARD OF PUBLIC WORKS
CITY CLERK

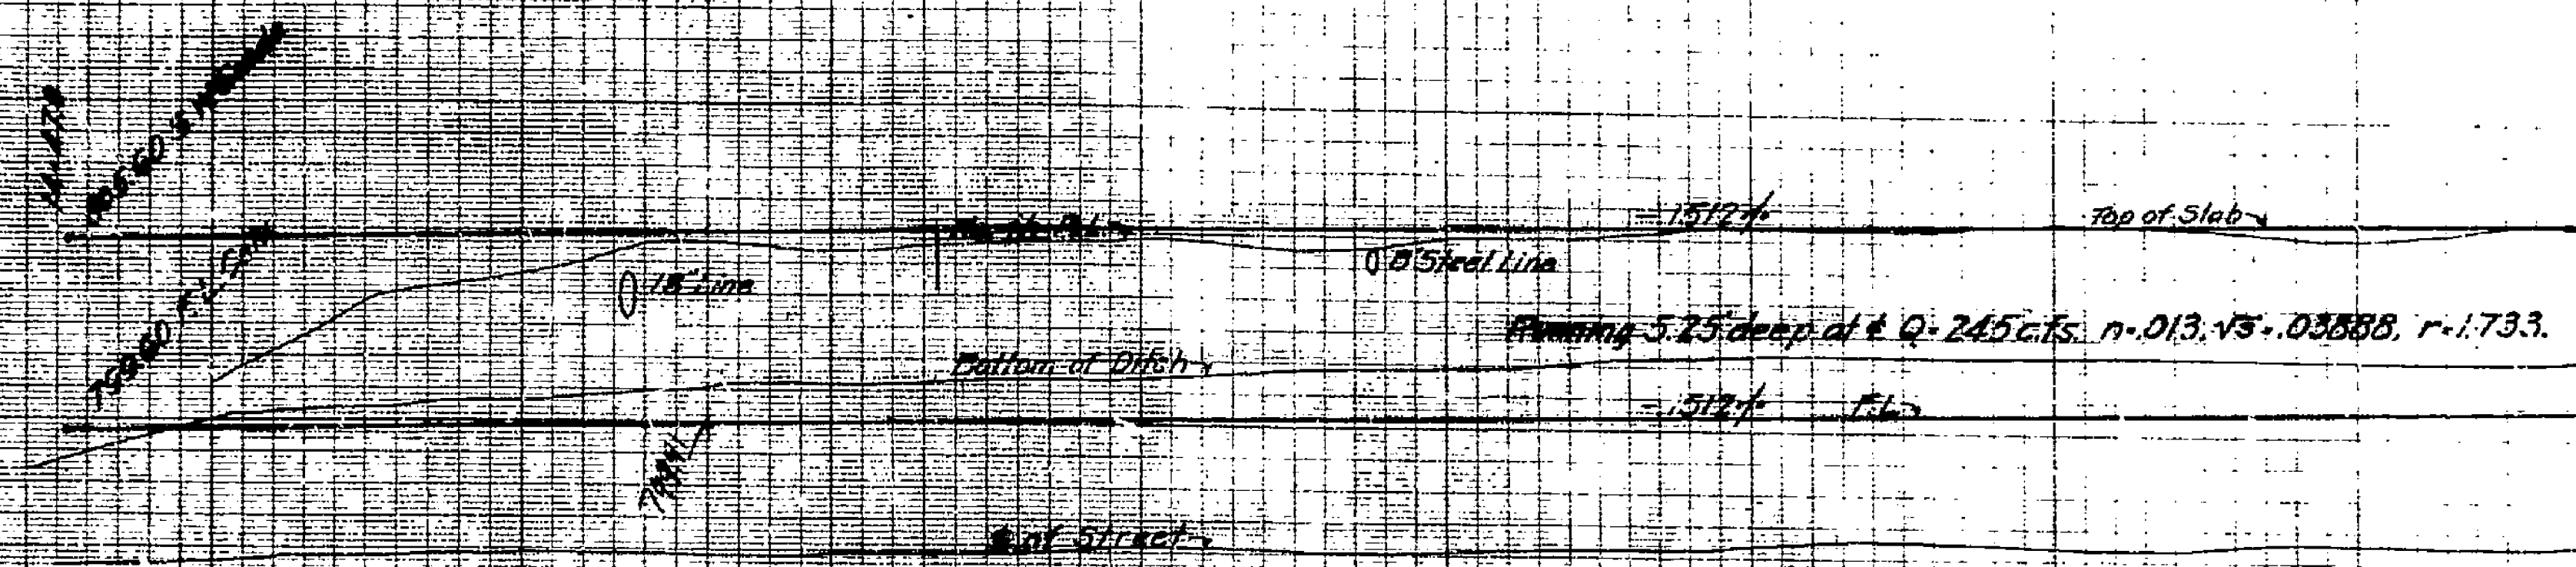

800

830

Constructed by Street Dept. 1935. W.P.A. Labor.

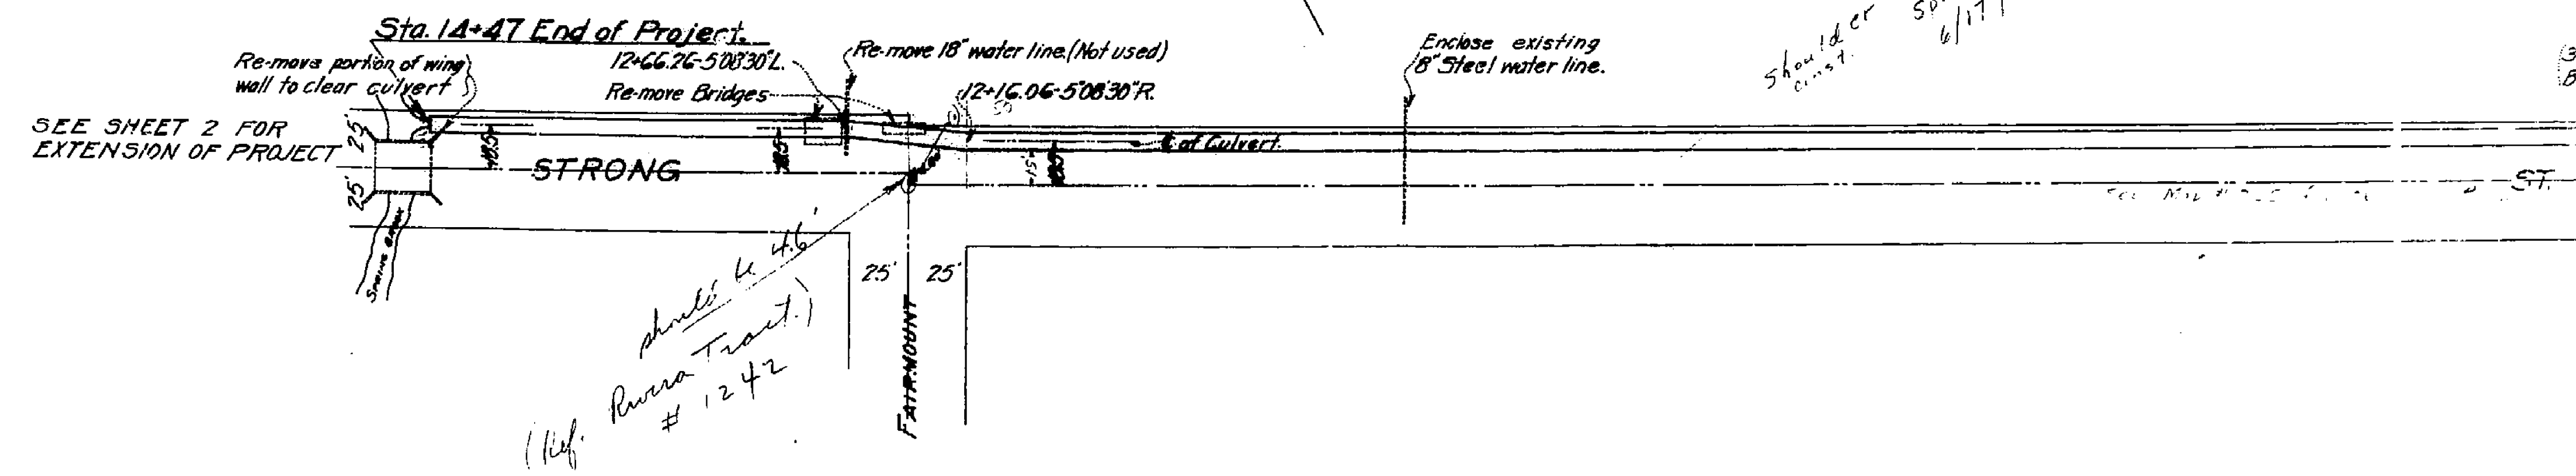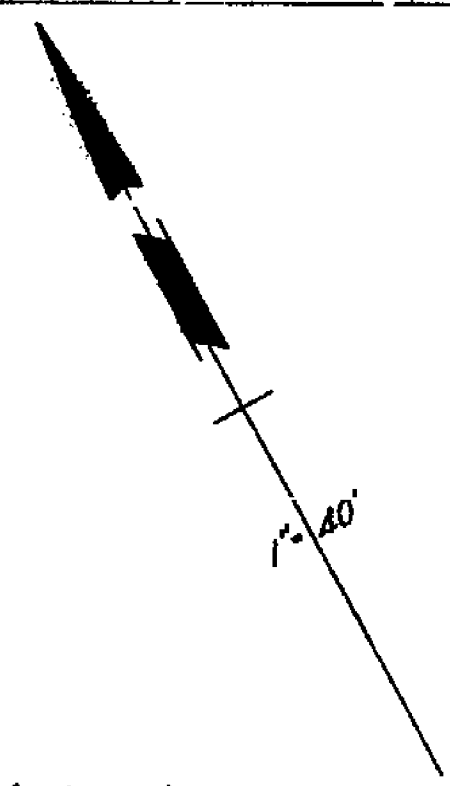

Shoulder
 Main St. to
 Spring Brook
 6/17/36

(Ref. River Tract)
 # 1242