


See 1261

1915

Scale 1" = 200'

Blue prints made from this Tracing (Map of Brockton Av. North of Bandini Ave.) are attached to Deed for widening Brockton Ave.

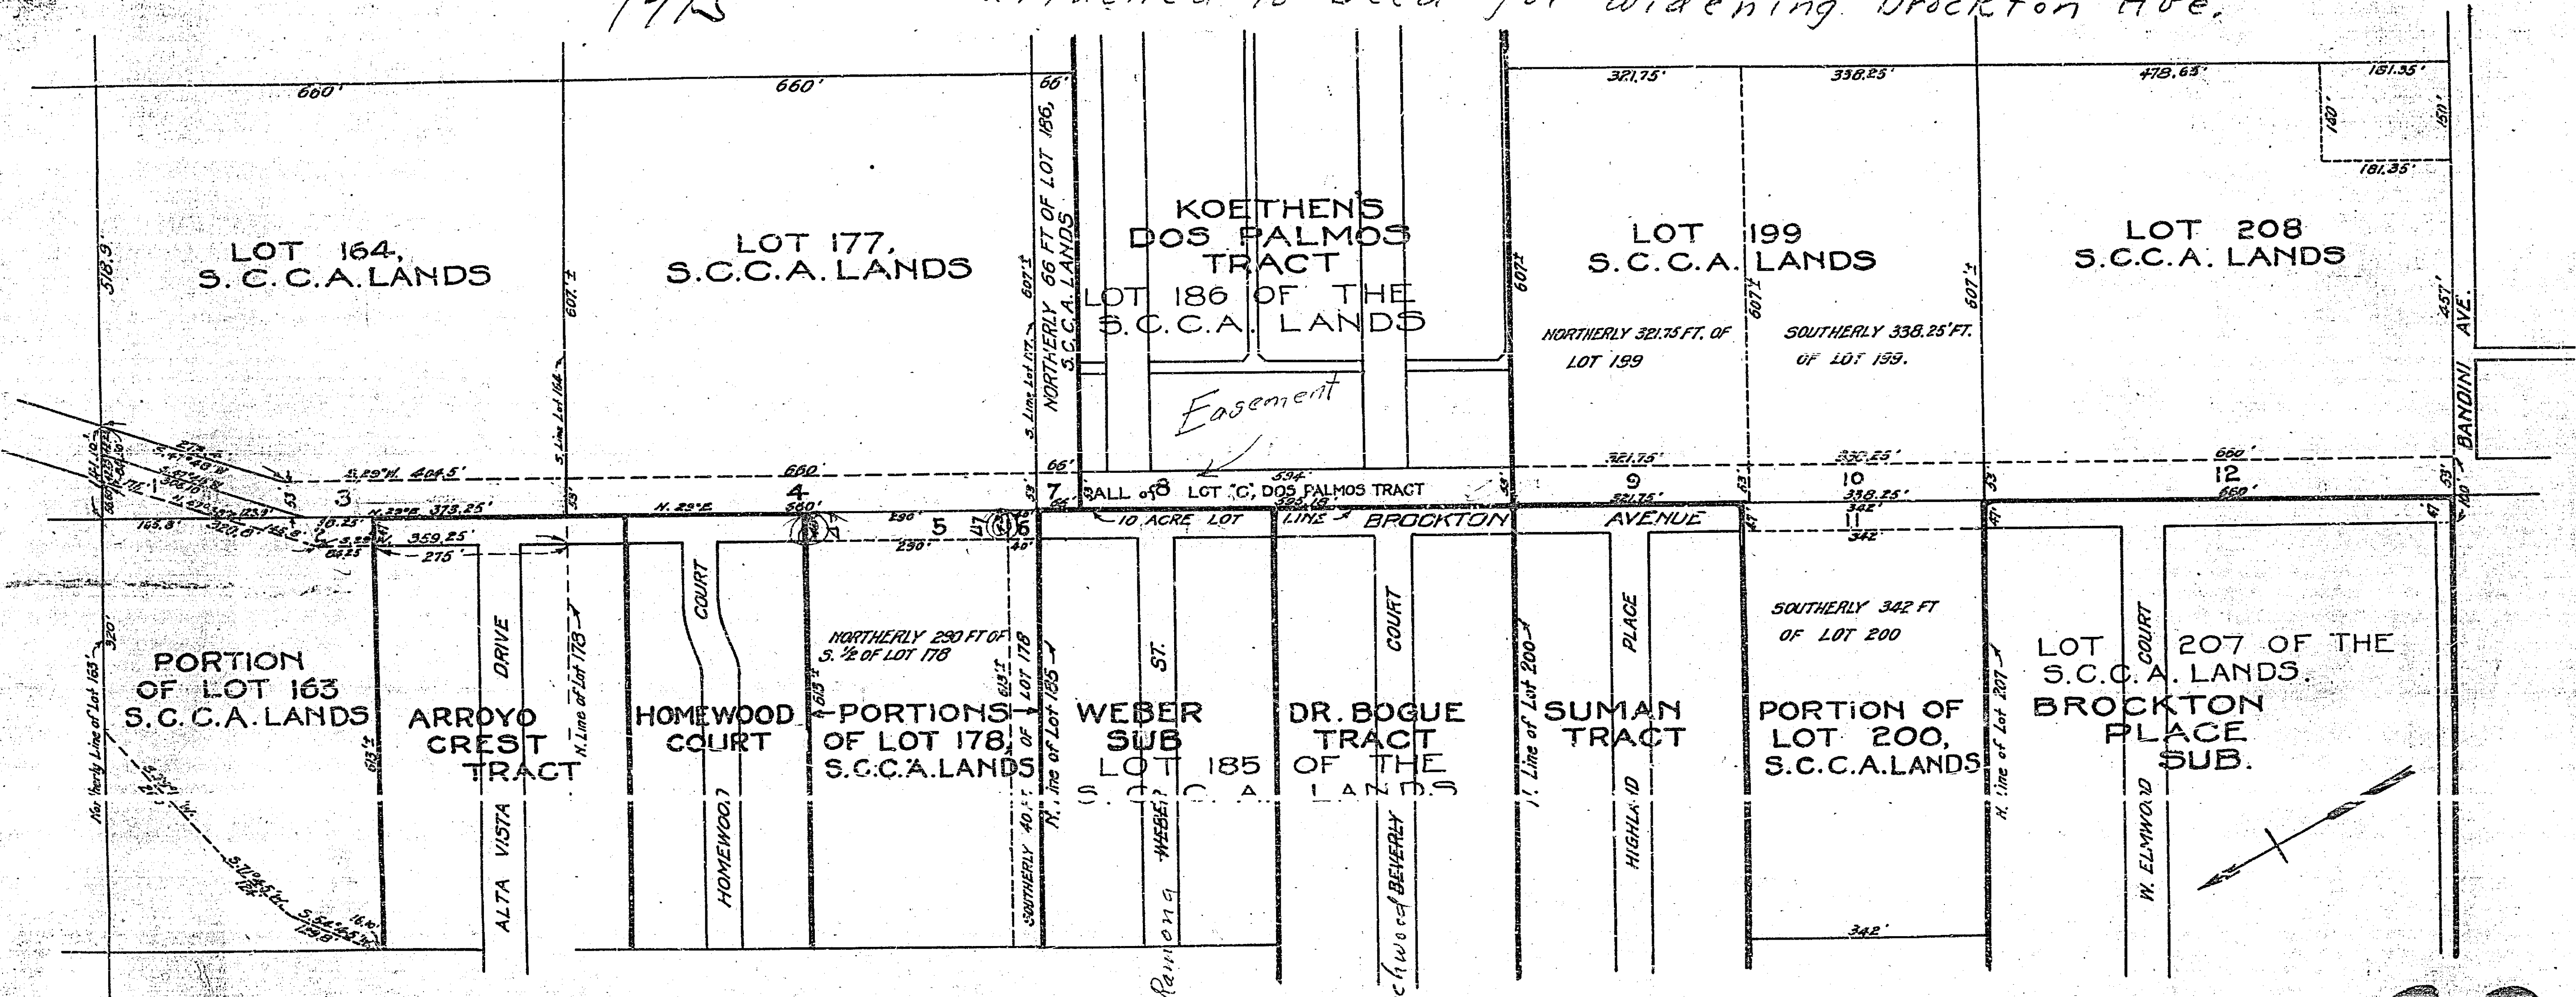

686