



MAP SHOWING
PROPOSED DAM & EXTENTION
OF LAKE AT FAIRMOUNT PARK

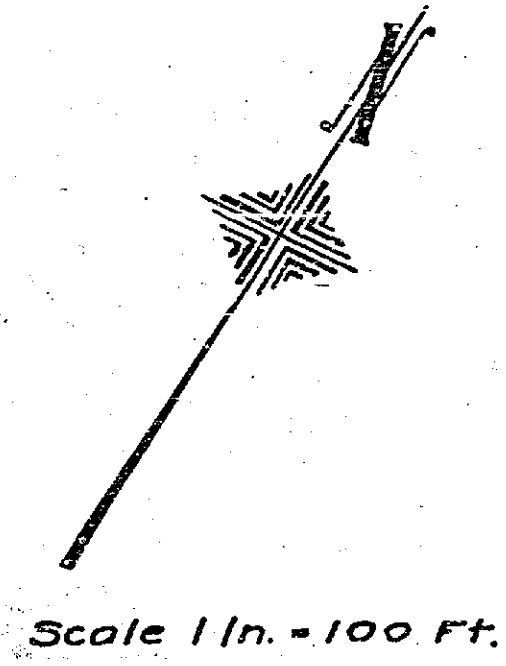

as of 1929

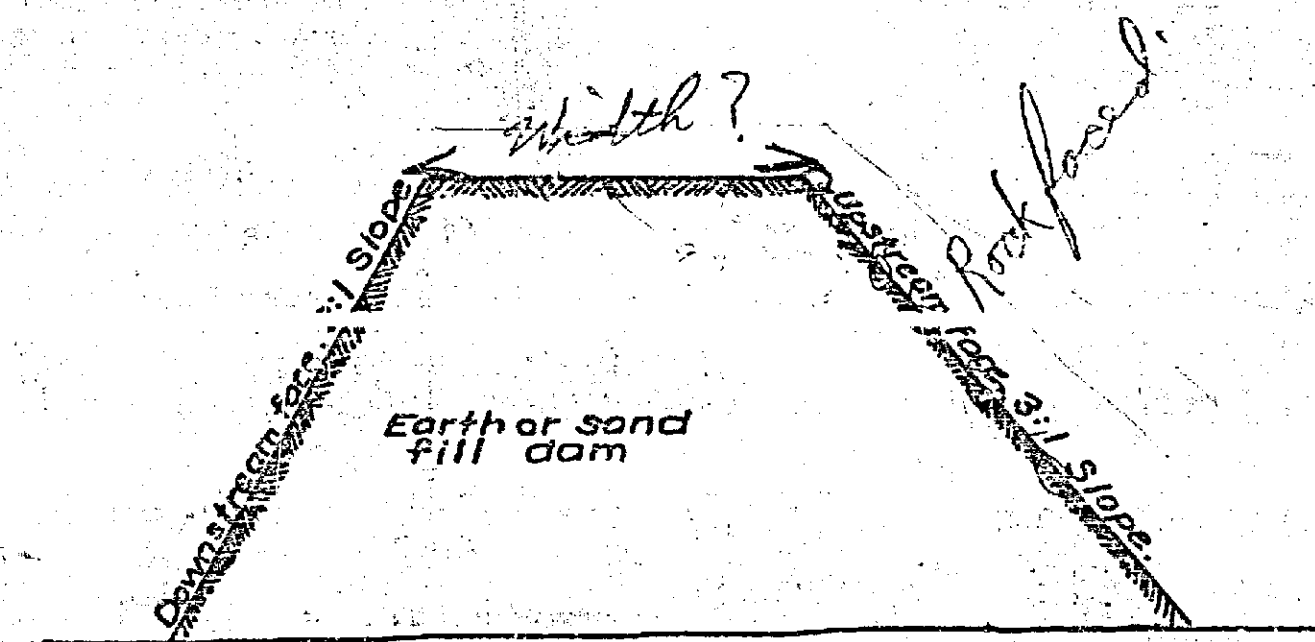

Average Section
SECTION OF DAM
AT STA. 2+00

