

DIAGRAM

EXHIBITING DOWN STREET IMPROVEMENT DISTRICT

IN THE CITY OF RIVERSIDE ON WHICH WORK HAS BEEN DONE UNDER MY OFFICIAL CONTRACT AS SUPERINTENDENT OF STREETS OF SAID CITY WITH PIPELINE CONSTRUCTION COMPANY DATED DEC. 6, 1950 FOR THE CONSTRUCTION OF CONCRETE CURBS & GUTTERS & DOUBLE GUTTER


AS IS MORE PARTICULARLY DESCRIBED IN SAID CONTRACT TO WHICH REFERENCE IS HEREBY MADE FOR FURTHER PARTICULARS; SAID DIAGRAM ALSO SHOWS THE RELATIVE LOCATION OF EACH LOT, PORTION OF LOT, PIECE OR PARCEL OF LAND ASSESSED FOR THE WORK DONE NUMBERED IN RED INK NUMBERS IN THE ASSESSMENT HEREIN FIGURES NEXT TO PROPERTY LINES SHOW LENGTH OF SAID LINES IN FEET. THE MARK (J) MEANS FEET. PROPERTY LINES THAT DIFFER FROM THE RECORDED SUBDIVISIONS ARE SHOWN BY BROKEN LINES. THE DISTRICT BENEFITED IS BOUNDARY COVERED BY THIS ASSESSMENT IS SHOWN ON THE FOLLOWING RECORDED MAPS:

- DOWNS SUBDIVISION MAP BK.9 PG.46 REC. OF SAN BERNARDINO CO.
- WILBUR TRACT MAP BK.6 PG.4 REC. OF SAN BERNARDINO CO.
- ROQUET TRACT MAP BK.21 PG.86 REC. OF RIVERSIDE CO.

I HEREBY CERTIFY THAT THIS ASSESSMENT DIAGRAM WAS APPROVED BY THE CITY COUNCIL OF THE CITY OF RIVERSIDE AT A MEETING THEREOF HELD ON THE 19th DAY OF

CITY CLERK OF THE CITY OF RIVERSIDE.

HEREIN THE LEGEND OF THE DIFFERENT KINDS OF WORK PERFORMED IS SHOWN AS FOLLOWS:

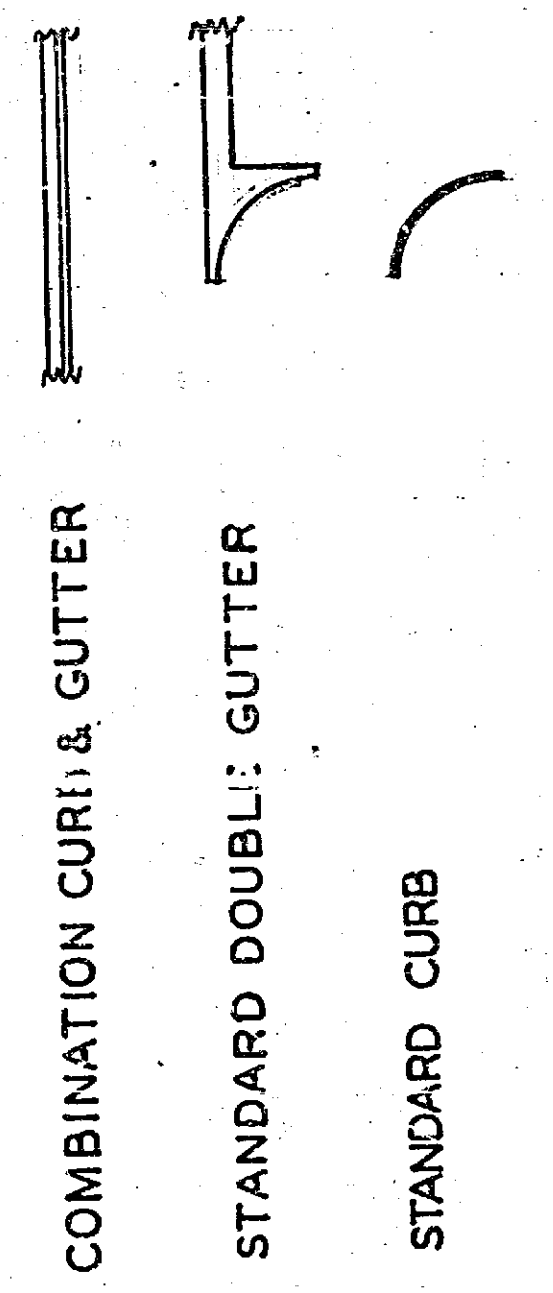

SUPERINTENDENT OF STREETS OF THE CITY OF RIVERSIDE
THE FOLLOWING IS A STATEMENT OF AMOUNTS OF DIFFERENT KINDS OF WORK DONE BY PIPELINE CONSTRUCTION COMPANY UNDER CONTRACT DATED DECEMBER 6, 1950 PURSUANT TO RESOLUTION OF INTENTION NO. 4890 ADOPTED BY THE CITY COUNCIL OF THE CITY OF RIVERSIDE ON THE 29TH DAY OF AUGUST 1950

LIST OF QUANTITIES	
COMBINATION CURB & GUTTER	138530 LIN. FT.
STANDARD DOUBLE GUTTER	281.22 SQ. FT.
STANDARD CURB	44.7 LIN. FT.

AT SAID CITY OF RIVERSIDE THIS DAY OF

SUPERINTENDENT OF STREETS OF THE CITY OF RIVERSIDE.

I HEREBY CERTIFY THAT THE ABOVE WORK WAS DONE IN ACCORDANCE WITH LINES AND GRADES FURNISHED BY ME AND THAT THE DIAGRAM OF THE ASSESSMENT DISTRICT FOR THE SAME IS CORRECT.

CITY ENGINEER OF THE CITY OF RIVERSIDE.

RECORDED AT O'CLOCK M. THIS DAY OF 19

SUPERINTENDENT OF STREETS OF THE CITY OF RIVERSIDE.

File with 109

697-A