

55.0

11.0

11.0

82.0


See F. 716-B

83.0

11.0

11.0

55.0

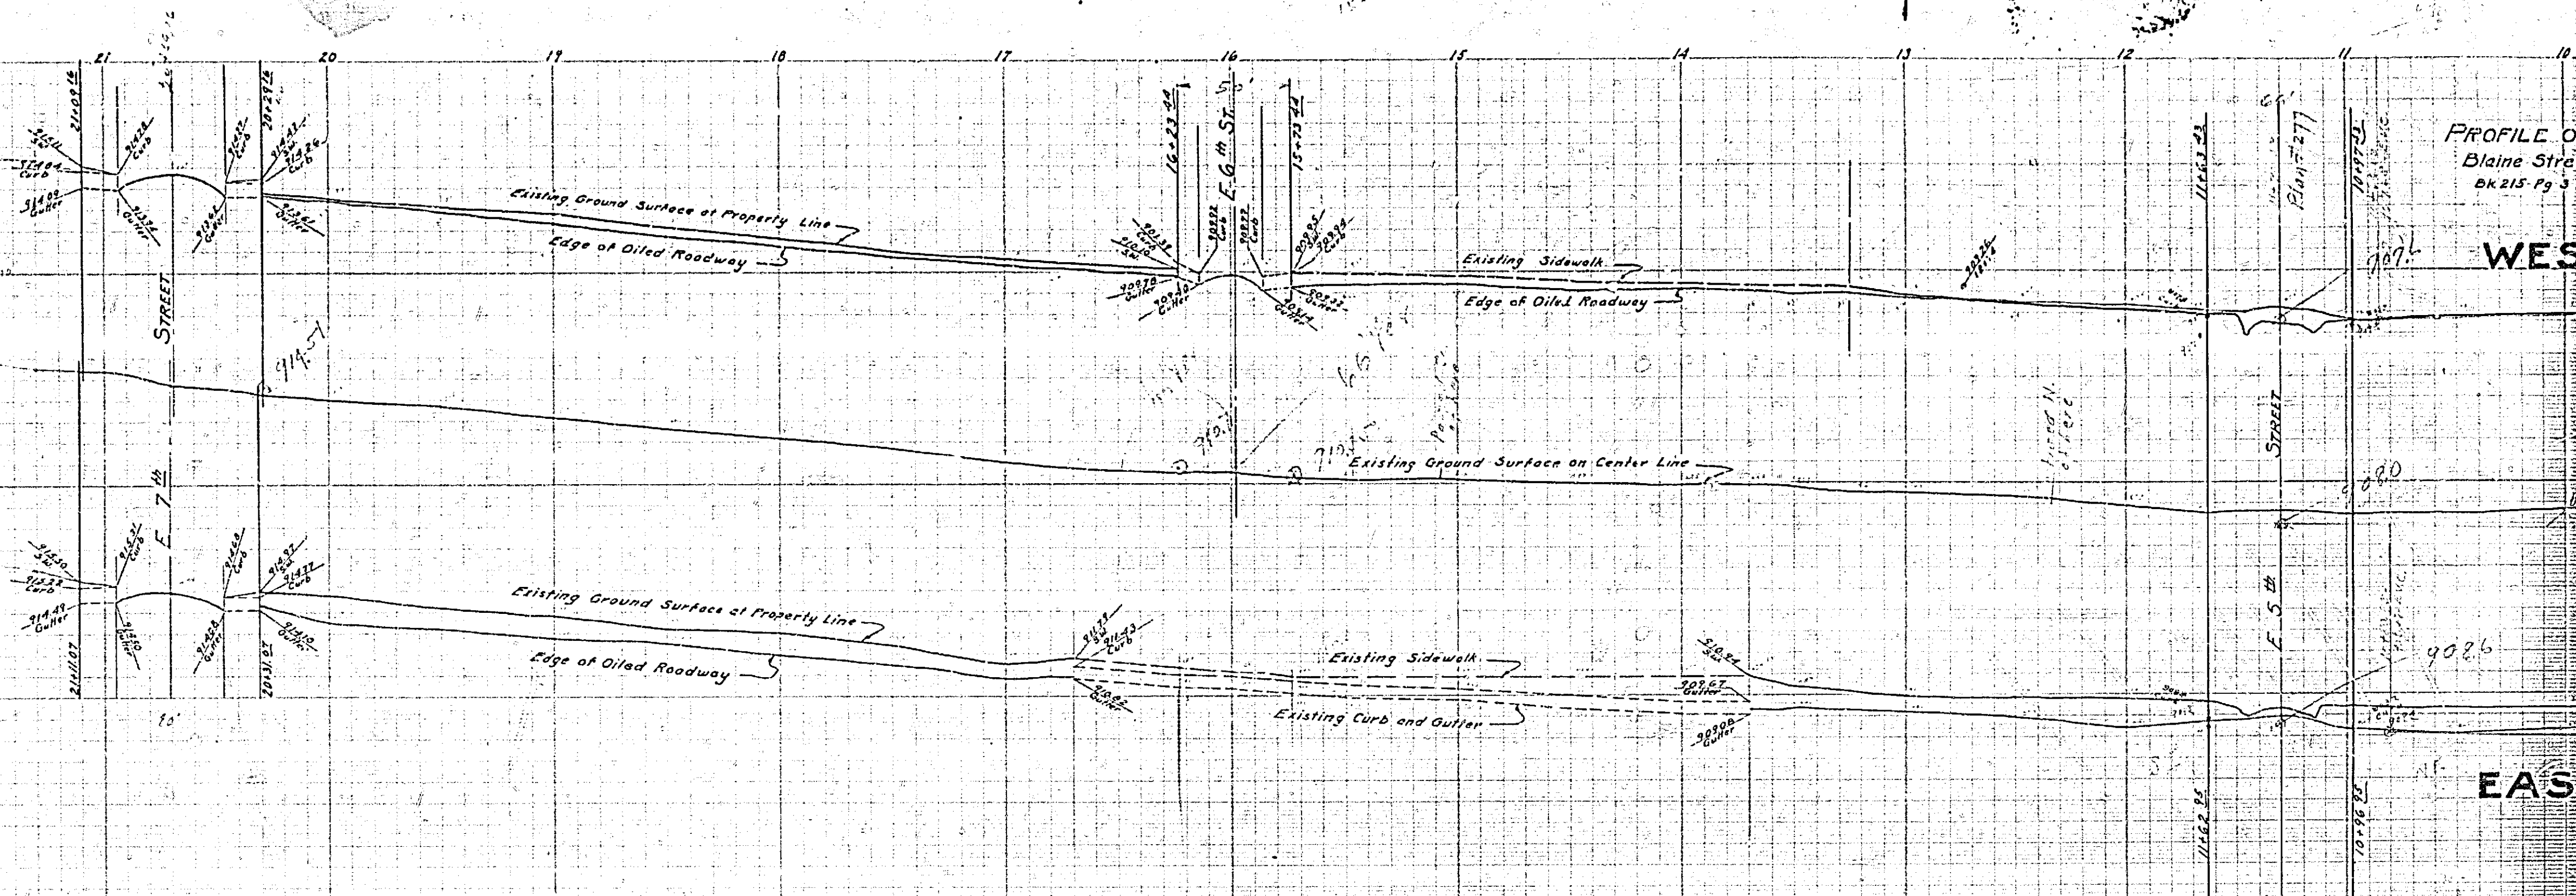

PROFILE OF
Blaine Street
DK 215 Pg 3 of 4



WEST

EAST

PROFILE OF FRANKLIN AVENUE
Blaine Street to East 7th Street
DK 215 Pg 3 of 41 2-5-30

WEST SIDE

EAST SIDE

 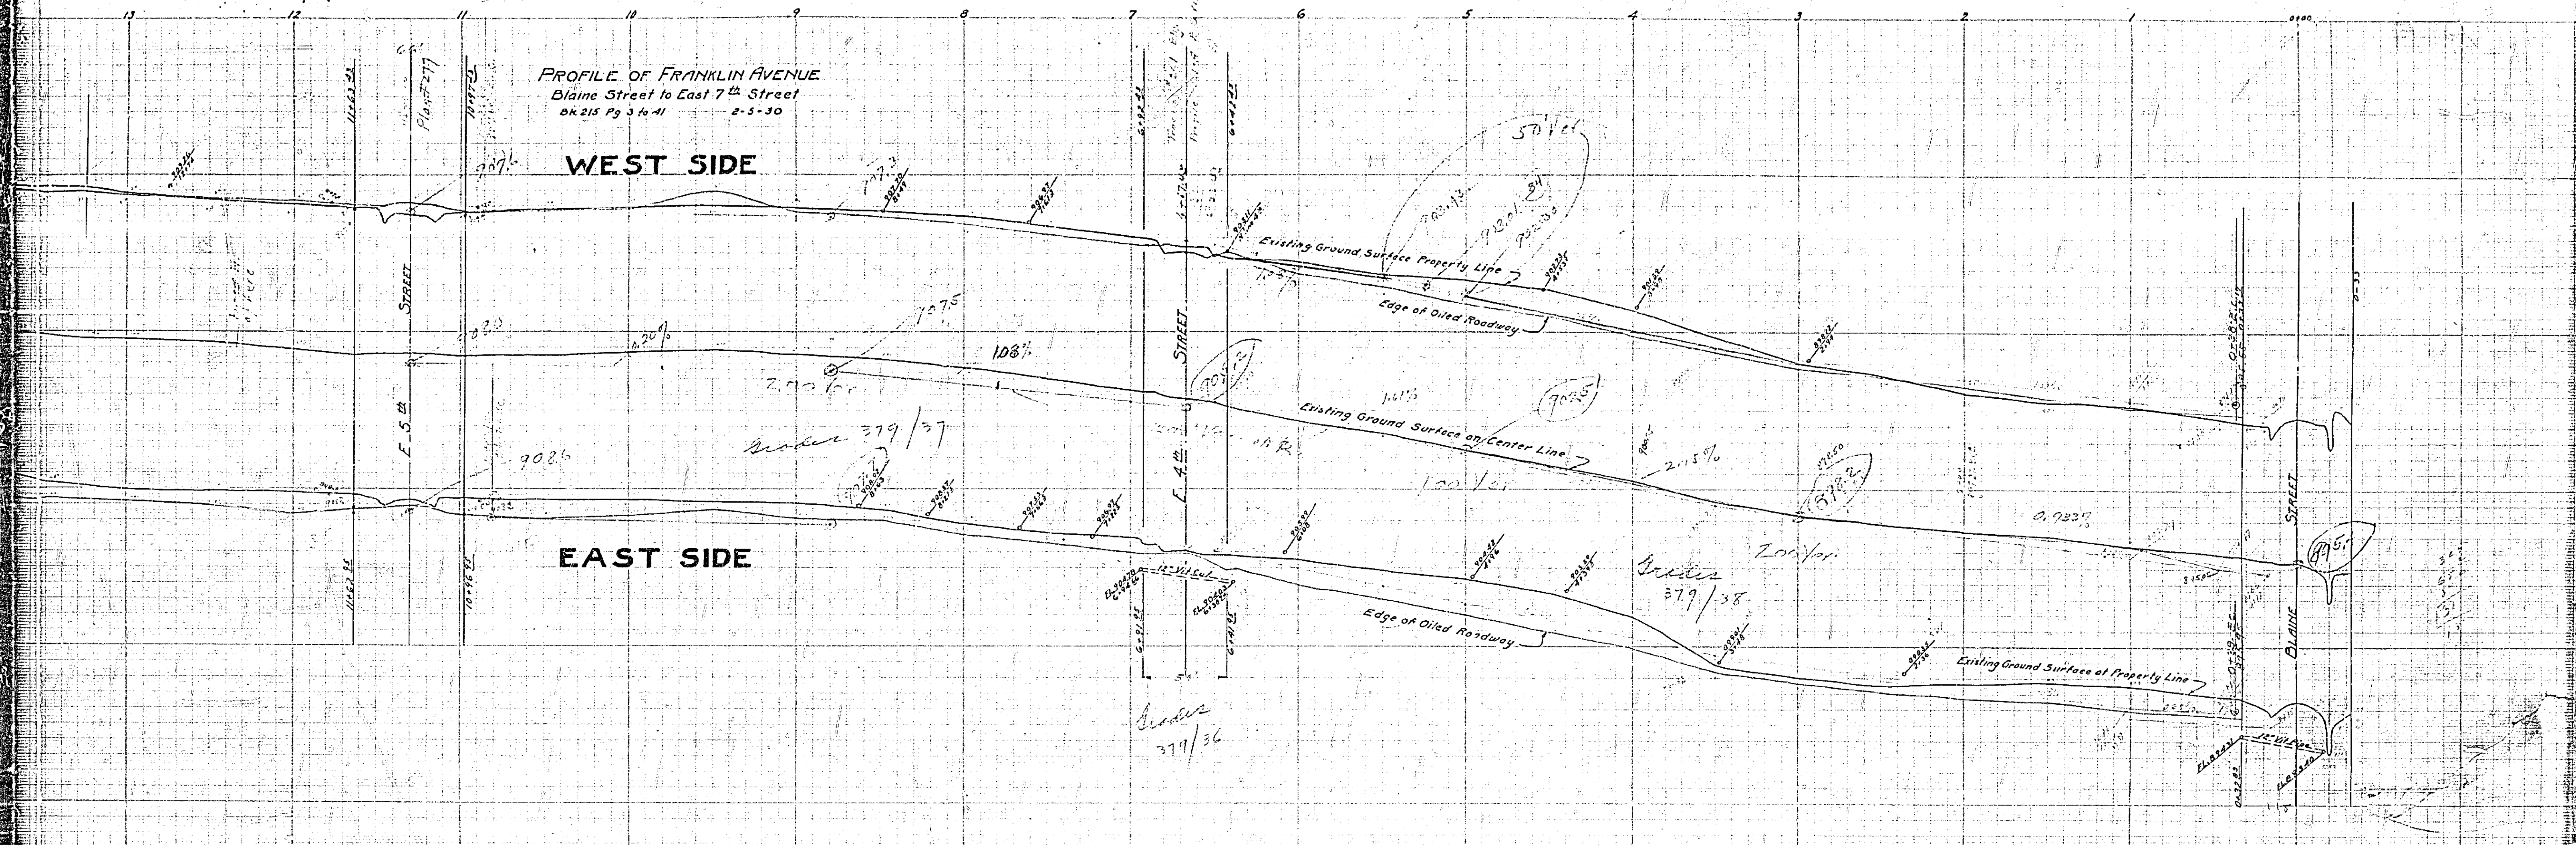

716-A

FRAME 2 OF 2

FRAME 1 OF 2

35.
11.
11.
82.
82.
11.
11.
35.