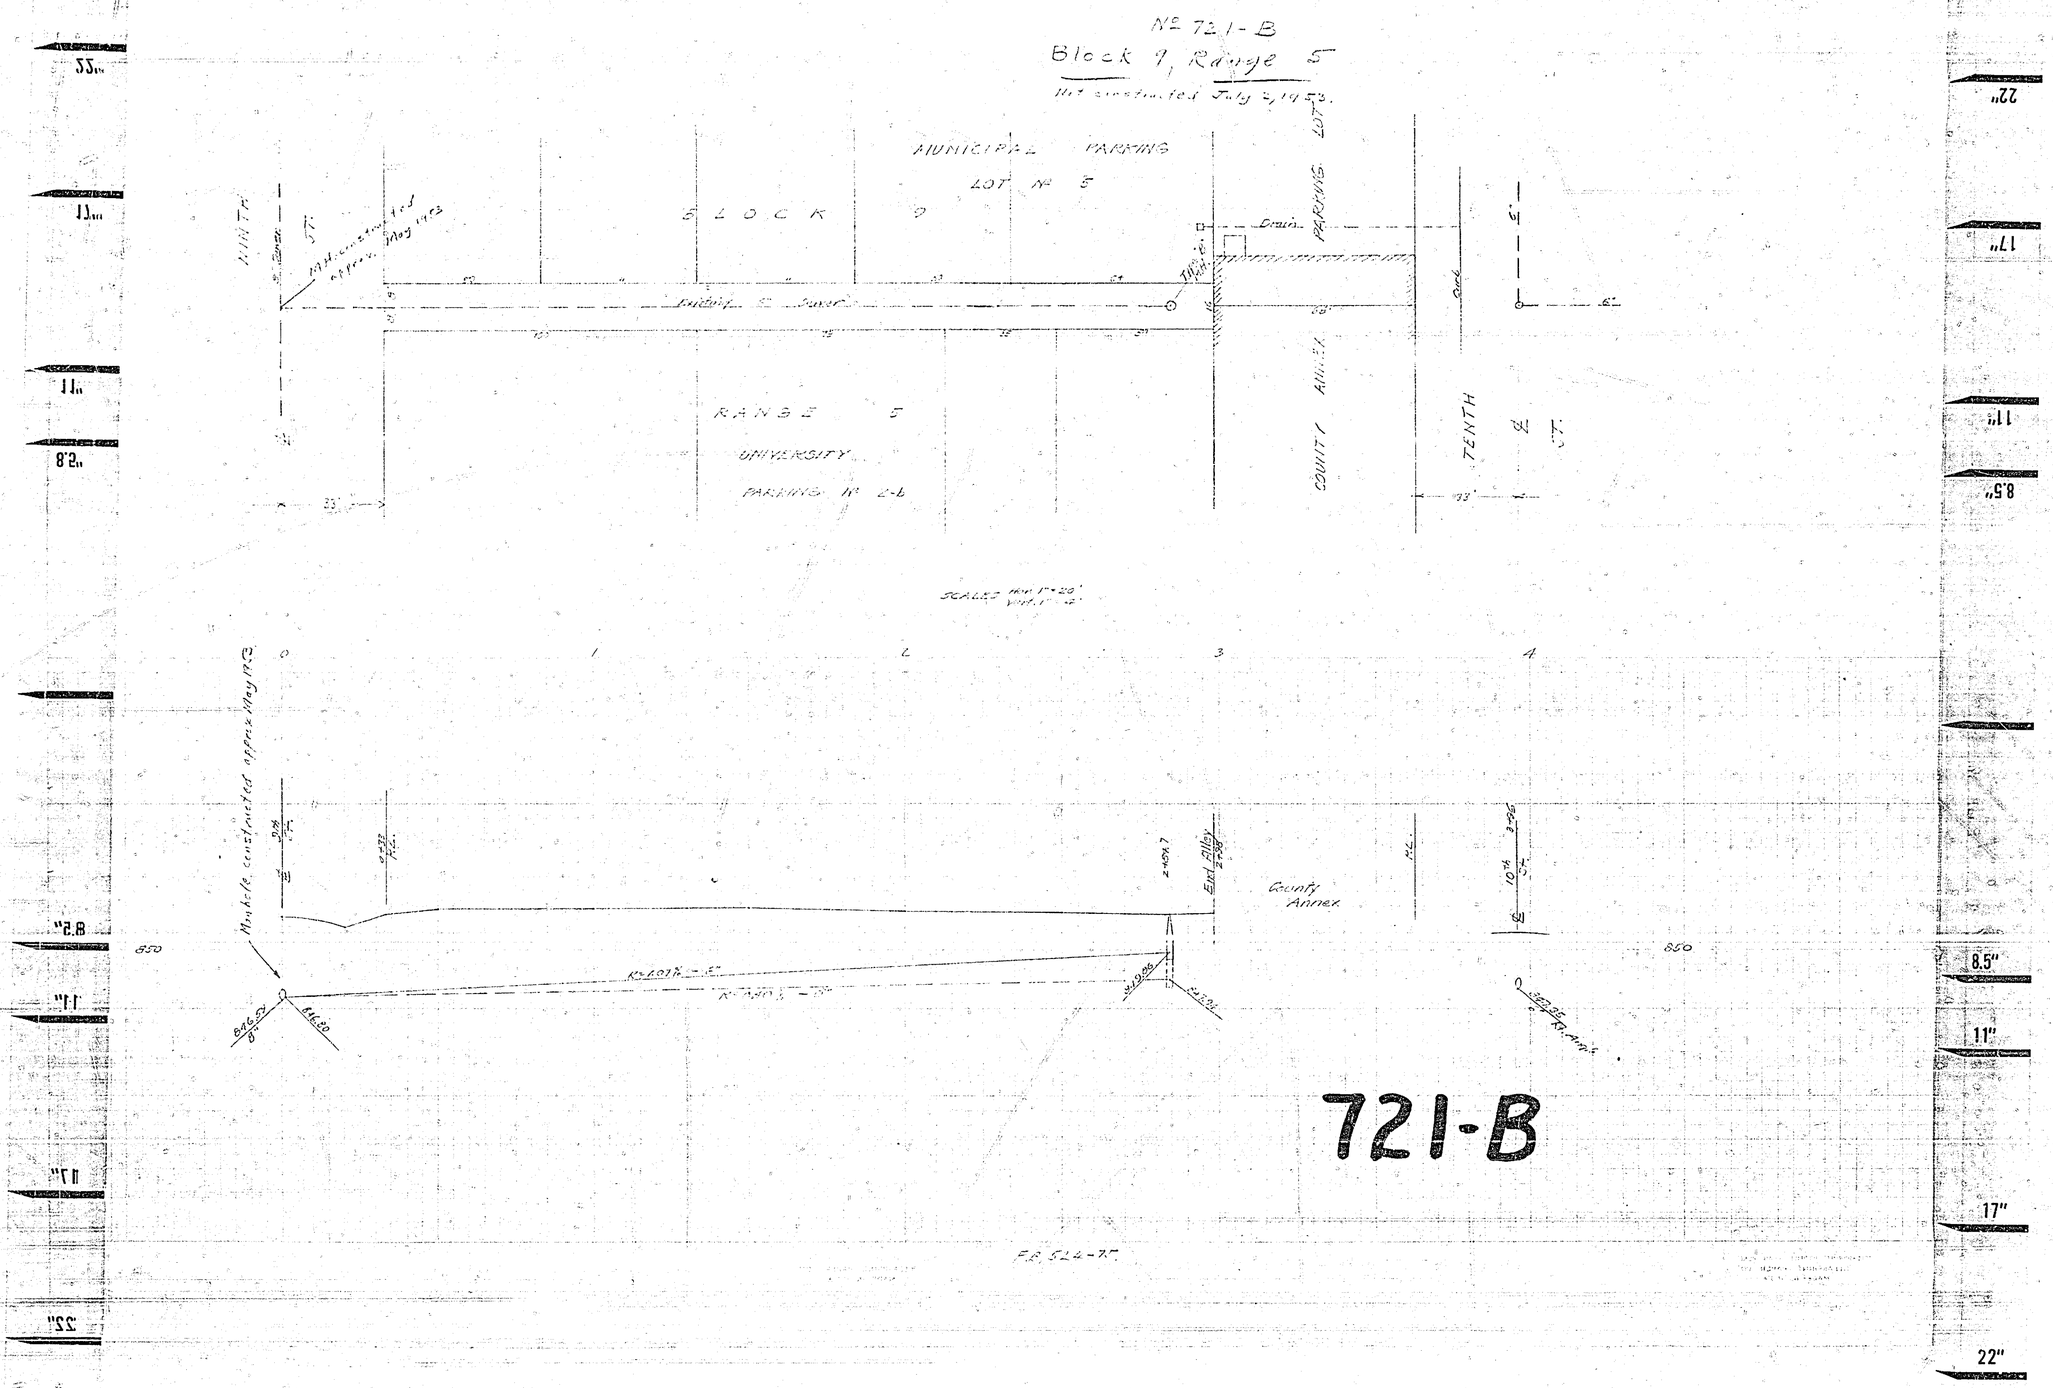

No 721-B
Block 9, Range 5
Hit constructed July 2, 1953.
MUNICIPAL PARKING
LOT No 5
BLOCK 9
RANGE 5
UNIVERSITY
PARKING No 2-b
NINTH
ST.
Drain
PARKING LOT
COUNTY ANNEX
TENTH
ST.
Manhole constructed approx May 1953
County Annex
850
721-B