
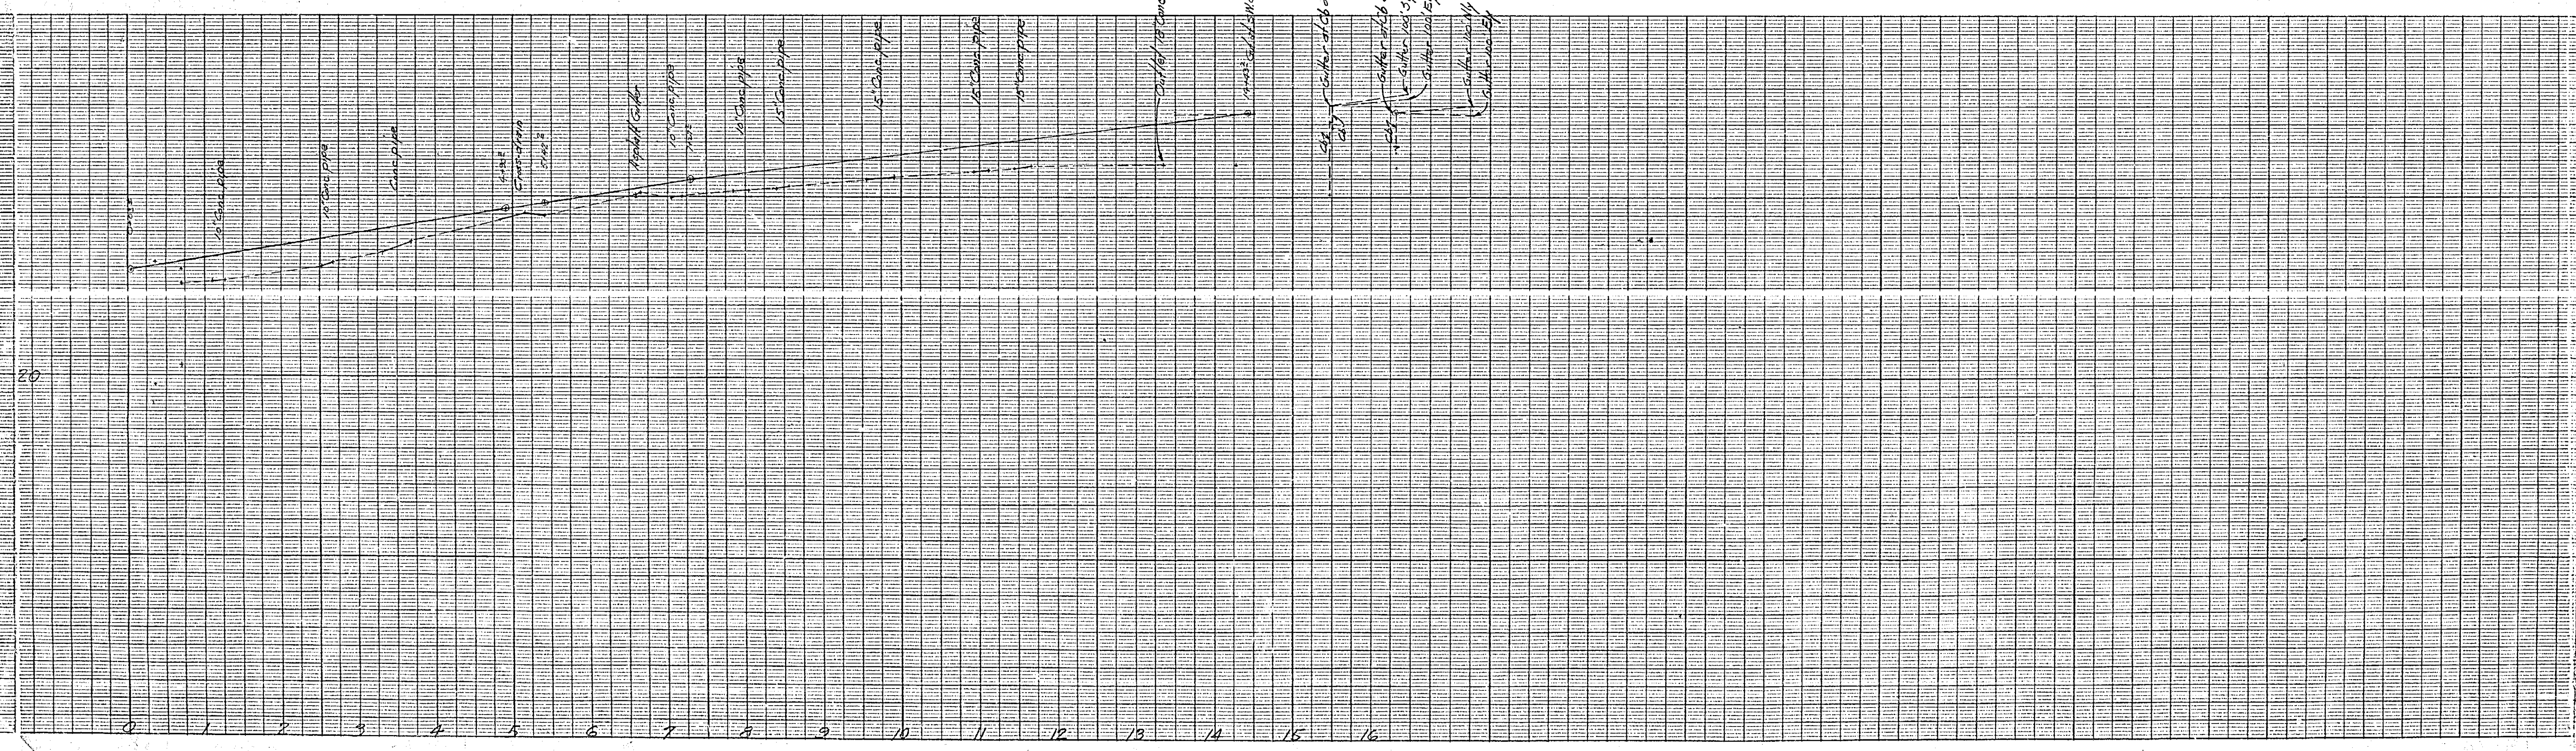


737-B

Scale:
1"=20'

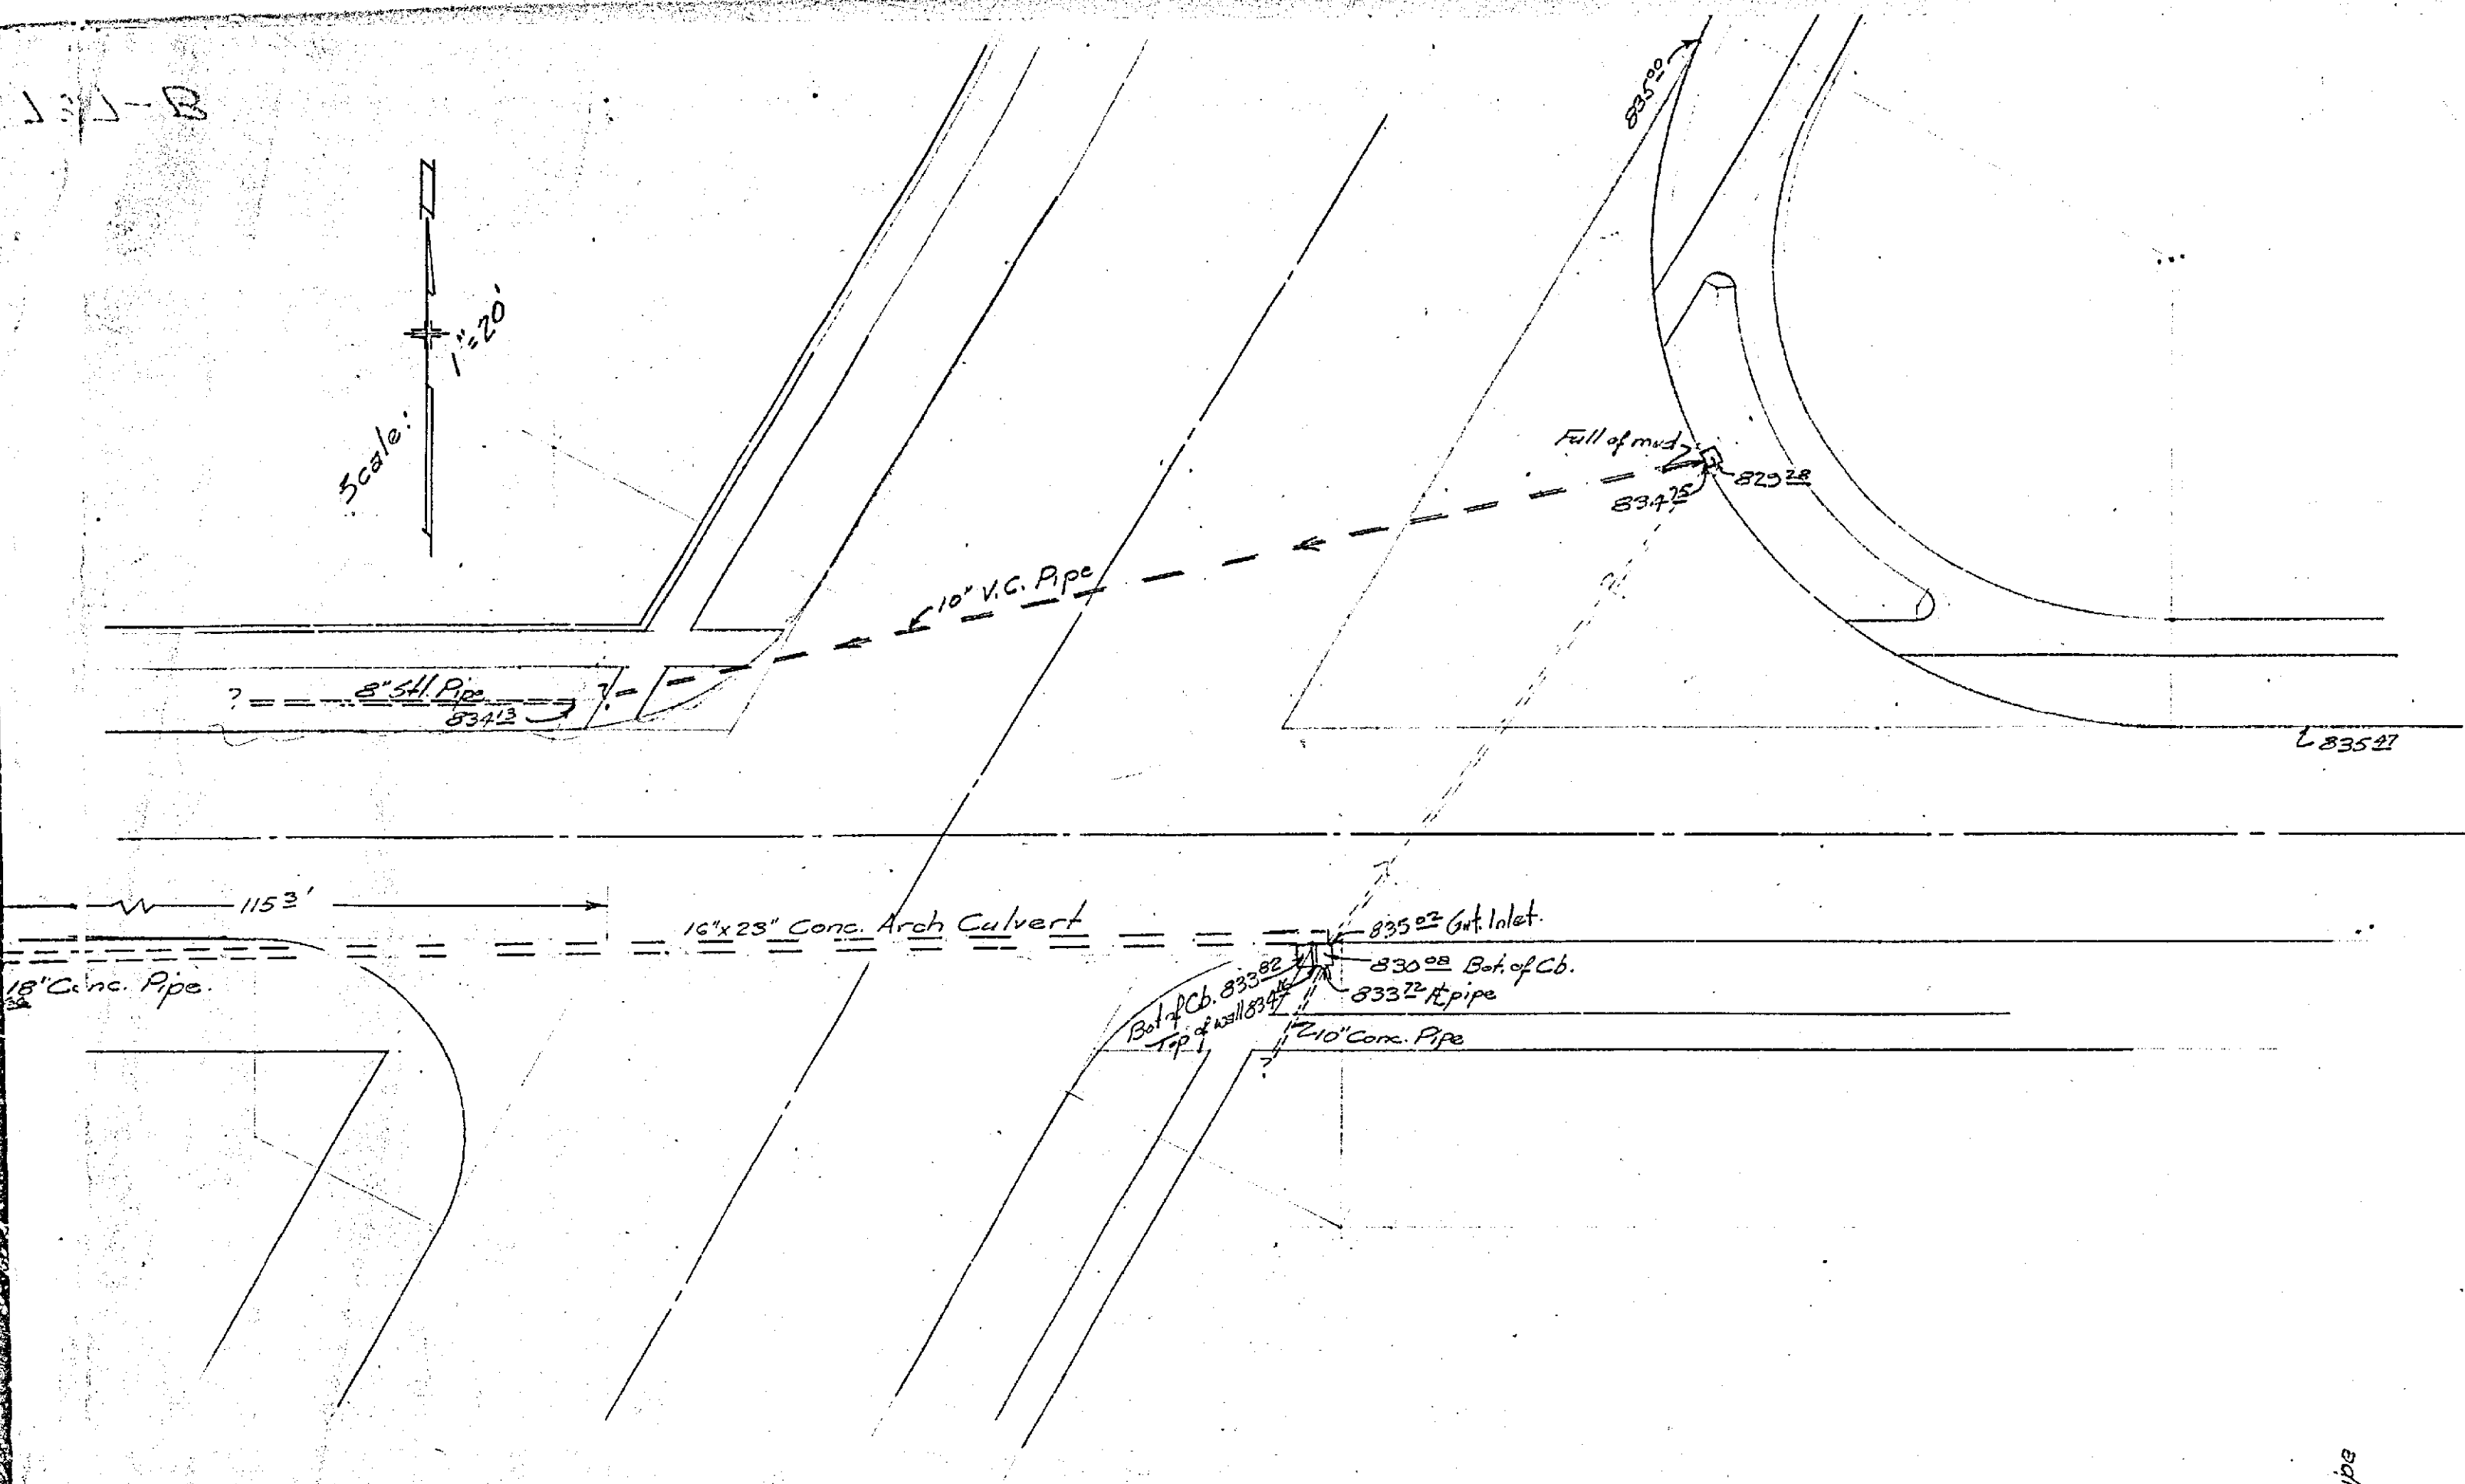

737 B