


MAP SHOWING SIDEWALK TO BE CONSTRUCTED ON
MARKET ST.
 A. BRAUNSCHWEIGER, CITY ENGINEER.
 SCALE, 1 IN. = 30 FT.

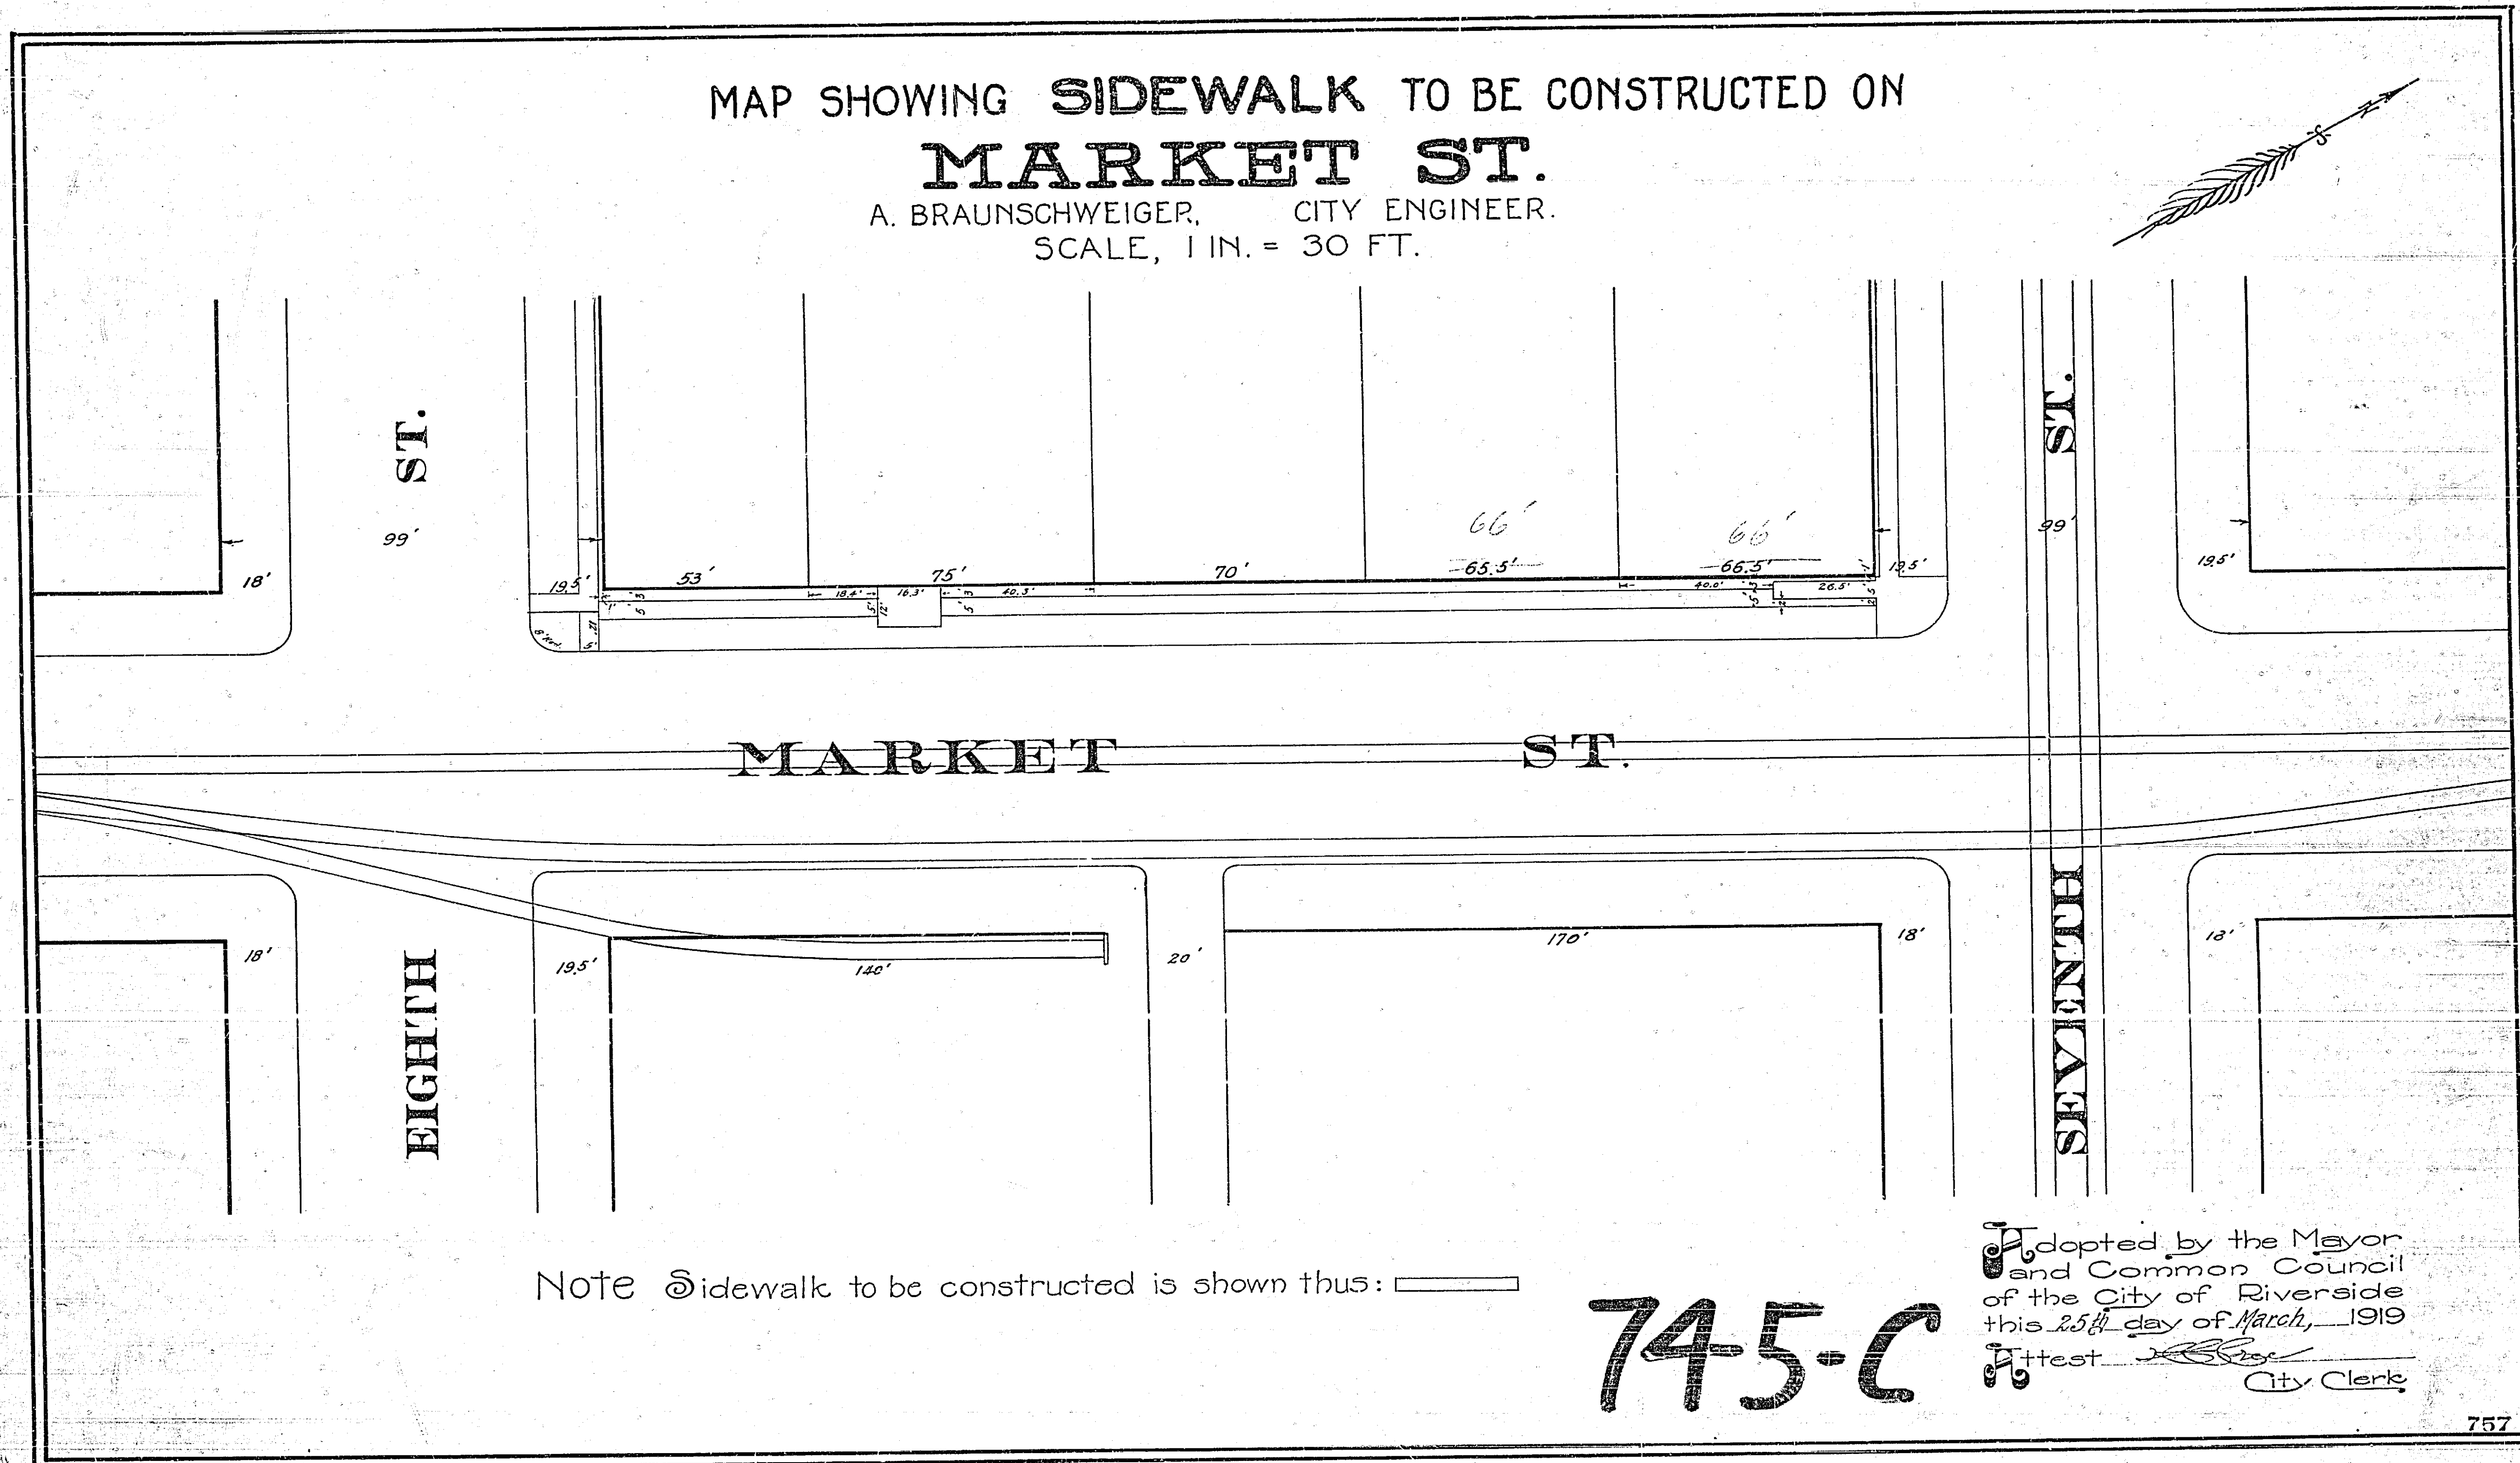

Note Sidewalk to be constructed is shown thus:

745-C

Adopted by the Mayor and Common Council of the City of Riverside this 25th day of March, 1919
 Attest _____
 City Clerk