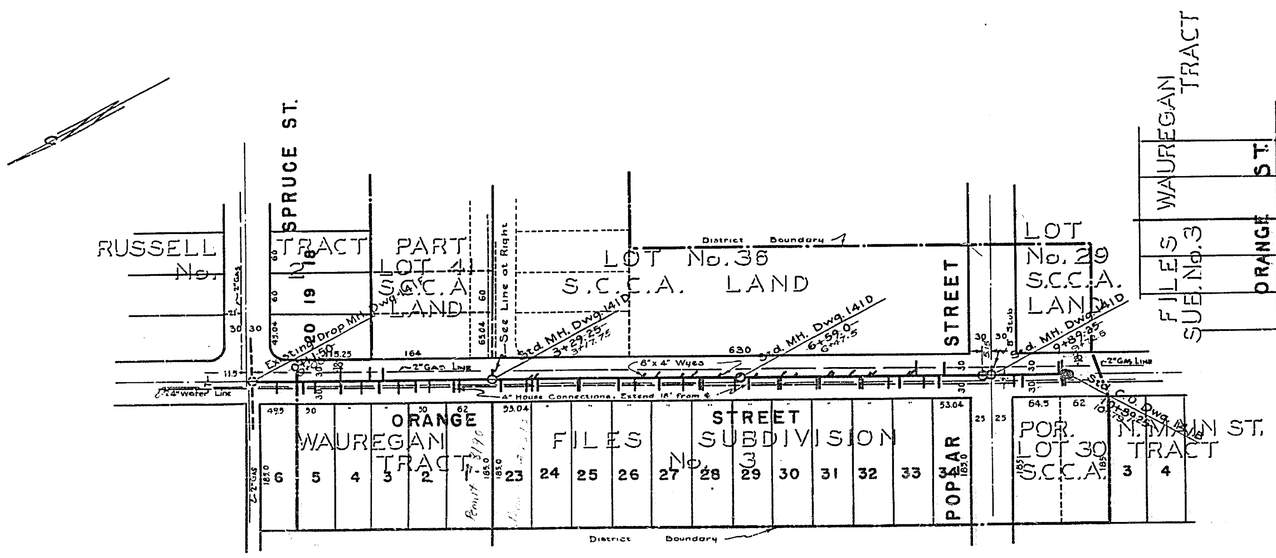

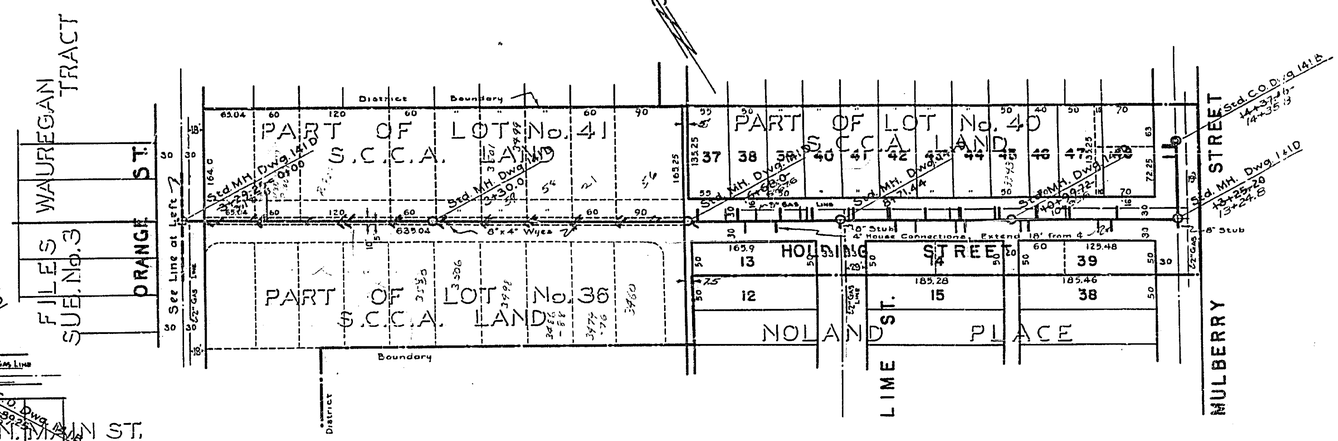

NOTE: RED LINE SHOWS CHANGE AS CONSTRUCTED. F.B. 451, PG. 3 & 38.

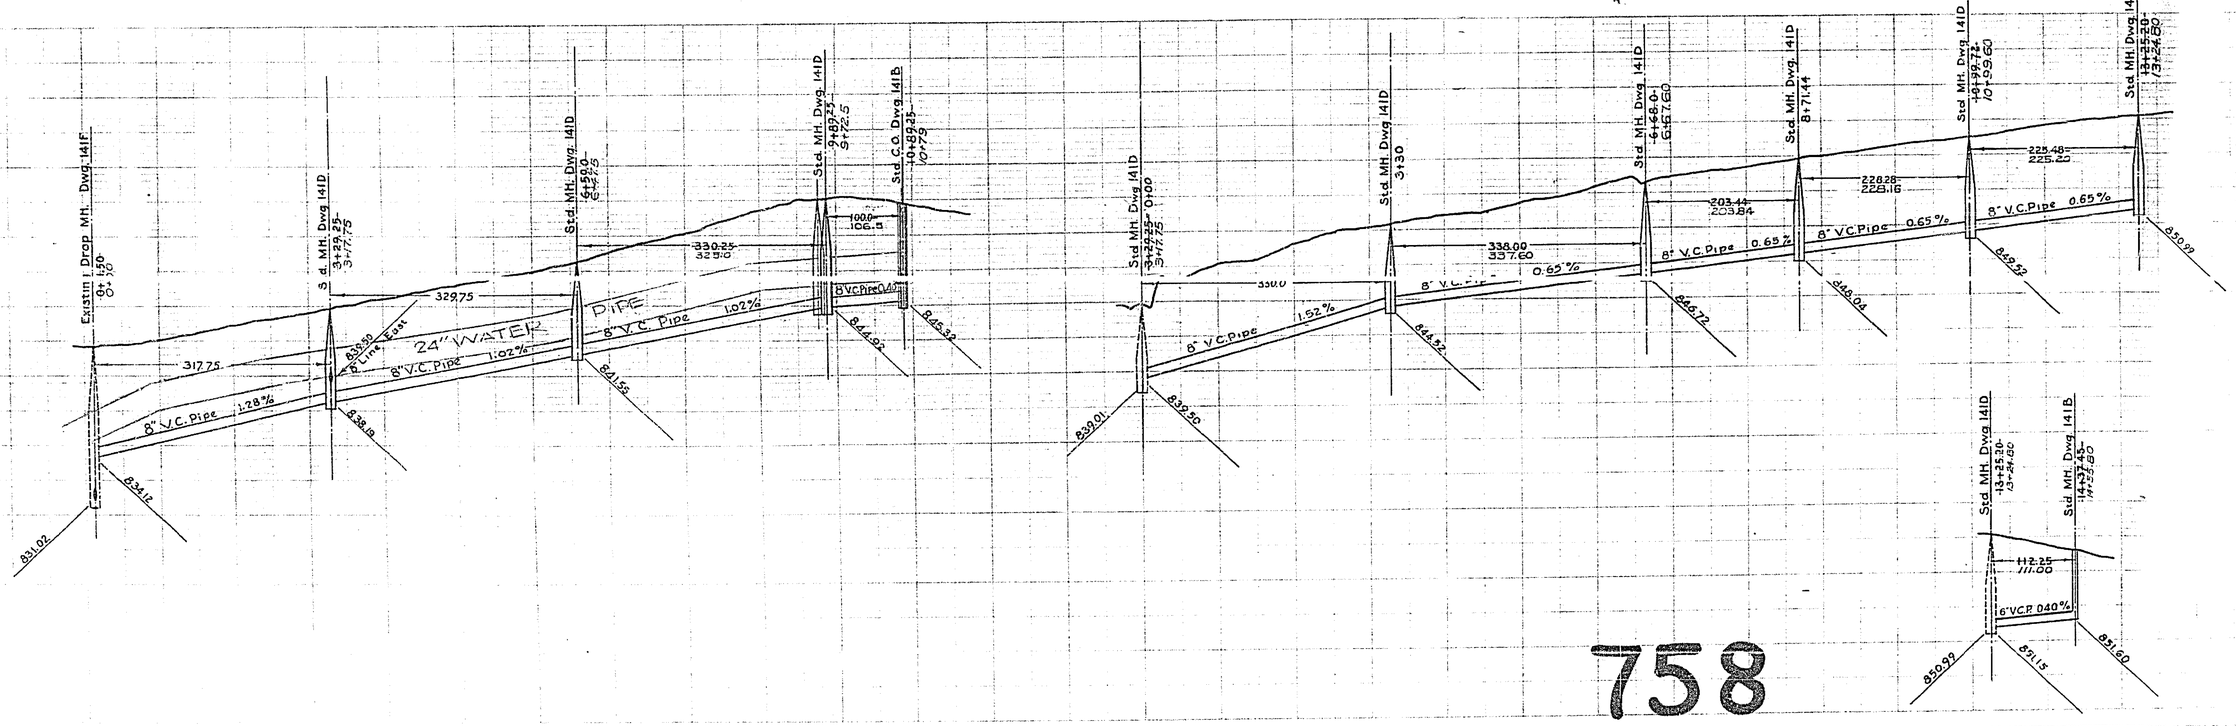

758