
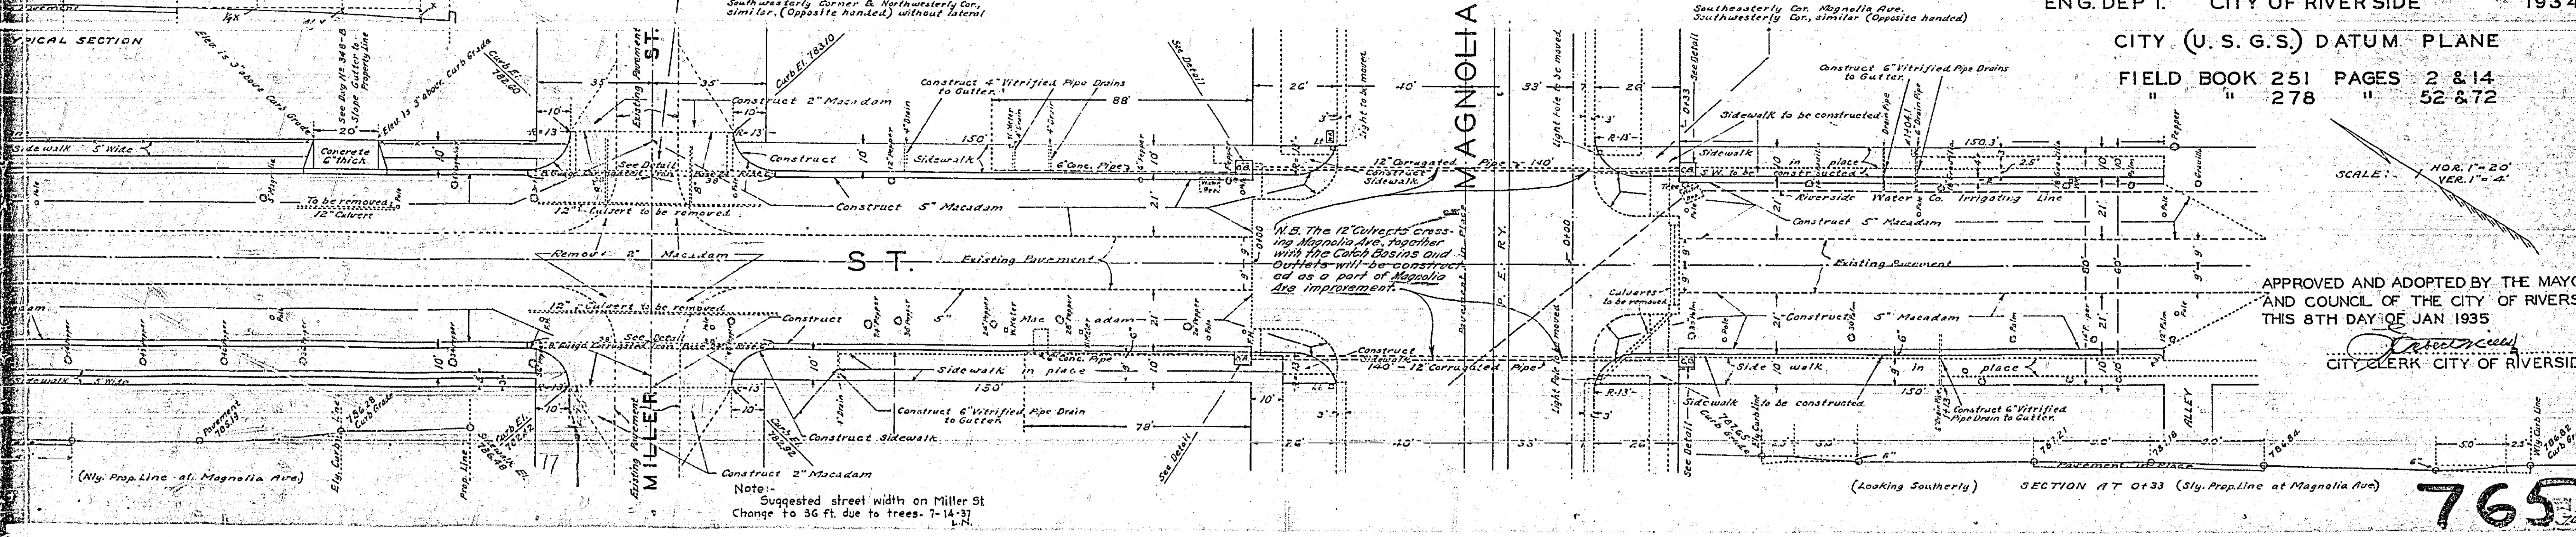
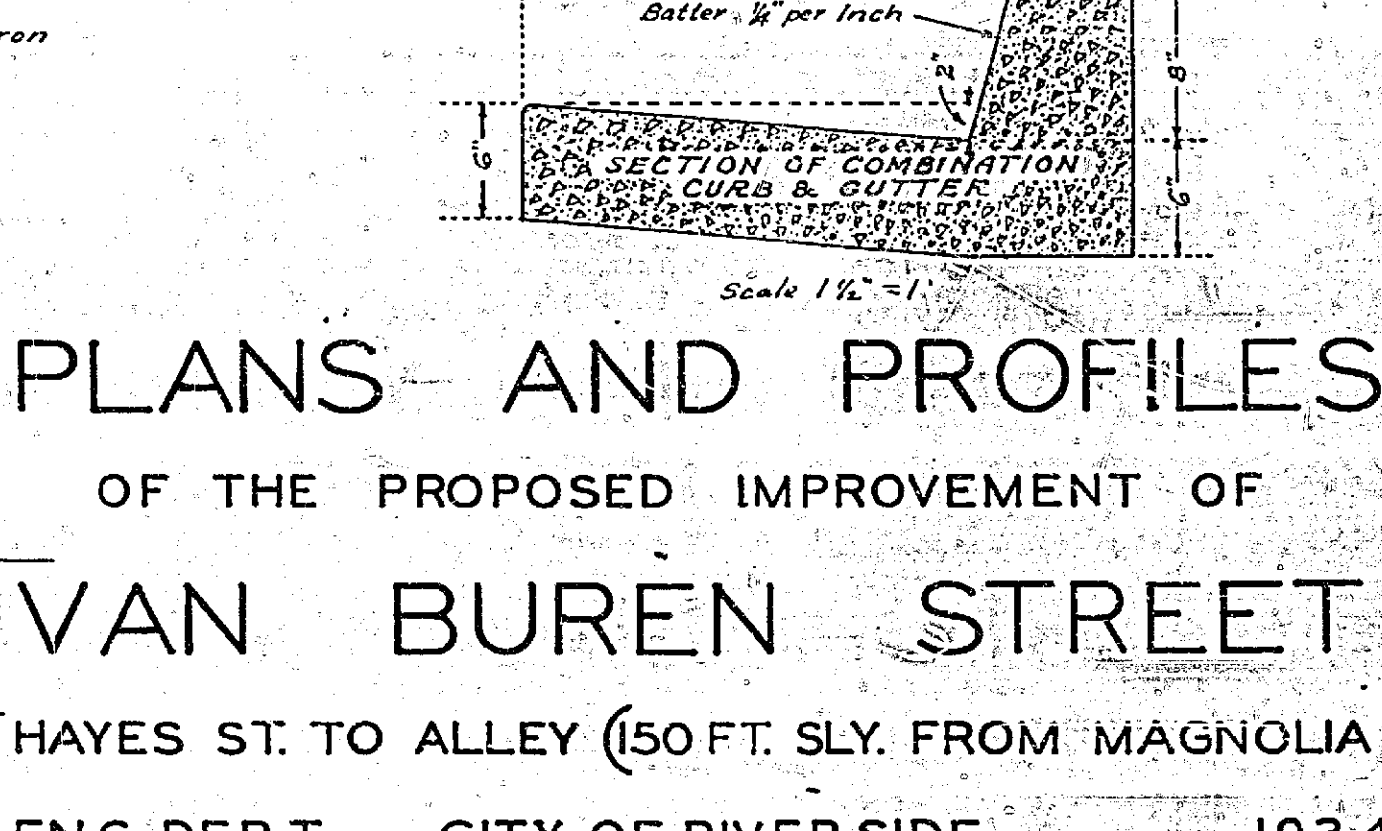
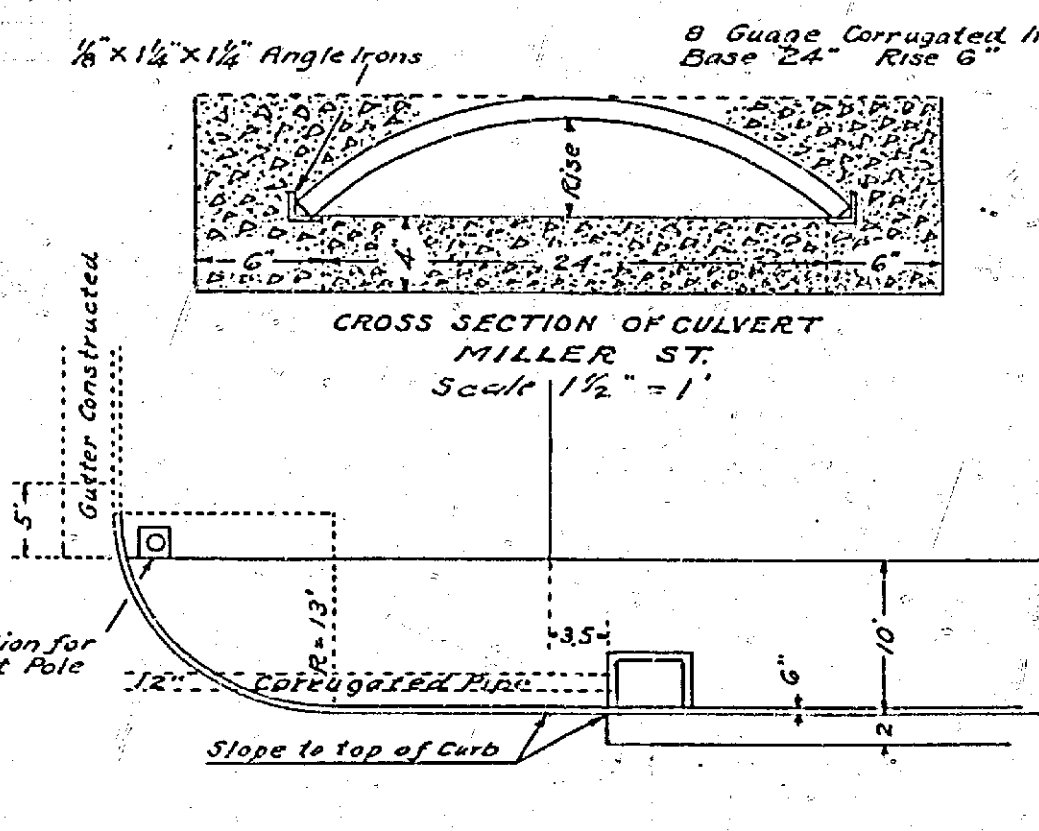
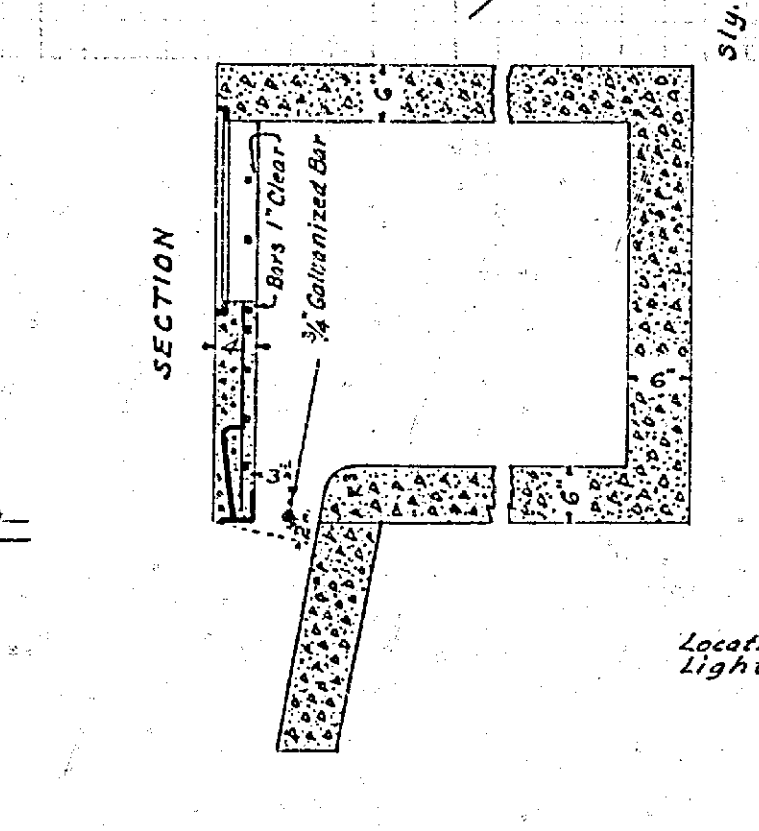
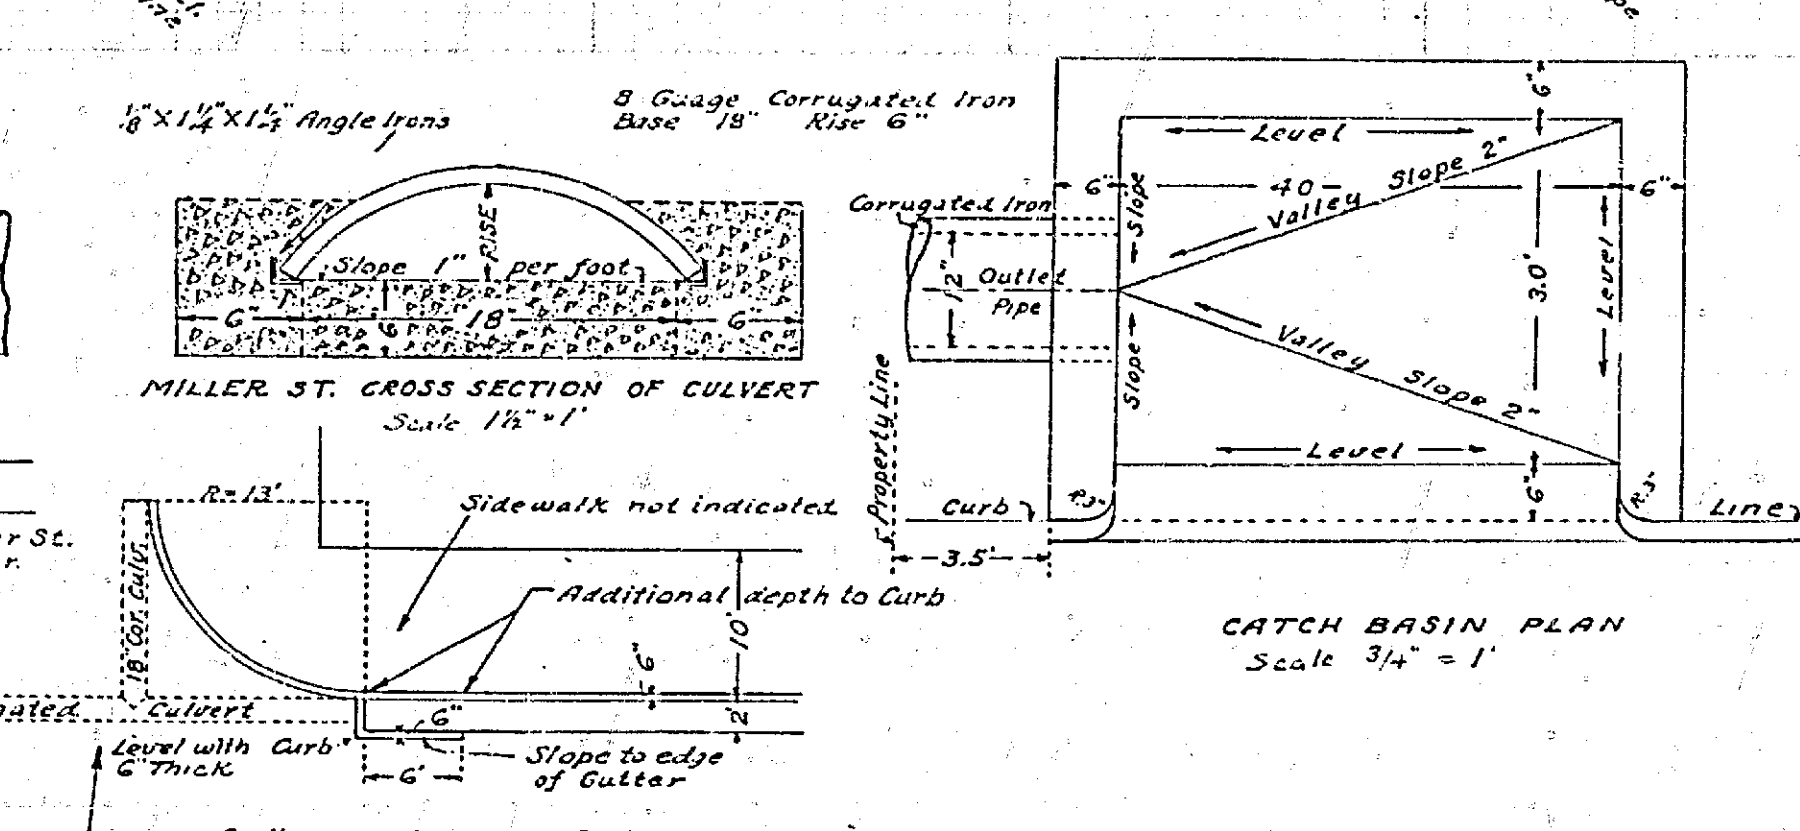
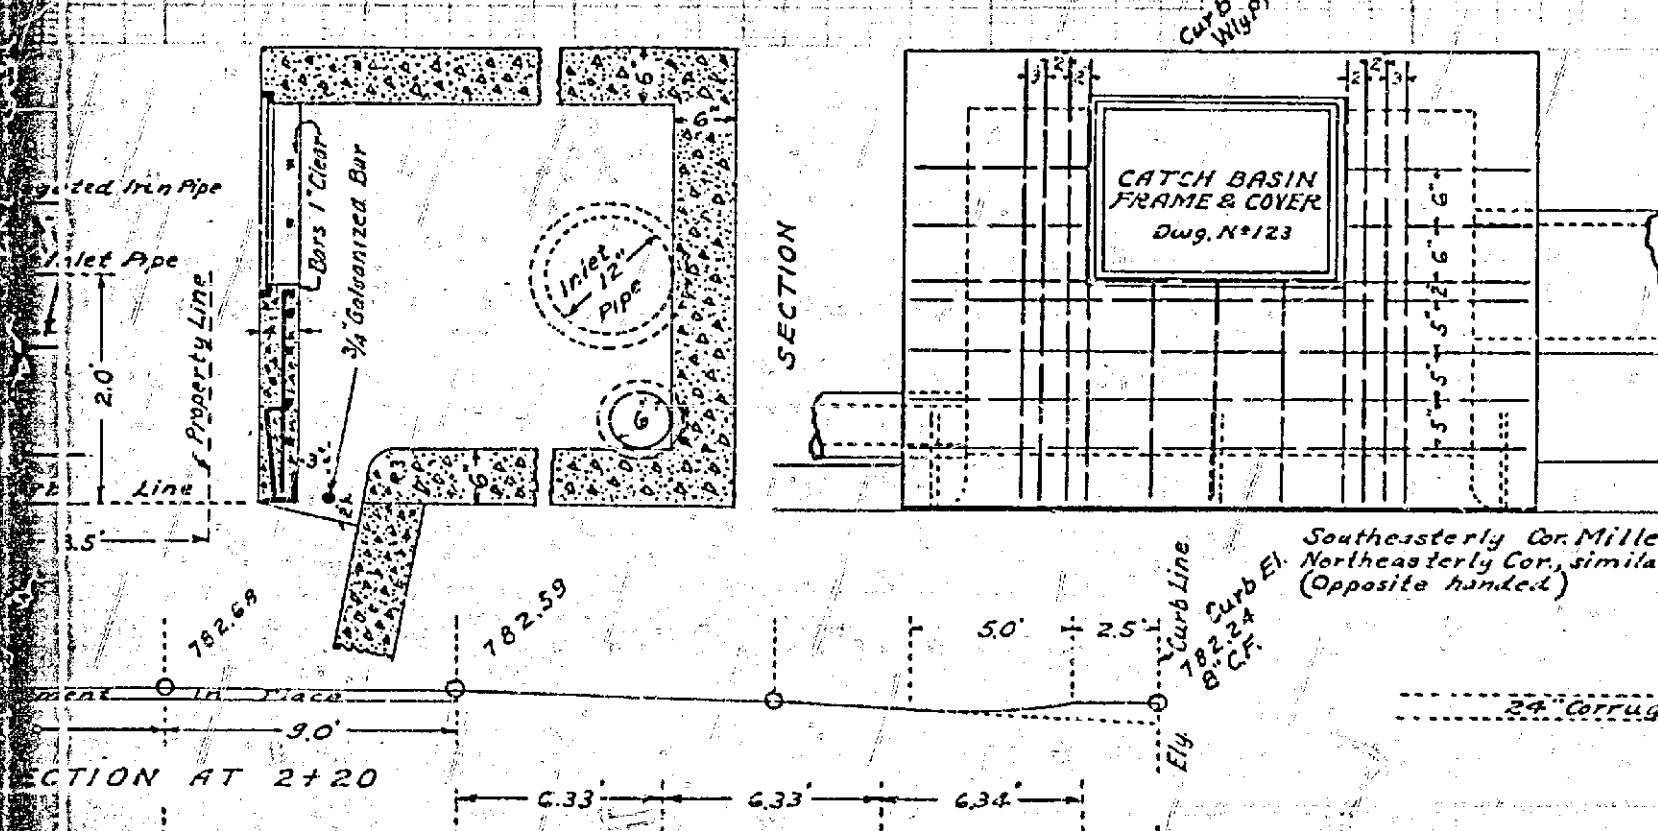


Note:- Suggested street width on Miller St Change to 36 ft. due to trees. 7-14-37 L.N.

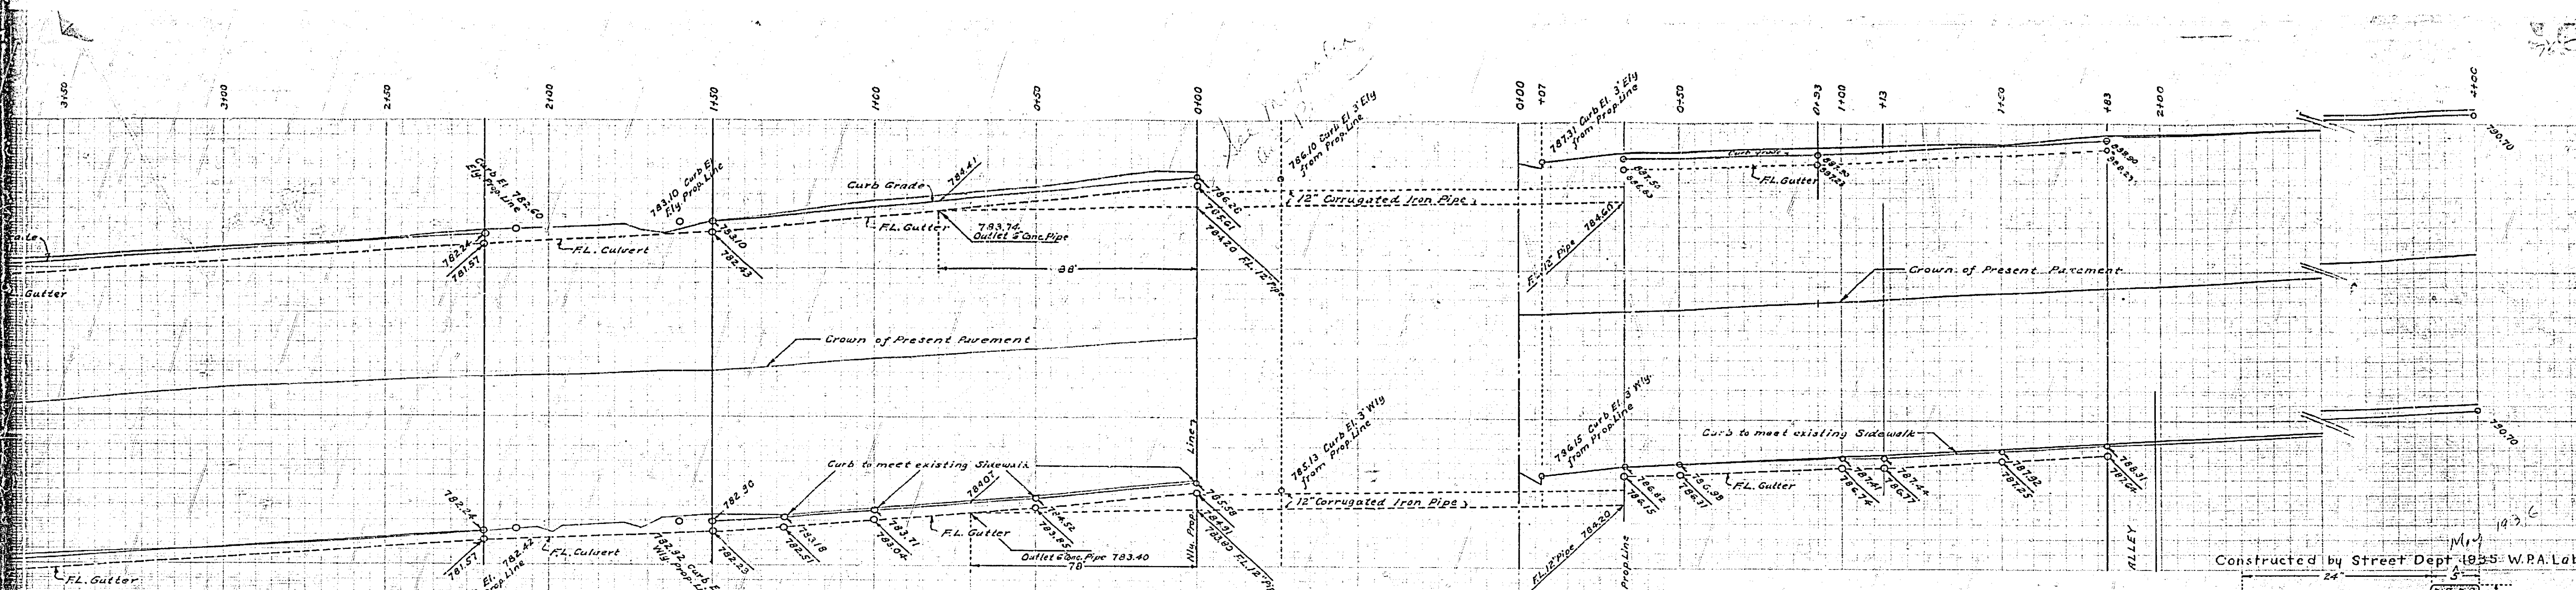

PLANS AND PROFILES
 OF THE PROPOSED IMPROVEMENT OF
VAN BUREN STREET
 HAYES ST. TO ALLEY (150 FT. SLY. FROM MAGNOLIA AV.)
 ENG. DEPT. CITY OF RIVERSIDE 1934

CITY (U. S. G. S.) DATUM PLANE
 FIELD BOOK 251 PAGES 2 & 14
 " 278 " 52 & 72

SCALE: HOR. 1" = 20'
 VER. 1" = 4'

APPROVED AND ADOPTED BY THE MAYOR
 AND COUNCIL OF THE CITY OF RIVERSIDE
 THIS 8TH DAY OF JAN 1935

CITY CLERK CITY OF RIVERSIDE