

PLANS AND PROFILES

OF THE PROPOSED IMPROVEMENT OF


CEDAR STREET

APPROVED AND ADOPTED BY THE MAYOR
AND COUNCIL OF THE CITY OF RIVERSIDE
THIS 15TH DAY OF JANUARY 1935



[Signature]
CITY CLERK, CITY OF RIVERSIDE.

BETWEEN EIGHTH STREET AND TENTH STREET

ENG. DEPT. CITY OF RIVERSIDE

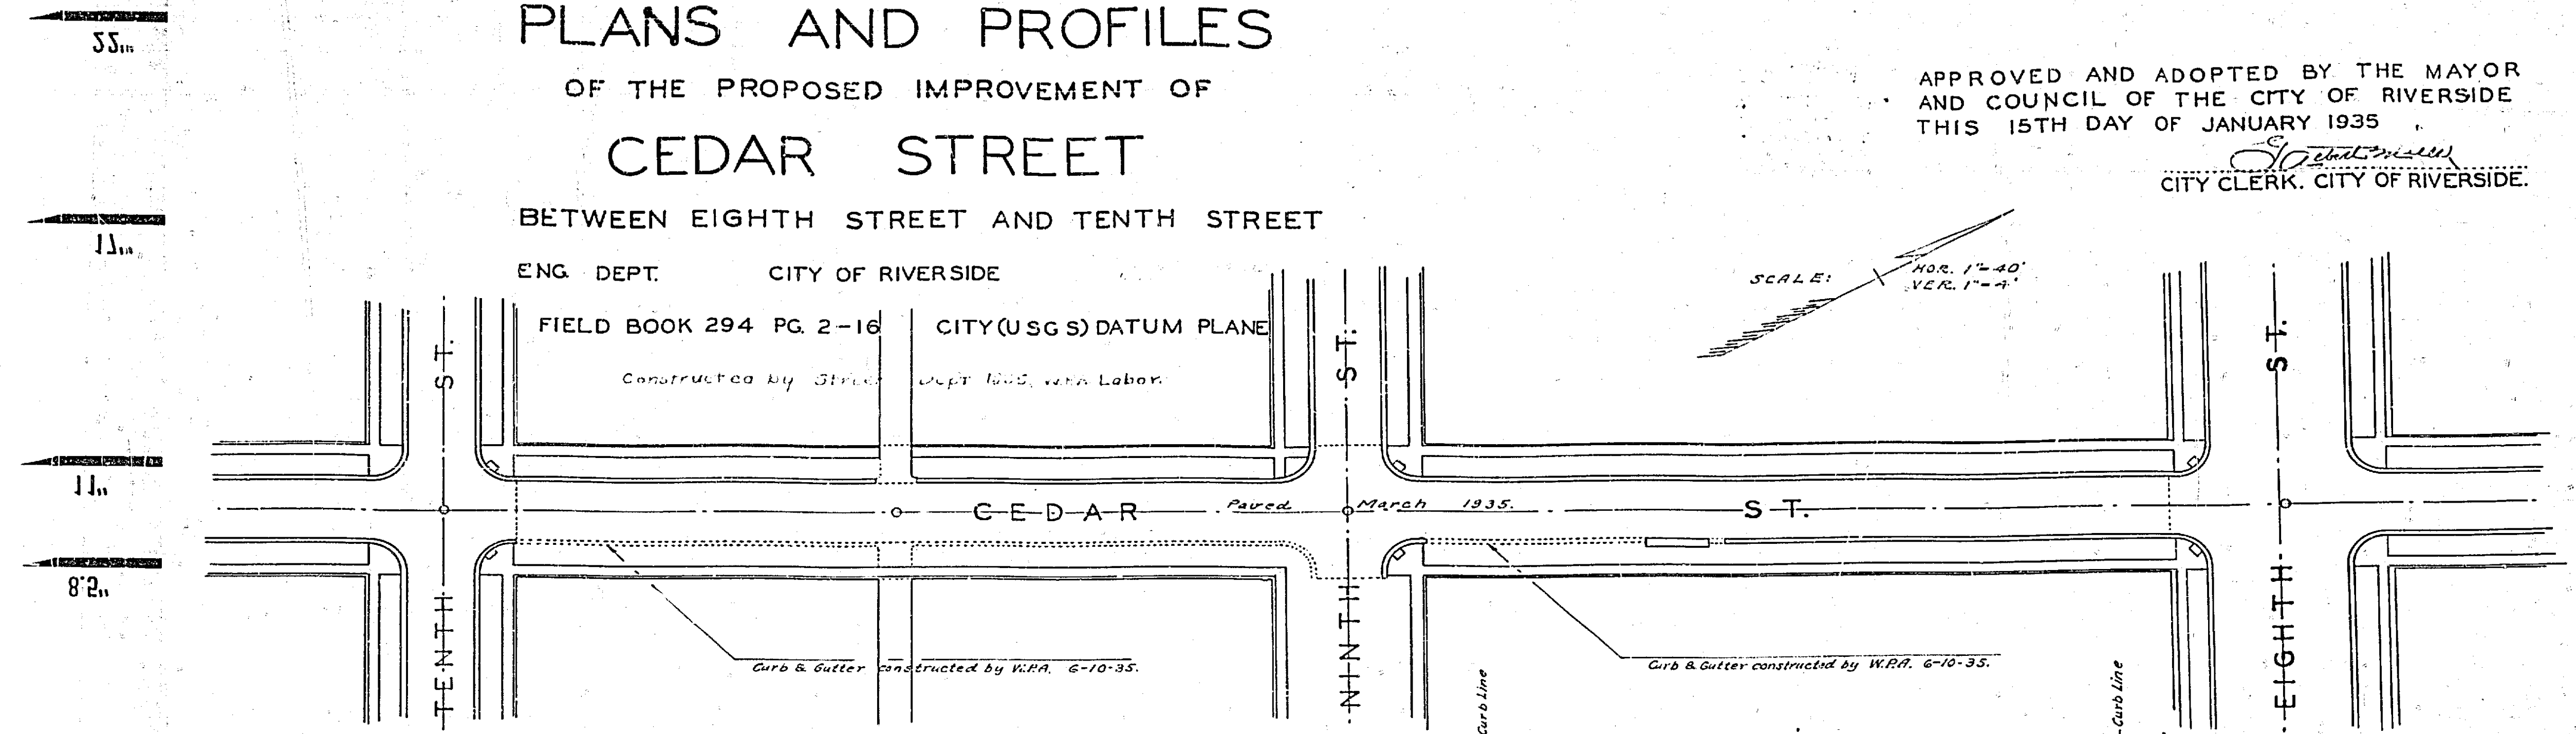

SCALE: HOR. 1"=40'
VER. 1"=4'

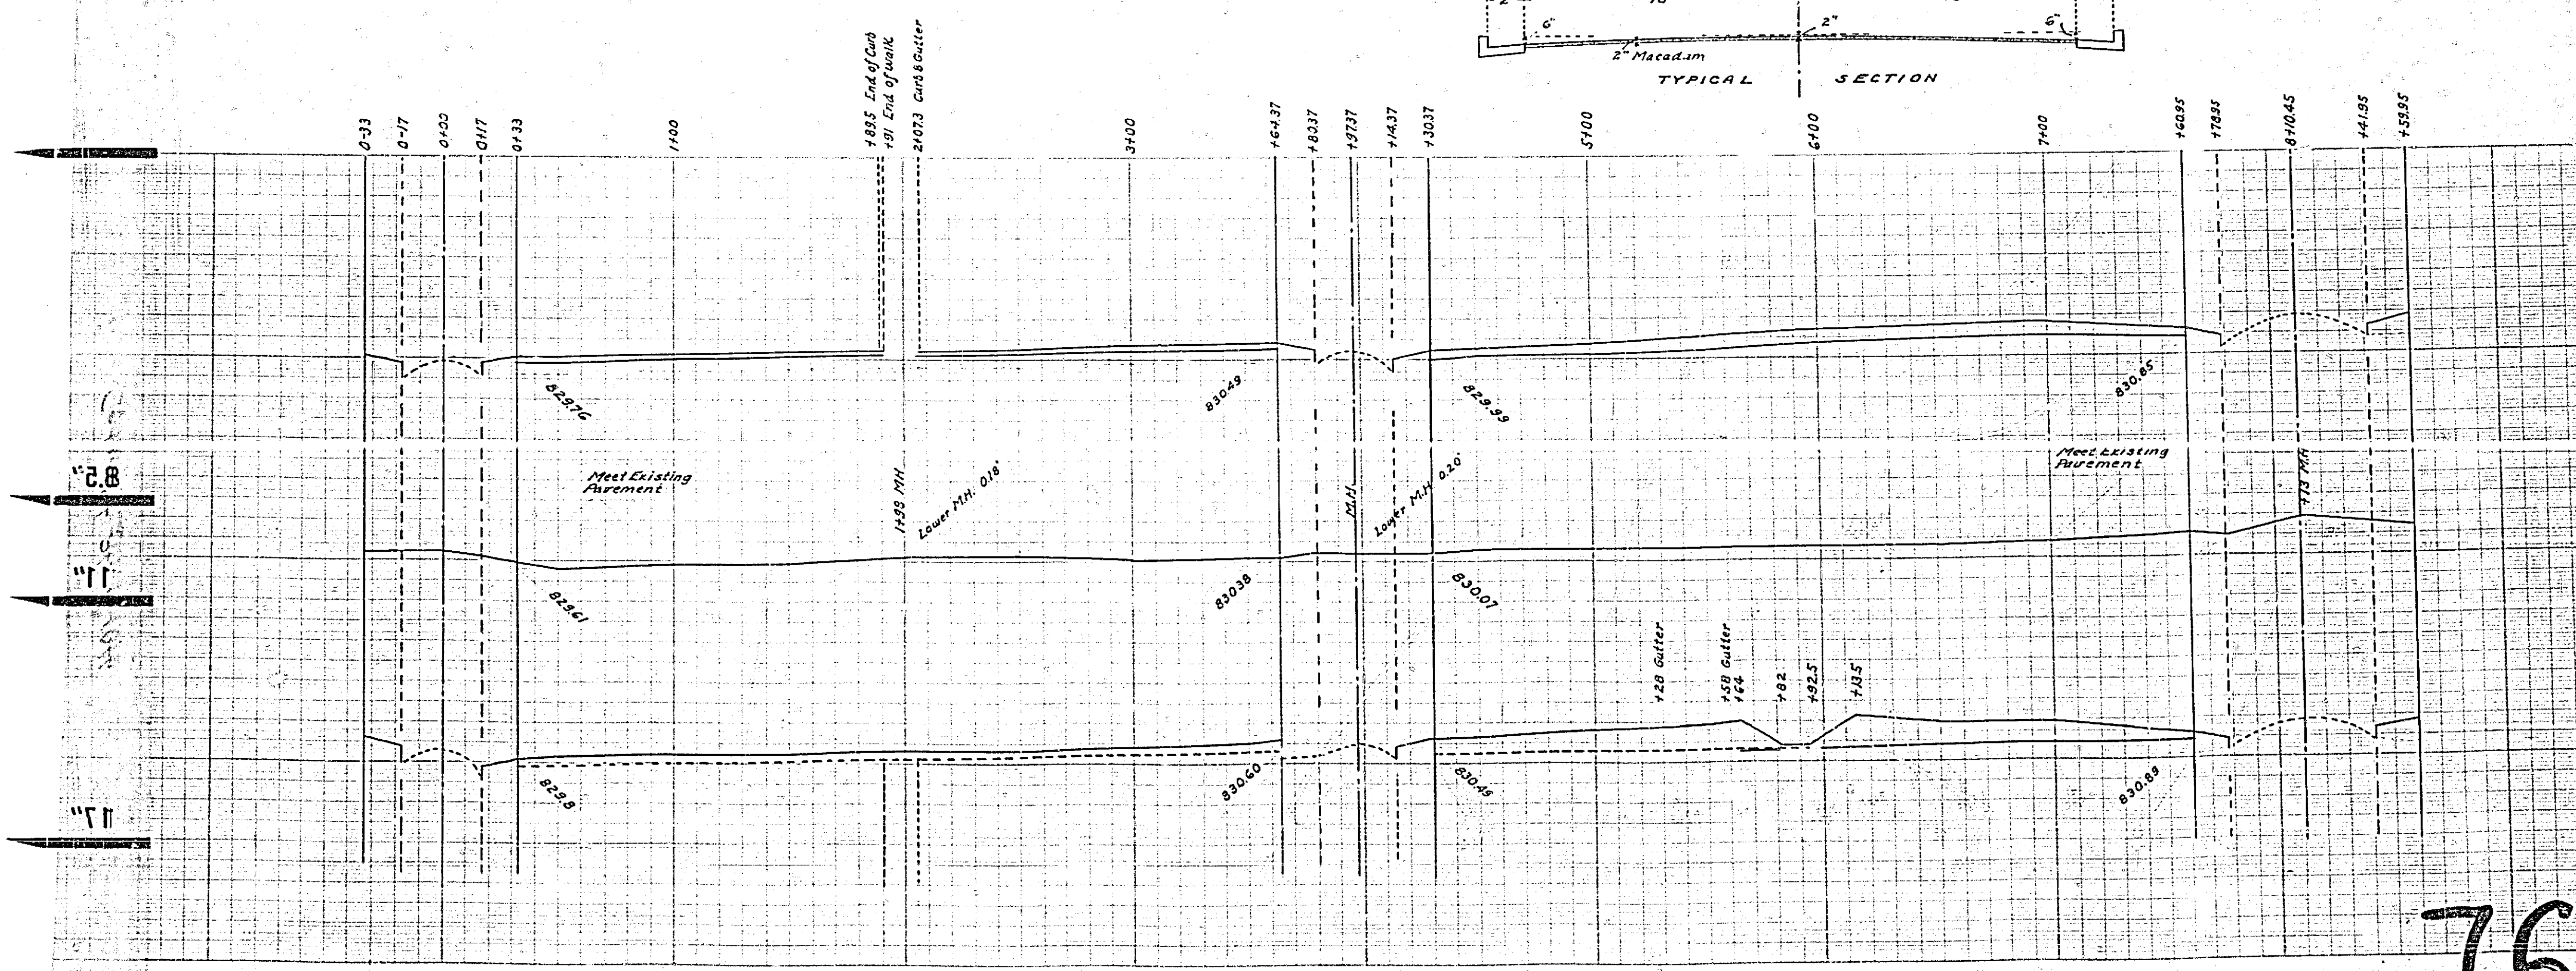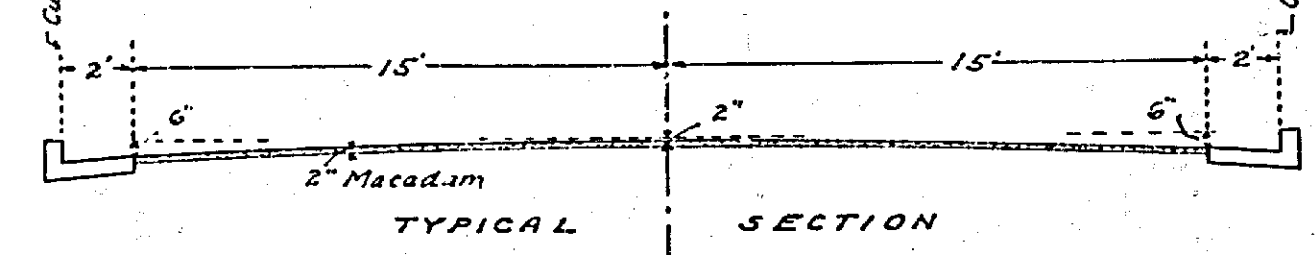

767