



Fourth St. Lemon to Lime

PROFILE

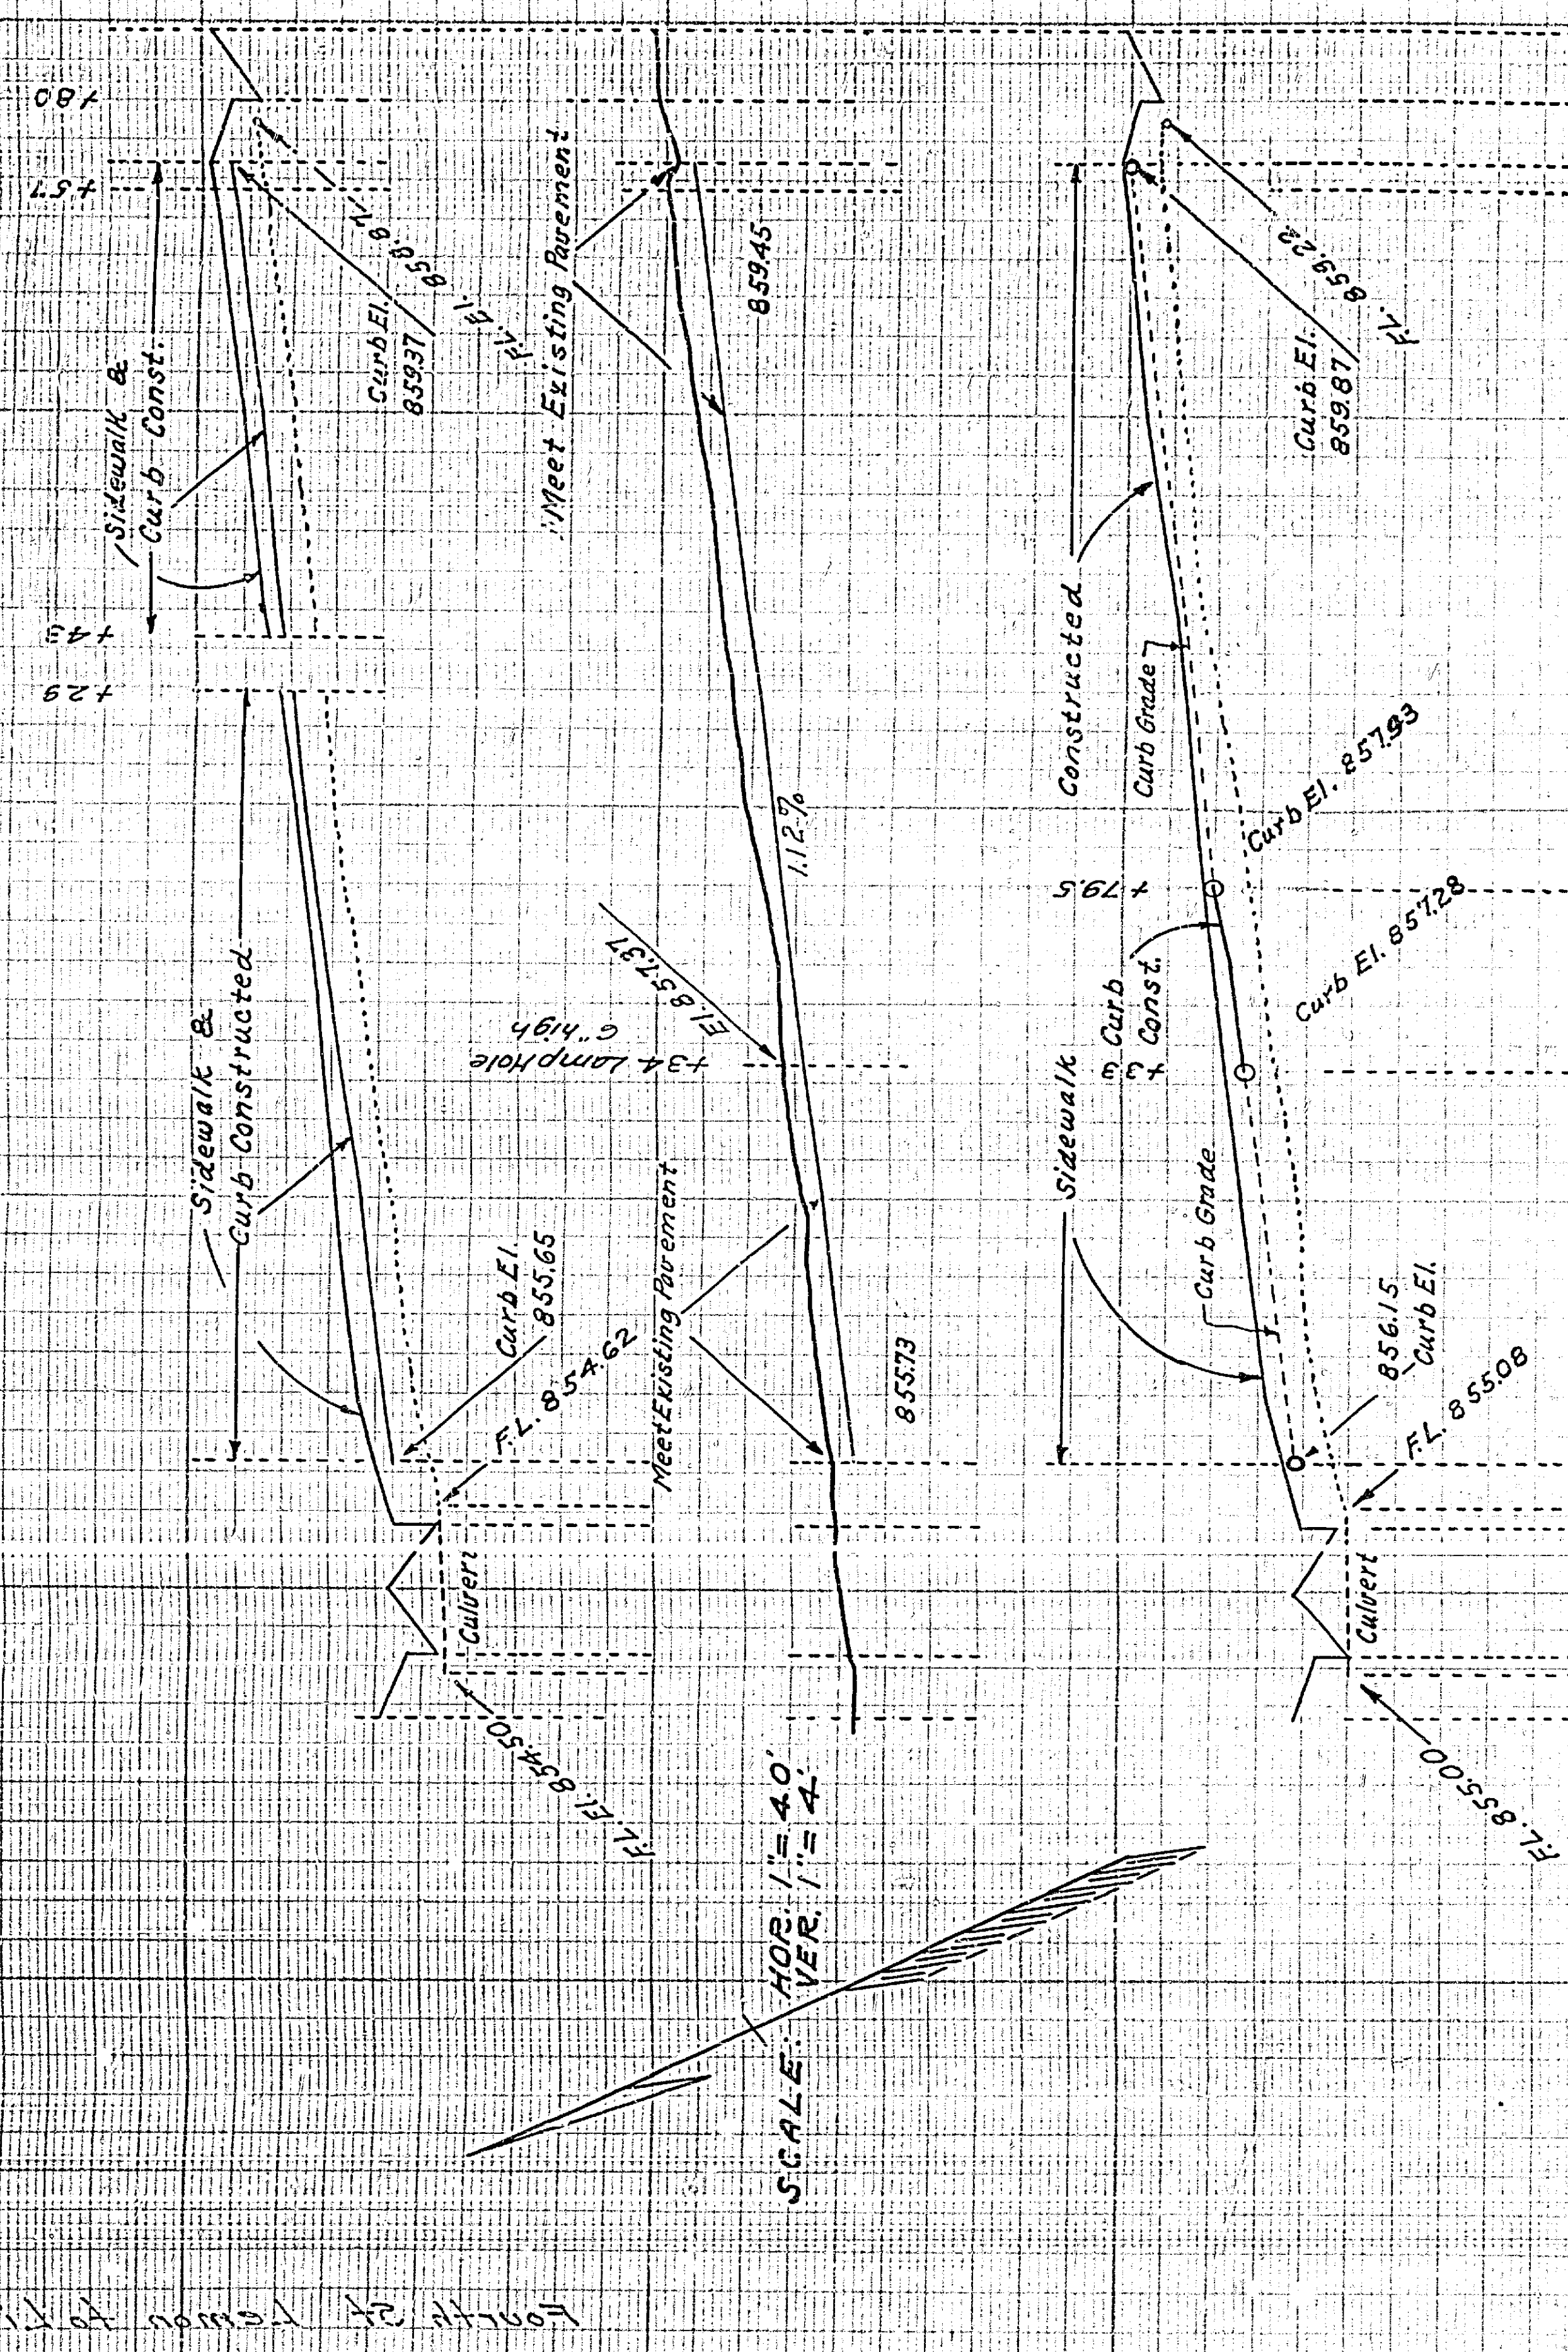

SCALE: HOR. 1" = 40'
VER. 1" = 4'

PLAN

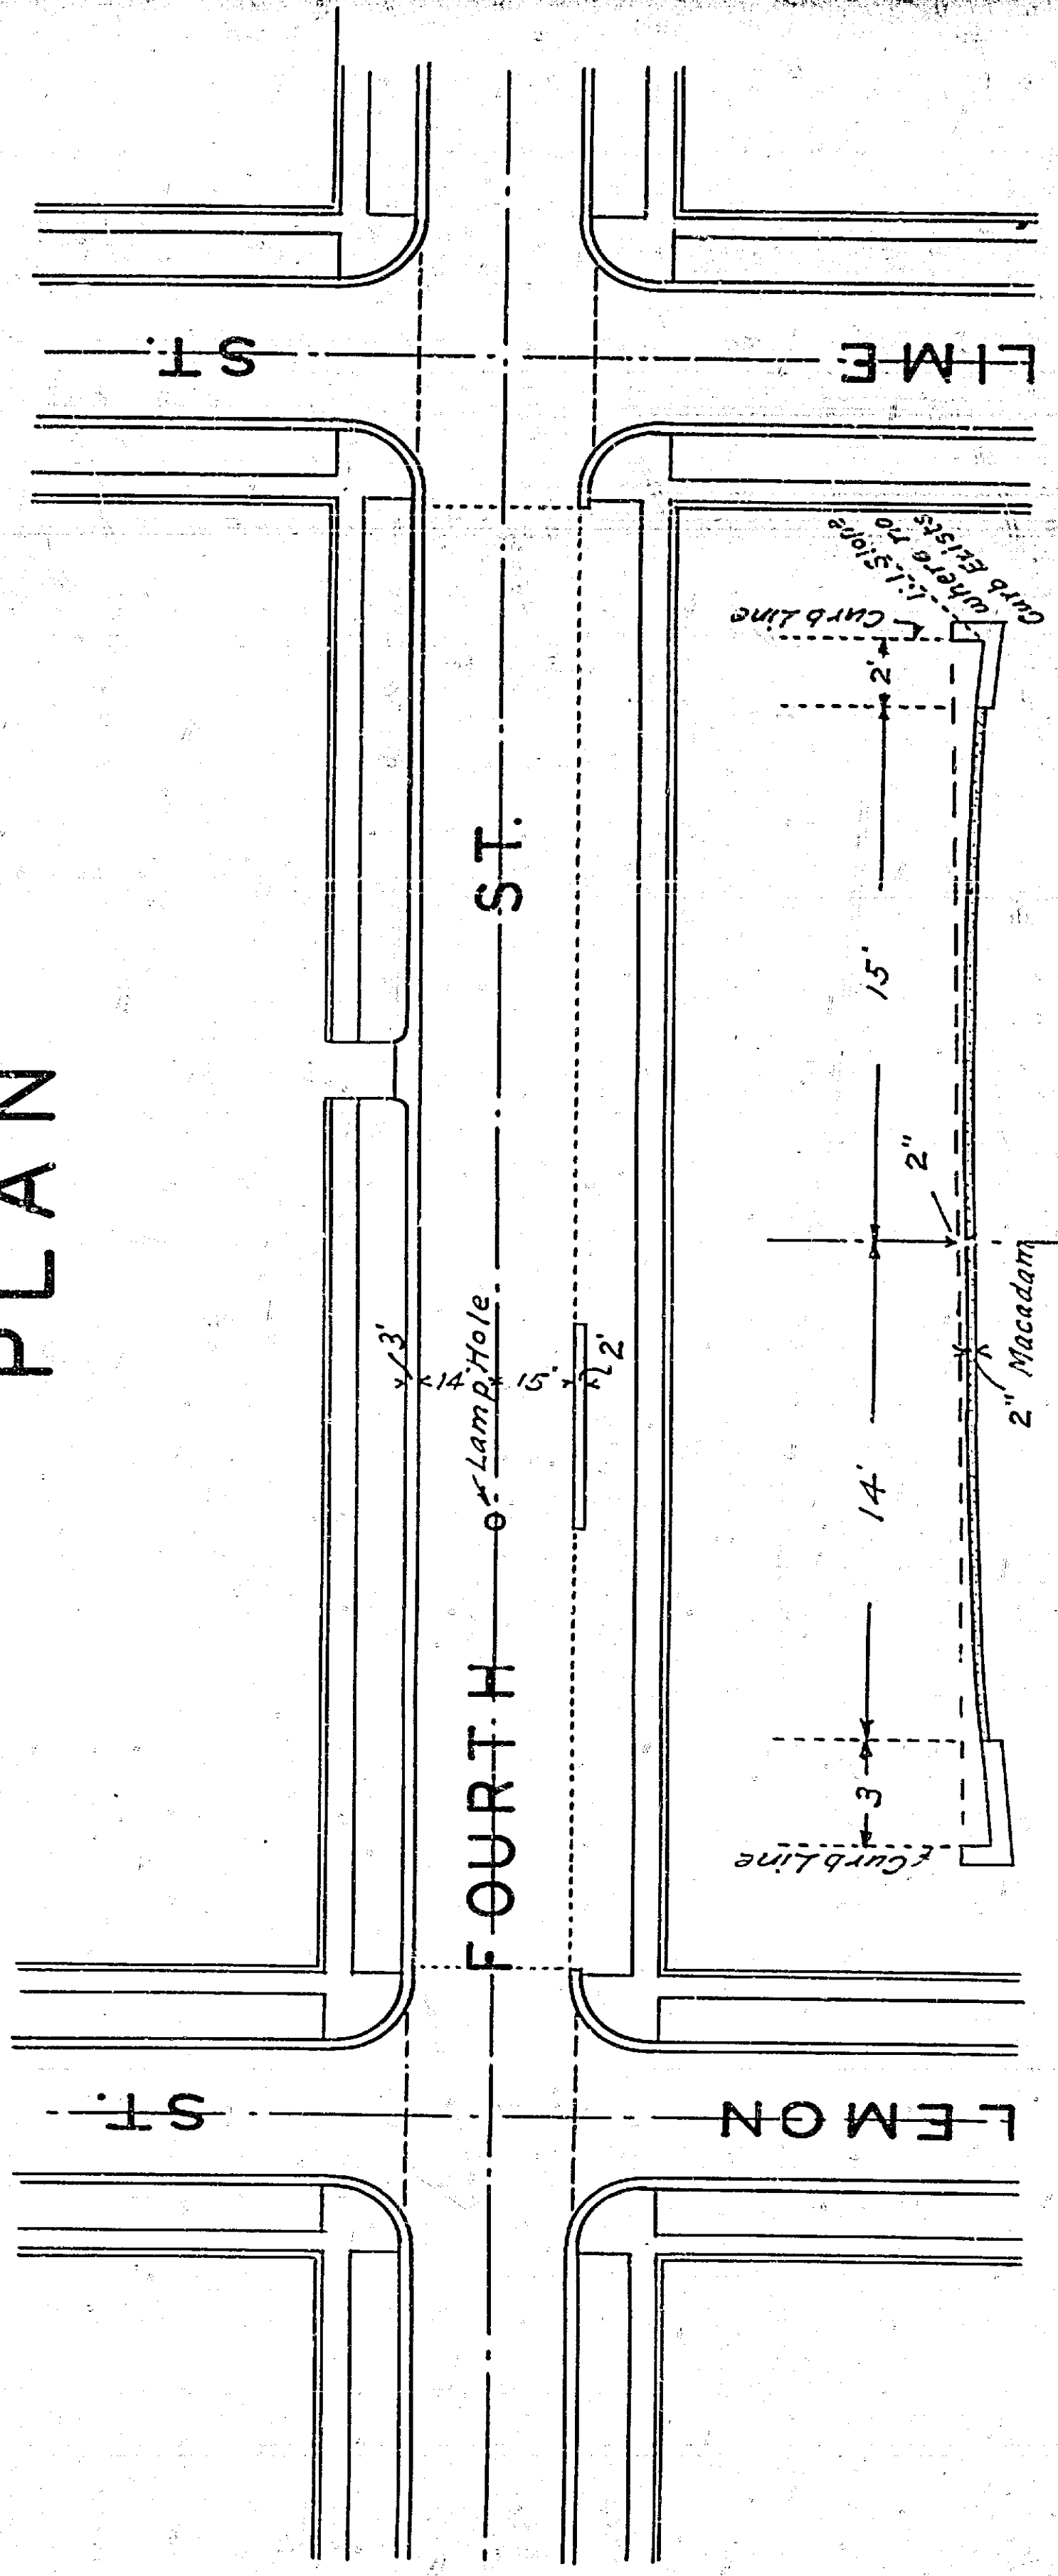

TYPICAL SECTION

PLAN AND PROFILE

OF THE PROPOSED STREET IMPROVEMENT OF

FOURTH STREET

BETWEEN LEMON ST. AND LIME STREET

Constructed by Street Dept. 1935.

WPA Labor.

784

FIELD BOOK 293 PAGES 23-30

CITY (U. S. G. S.) DATUM PLANE

APPROVED AND ADOPTED BY THE MAYOR AND COUNCIL OF THE CITY OF RIVERSIDE THIS 15TH DAY OF JAN. 1935

ENG. DEPT. RIVERSIDE CALIF. 1934.

Robert McClell
CITY CLERK, CITY OF RIVERSIDE.

1"

8.5"

8.5"

1"

17"