


Constructed by Street Dept. 1935 W.P.A. Labor

PLANS AND PROFILES

OF THE PROPOSED IMPROVEMENT OF

ALLEY

VICTORIA PLACE (SUBDIVISION)
 ENG. DEPT. CITY OF RIVERSIDE 1934
 CITY (U. S. G. S.) DATUM PLANE
 FIELD BOOK 290 PAGES 48-50

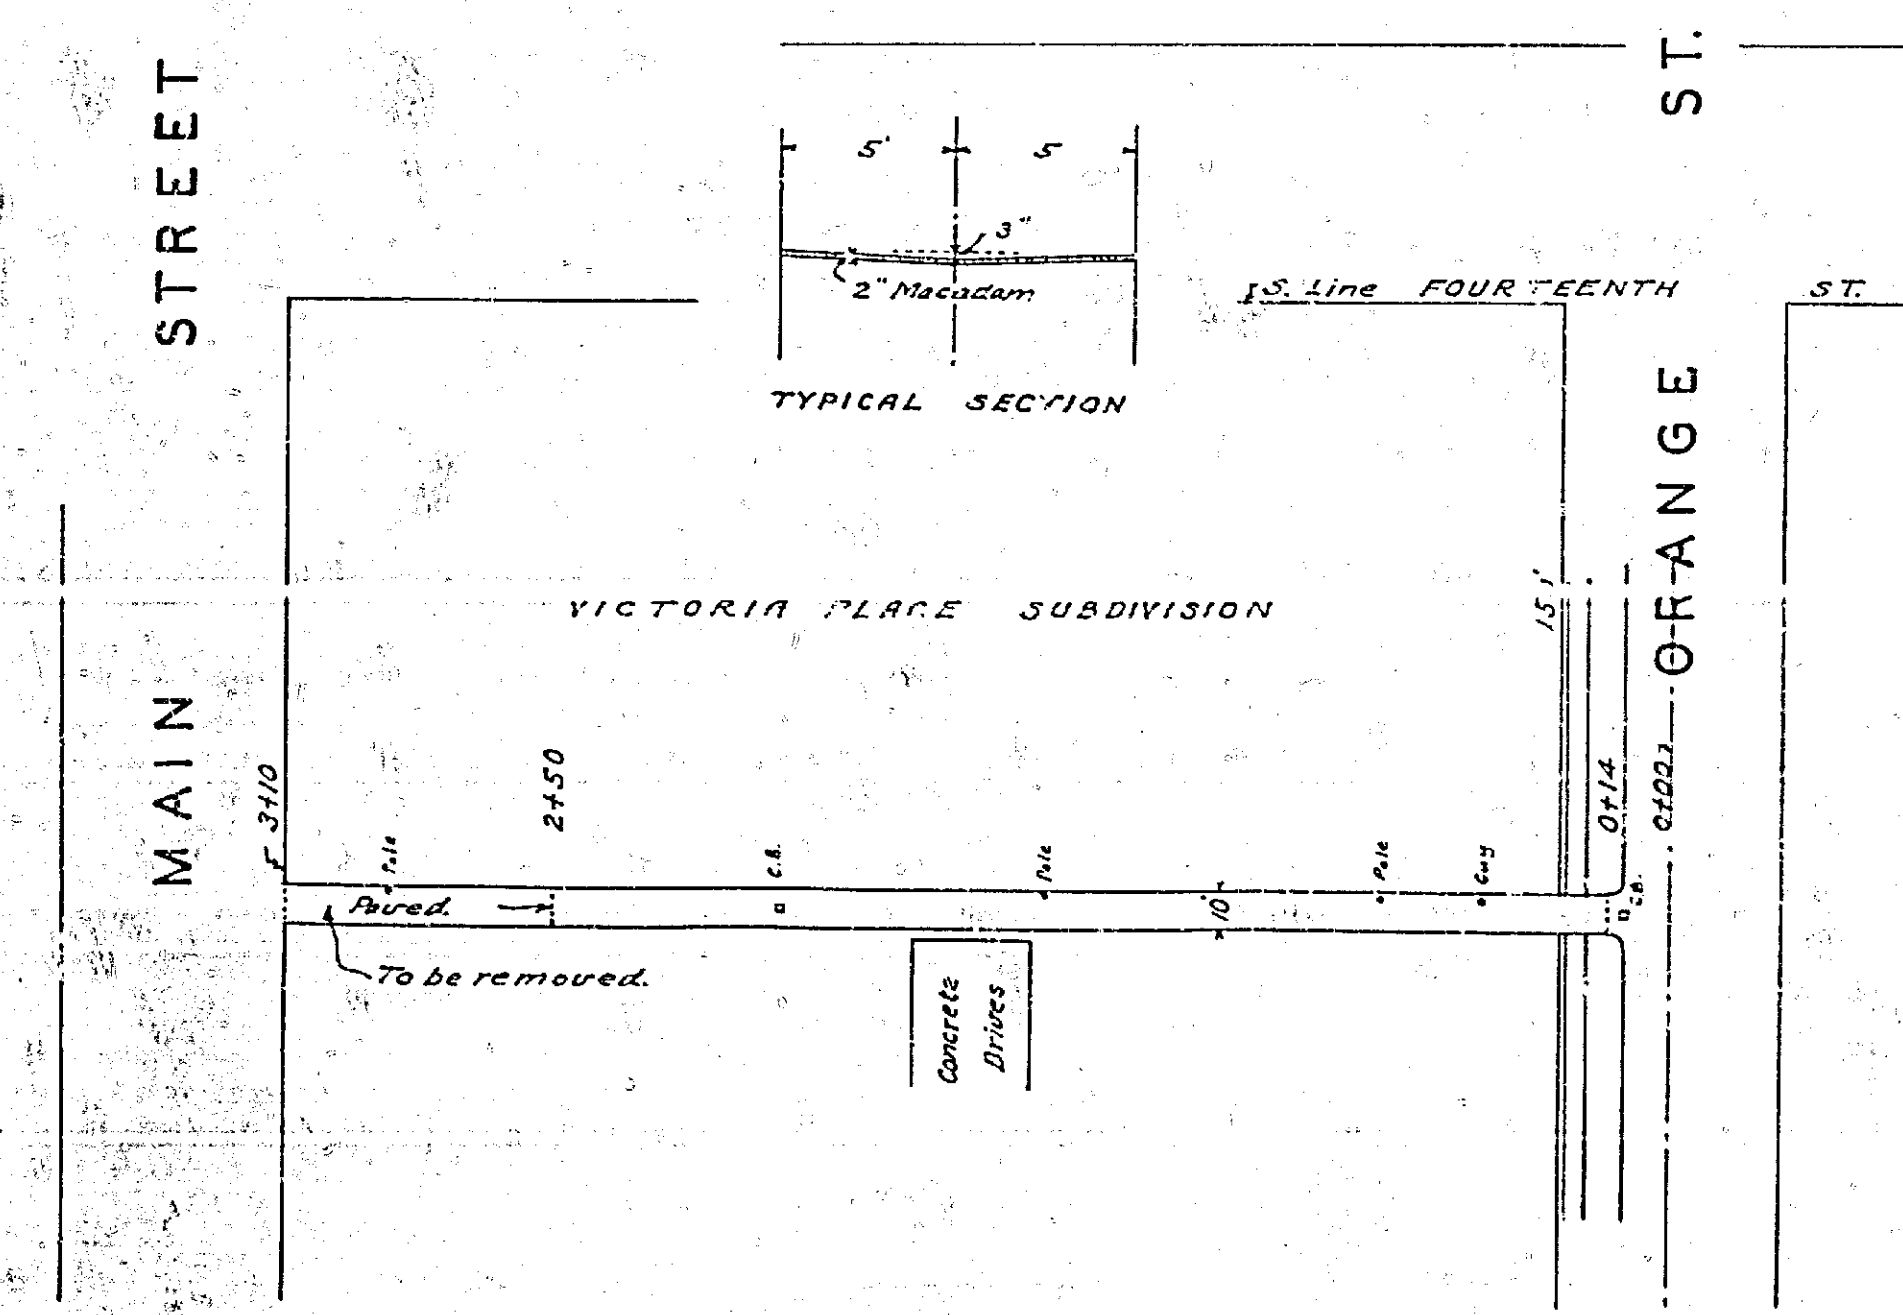

SCALE: HOR. 1" = 40'
 VER. 1" = 4'

793

APPROVED AND ADOPTED BY THE MAYOR
 AND COUNCIL OF THE CITY OF RIVERSIDE
 THIS 15TH DAY OF JANUARY 1935

Stanford
 CITY CLERK, CITY OF RIVERSIDE.