Profile 1" = 40' Hor.

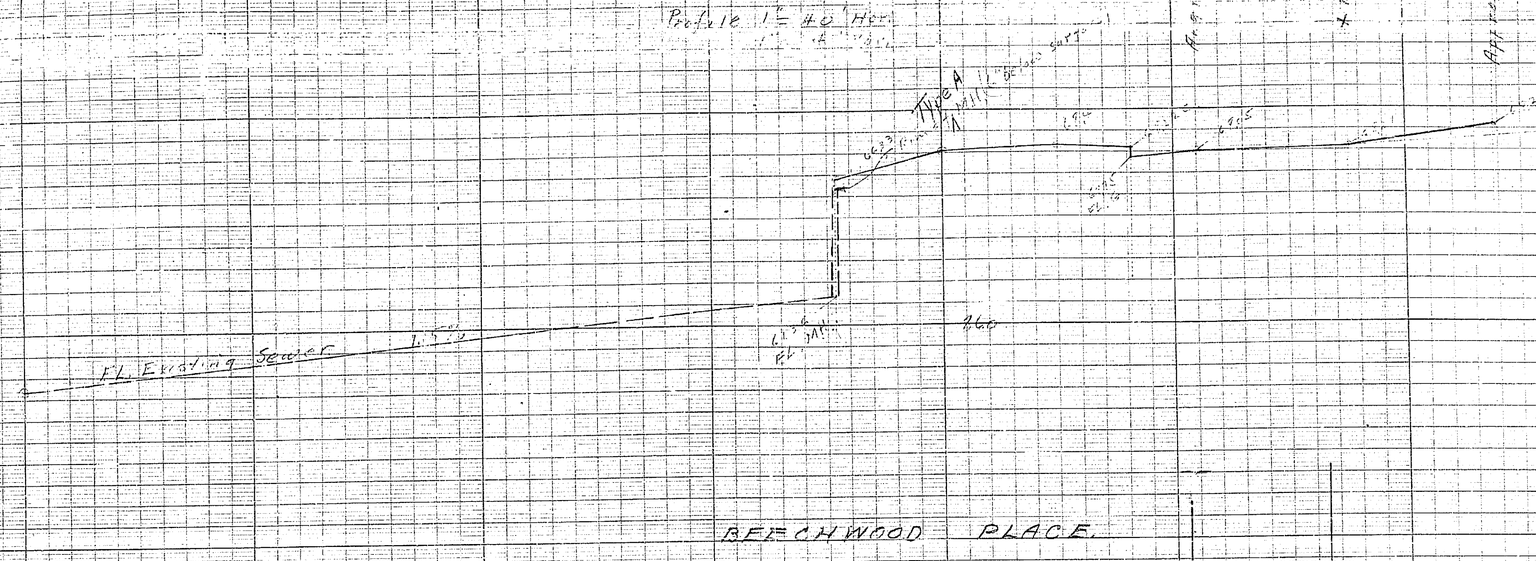

BEECHWOOD PLACE

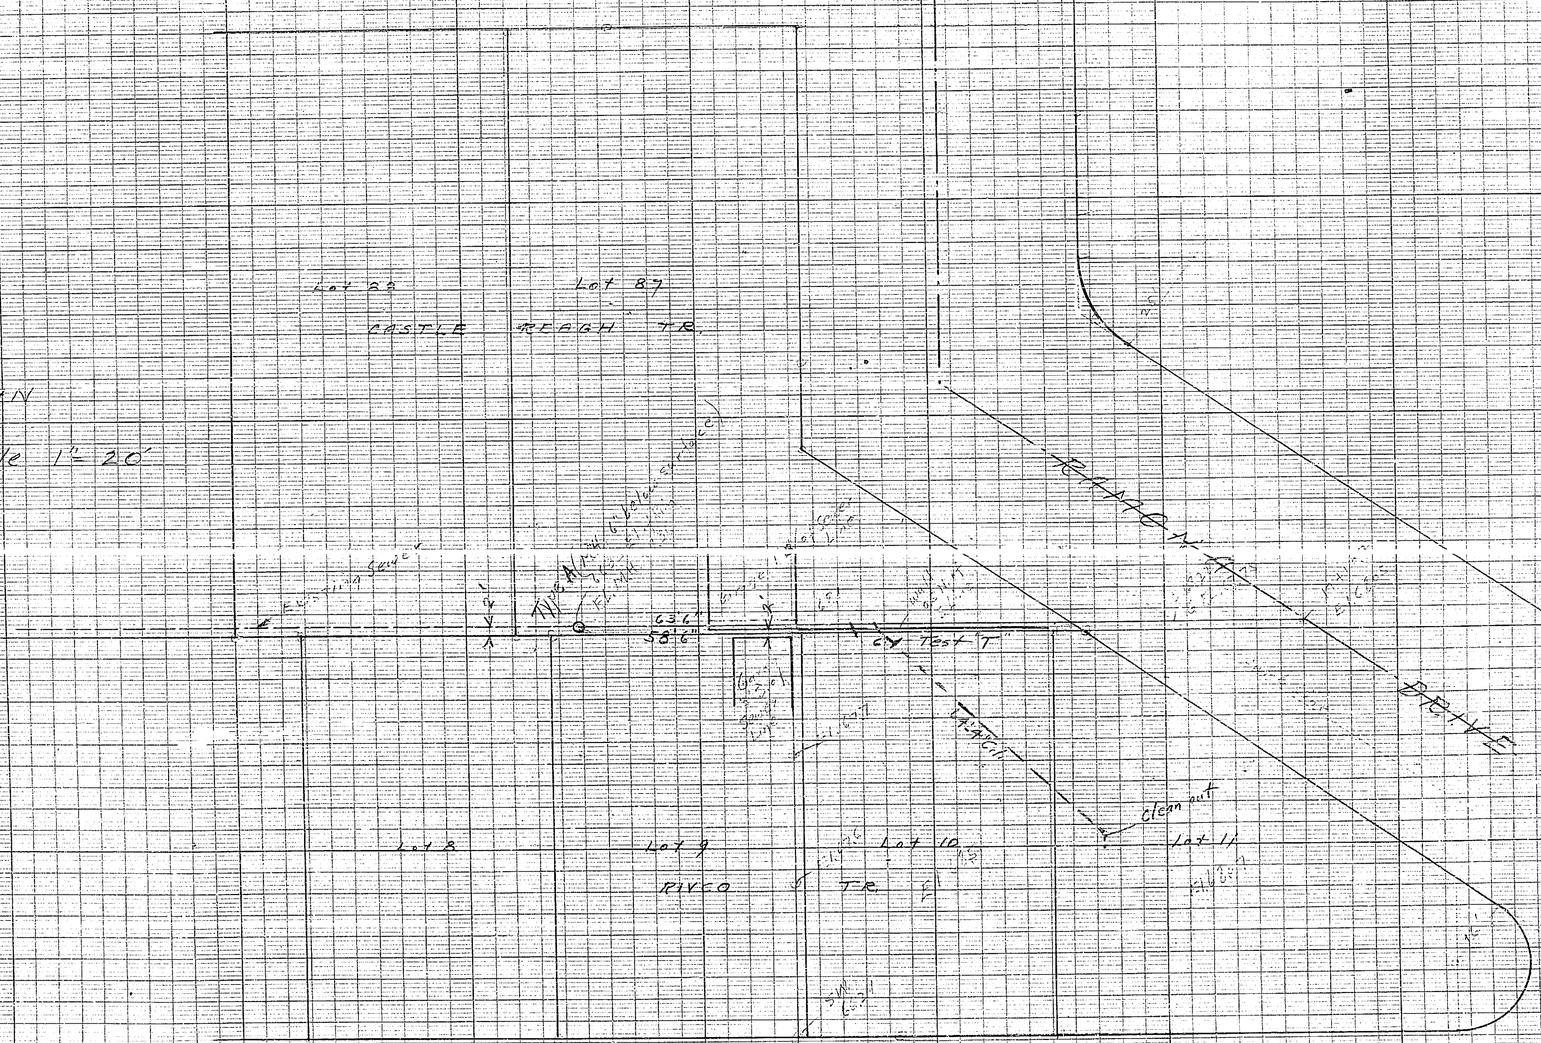

BK 353, Pg 70-71
9/21/58

ELMWOOD COURT

81