DIAGRAM

EXHIBITING OAKLEYS & E.N.SMITHS SUBDIVISIONS SEWER DISTRICT

IN THE CITY OF RIVERSIDE ON WHICH WORK HAS BEEN DONE UNDER MY OFFICIAL CONTRACT AS SUPERINTENDENT OF STREETS OF SAID CITY WITH JOHN C BACICH DATED SEPT. 23, 1948.

FOR THE CONSTRUCTION OF SANITARY SEWER WYE BRANCHES HOUSE CONNECTIONS CLEANOUTS AND MANHOLES

AS IS MORE PARTICULARLY DESCRIBED IN SAID CONTRACT TO WHICH REFERENCE IS HEREBY MADE FOR FURTHER PARTICULARS, SAID DIAGRAM ALSO SHOWS THE BOUNDARIES OF THE DISTRICT OF LAND AFFECTED THEREBY AND THE WORK DONE INDICATED BY CIRCLES TO CORRESPOND TO THE NUMBERS IN THE ASSESSMENT.

THE FIGURES NEXT TO RED CITY LINES SHOW LENGTH OF ADJOINING PARCELS FRONT. THE LETTERS LOT PARCEL LINES THAT DIFFER FROM THE RECORDED PLATS AS SHOWN BY BROKEN LINES THE DISTRICT BROUGHT TO HEARING BY THE CITY COUNCIL OF THE CITY OF RIVERSIDE ON THE ASSESSMENT IS SHOWN ON THE FOLLOWING DATES

OAKLEYS SUBDIVISION	BOOK 5 PAGE 160 RECORDS OF RIVERSIDE COUNTY CALIF.
E N SMITHS SUBDIVISION	BOOK 5 PAGE 179 RECORDS OF RIVERSIDE COUNTY CALIF.
POR. OF LOT 54 S.C.C.A. LANDS	BOOK 3 PAGE 7 RECORDS OF SAN BERNARDINO COUNTY CALIF.

I HEREBY CERTIFY THAT THIS ASSESSMENT WAS APPROVED BY THE CITY COUNCIL OF THE CITY OF RIVERSIDE AT A MEETING HELD ON THE DAY OF 19

CITY CLERK OF THE CITY OF RIVERSIDE

STANDARD MANHOLE

STANDARD CLEANOUT

VIT. CLAY PIPE SEWER

VIT CLAY PIPE WYE BRANCH

VIT CLAY PIPE HOUSE CONNECTION

STANDARD DROP MANHOLE

I HEREBY CERTIFY THAT I AM SUPERINTENDENT OF STREETS OF THE CITY OF RIVERSIDE AND THAT THE ABOVE DIAGRAM IS THE DIAGRAM REFERRED TO IN MY OFFICIAL REPORT TO THE CITY COUNCIL OF THE CITY OF RIVERSIDE DATED JOHN C. BACICH

SEPTEMBER 23, 48

4374

2ND JUNE 48

LIST OF QUANTITIES

3	STANDARD MANHOLES
3	STANDARD CLEANOUTS
1063.47 LIN. FT.	6" VIT CLAY PIPE
10.' LIN. FT.	4" V.C.P. HOUSE CONNECTION
33	6"X4" VIT CLAY PIPE WYE BRANCHES
1	STANDARD DROP MANHOLE

I HEREBY CERTIFY THAT THE ABOVE WORK WAS DONE UNDER MY SUPERVISION AND THAT THE DIAGRAM IS THE ASSESSMENT DISTRICT FOR THE SAME IS CORRECT

CITY ENGINEER OF THE CITY OF RIVERSIDE

APPROVED BY THE CITY OF RIVERSIDE THIS DAY OF

SUPERINTENDENT OF STREETS OF THE CITY OF RIVERSIDE

RECORDED AT THIS DAY OF

22"
17"
11"
8.5"
8.5"
11"
17"

813

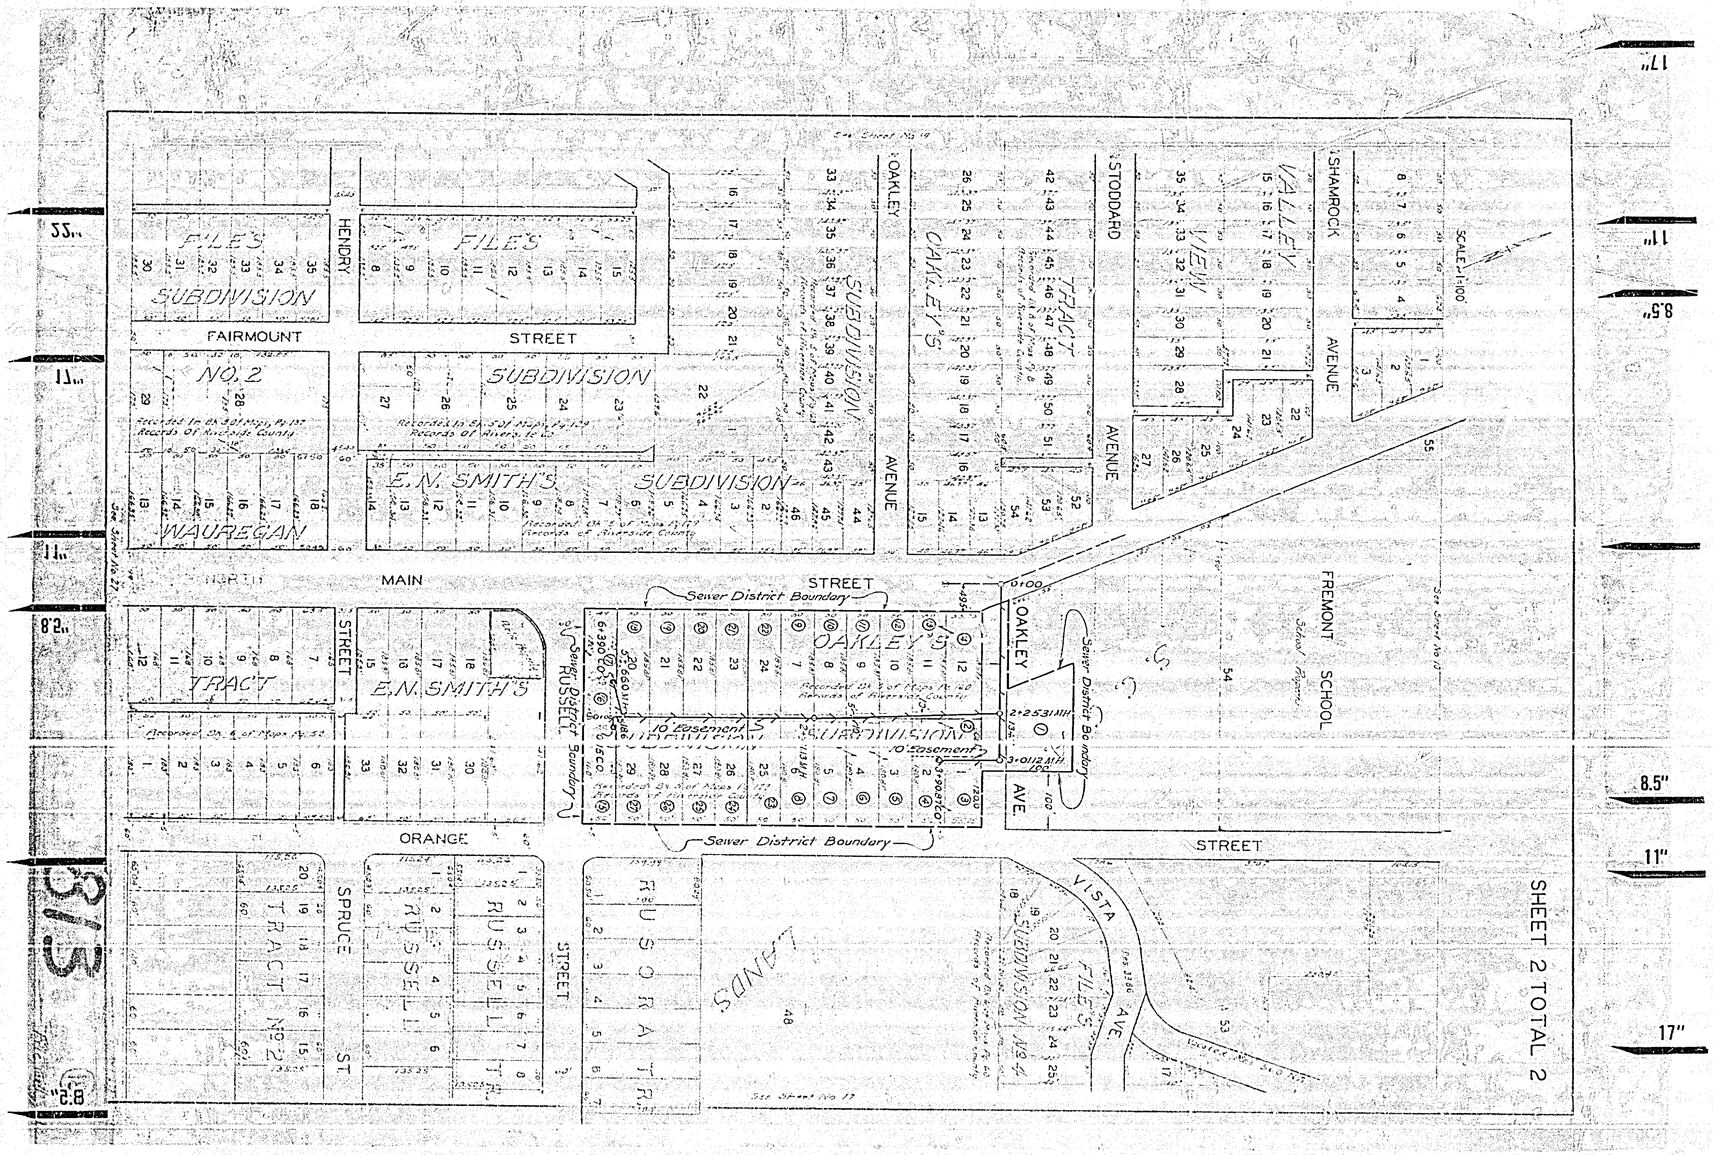
SHAMROCK AVENUE
STODDARD AVENUE
OAKLEY AVENUE
HENDRY
FAIRMOUNT
STREET
MAIN STREET
ORANGE STREET
SPRUCE ST
FREMONT SCHOOL
OAKLEY AVE
VISTA AVE
VALLEY VIEW TRACT
OAKLEY'S SUBDIVISION
E.N. SMITH'S SUBDIVISION
WAUREGAN NO. 2
FILES SUBDIVISION
TRACT
RUSSELL
RUSSELL TR.
SANDS
SUBDIVISION NO 4
Sewer District Boundary
SCALE 1"=100'
SHEET 2 TOTAL 2