

34.0

55.0

11.0

11.0

8.2.0


8.8

11.0

11.0








PROFILES OF EAST SIDE OF BROCKTON AVE.

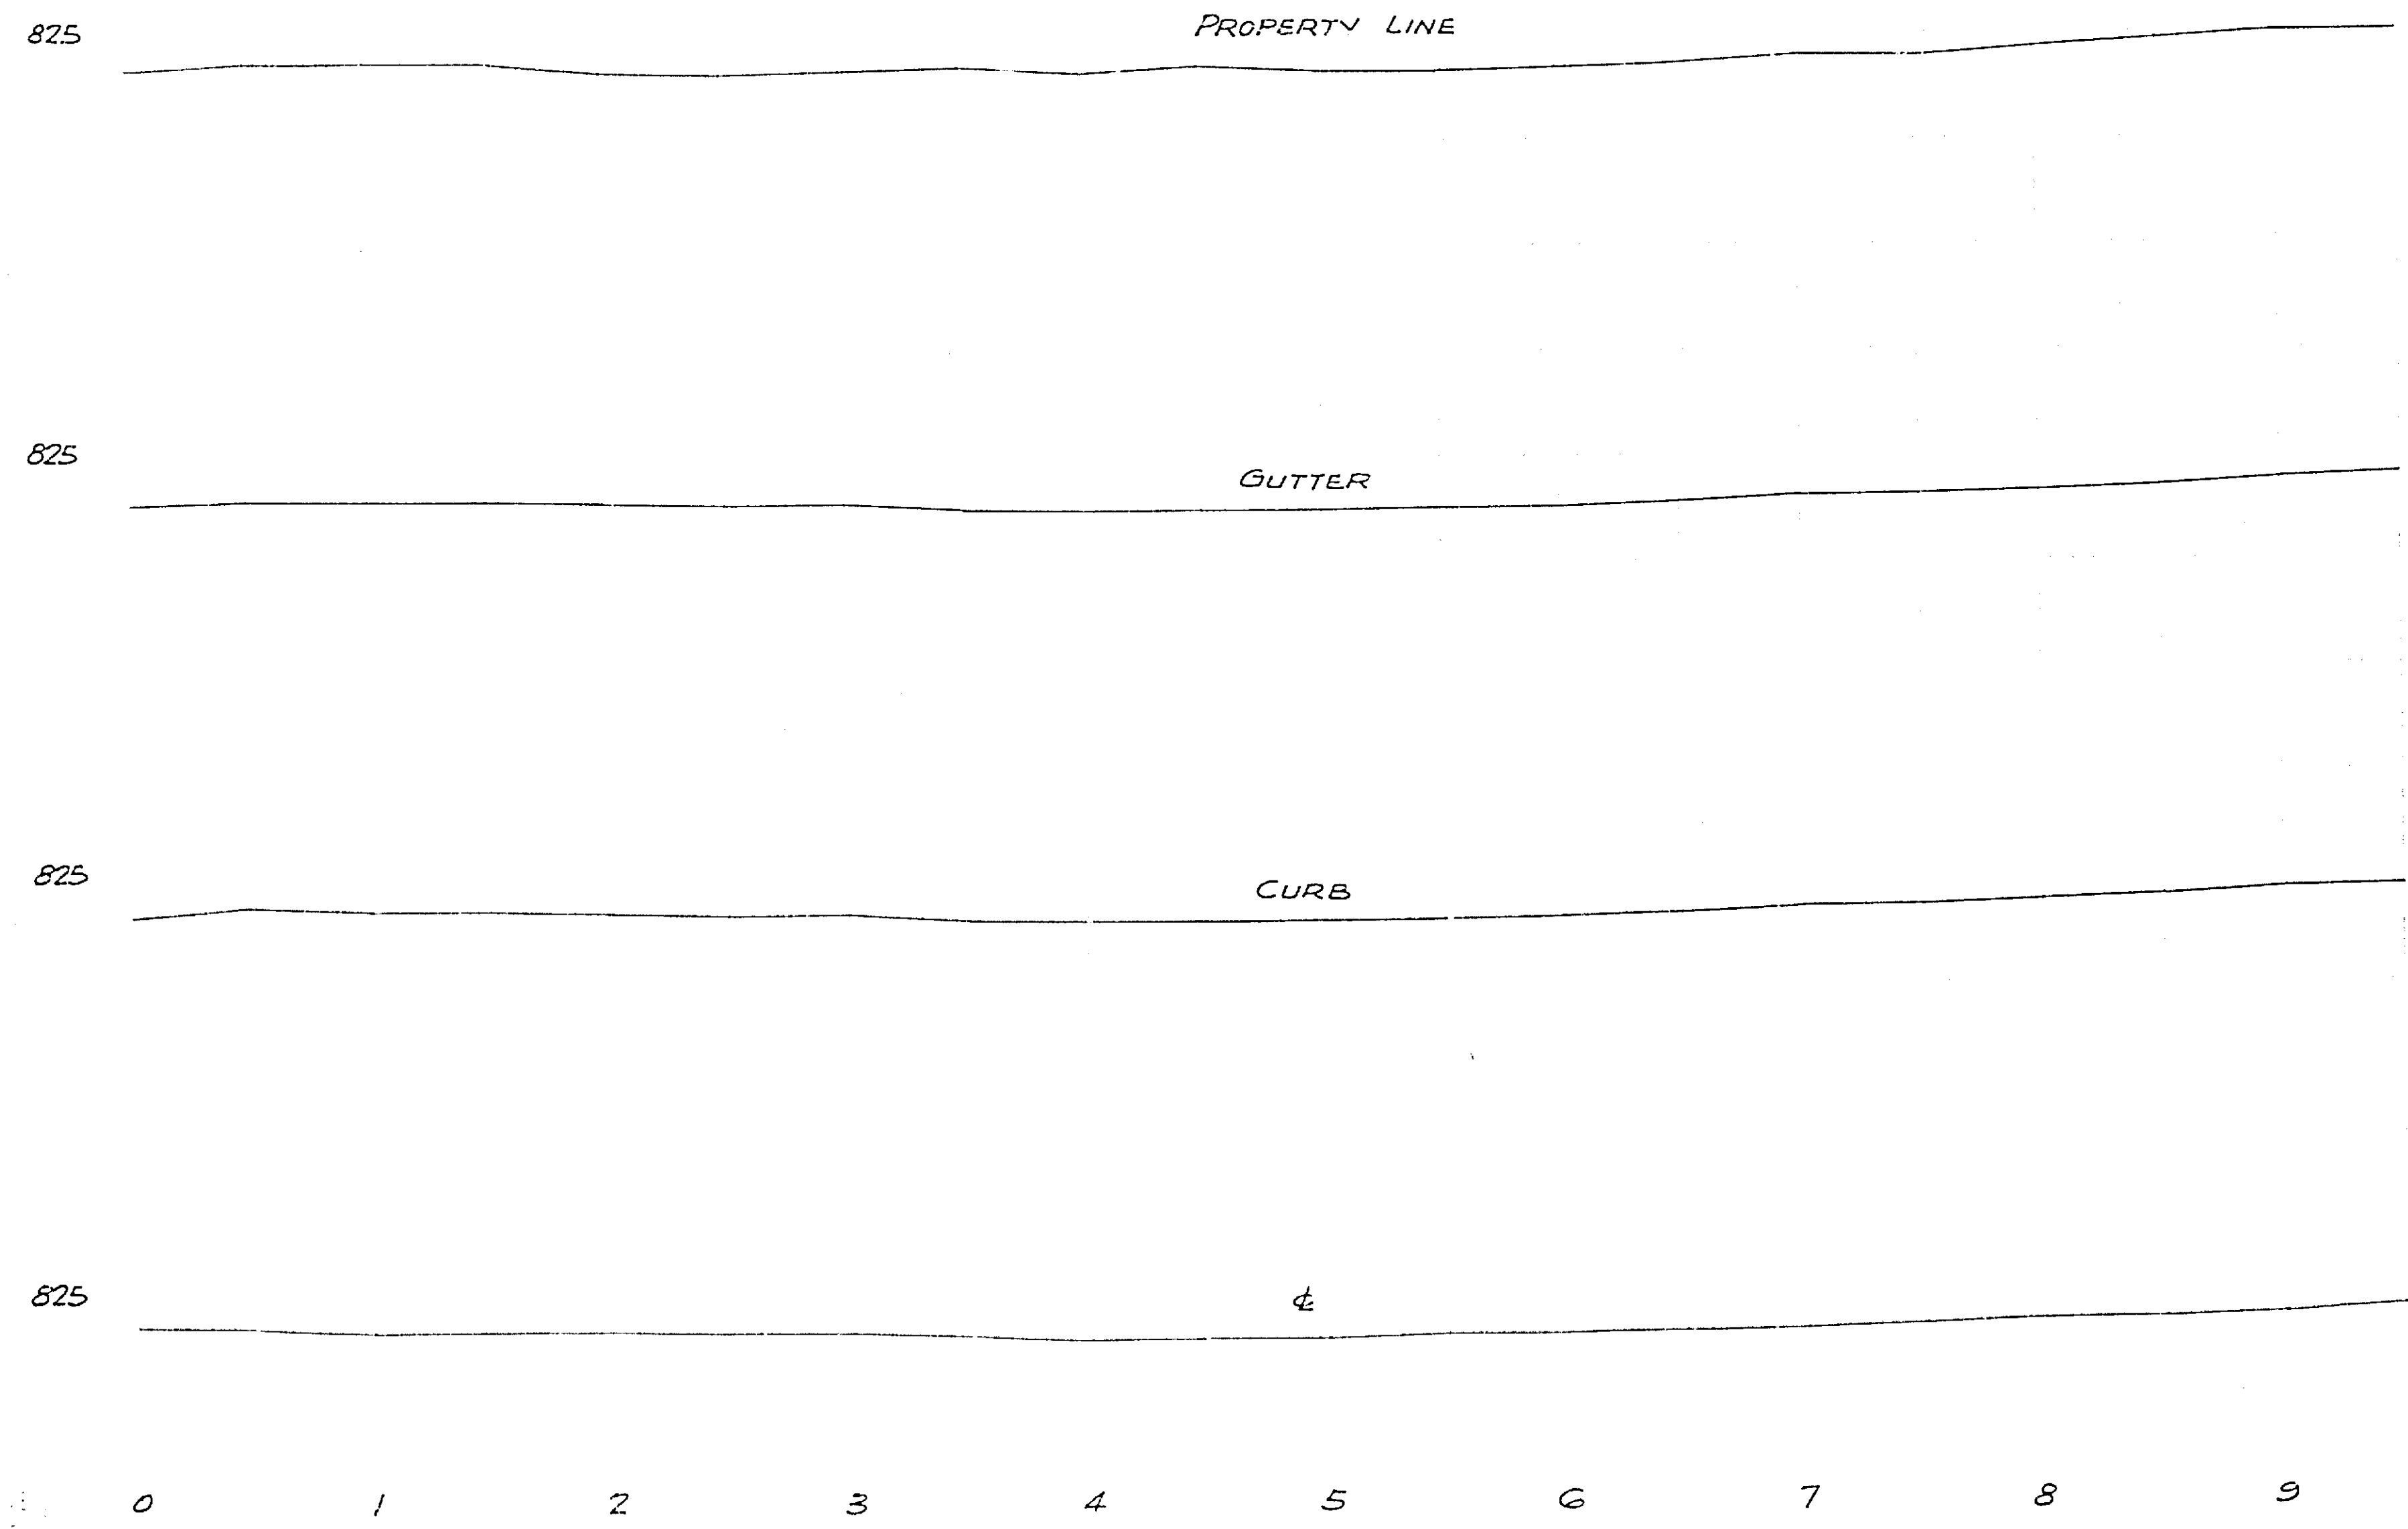


70

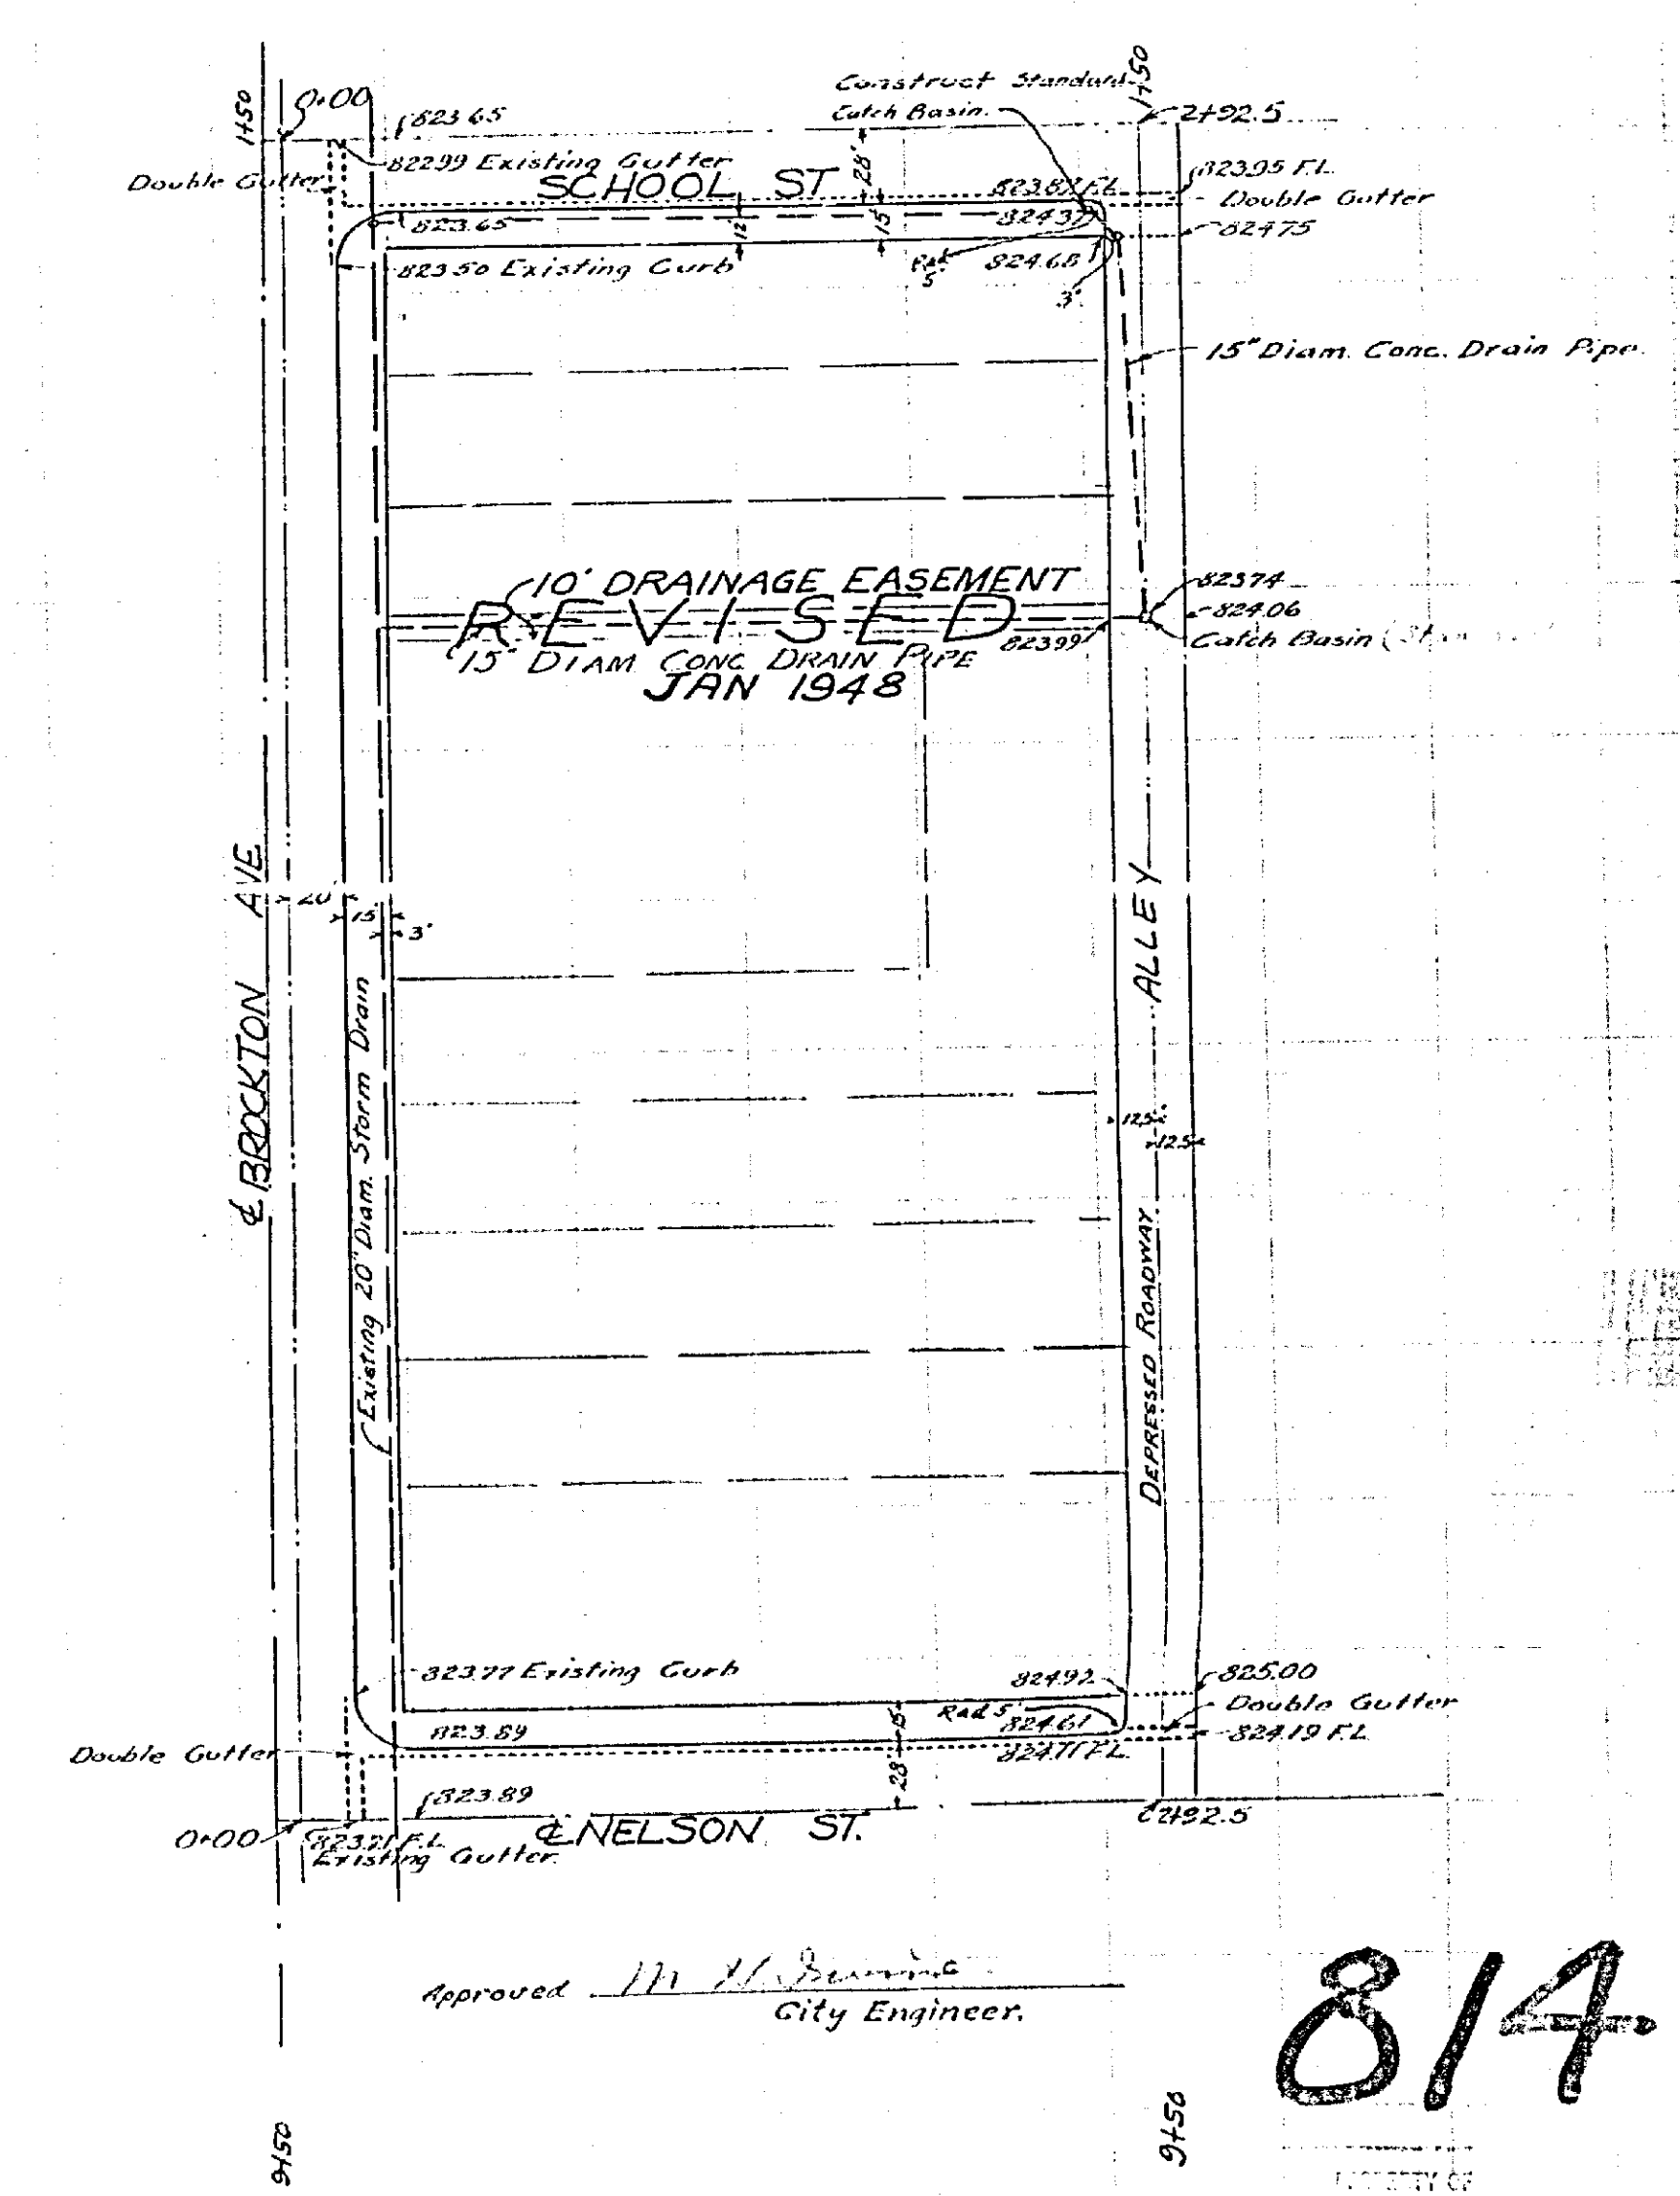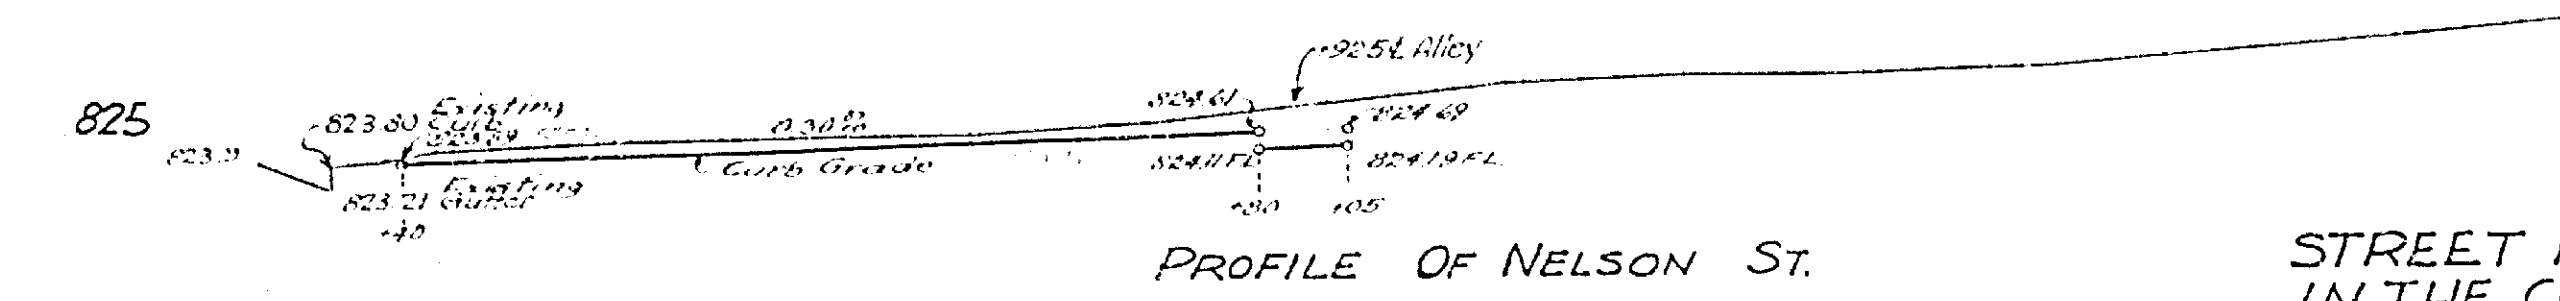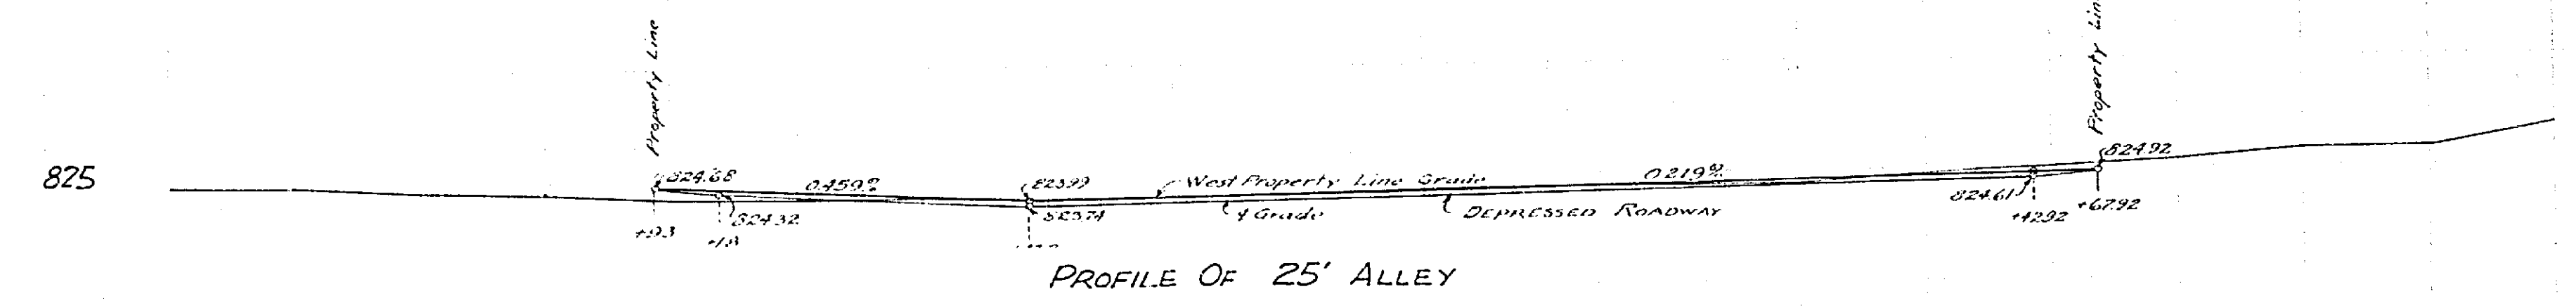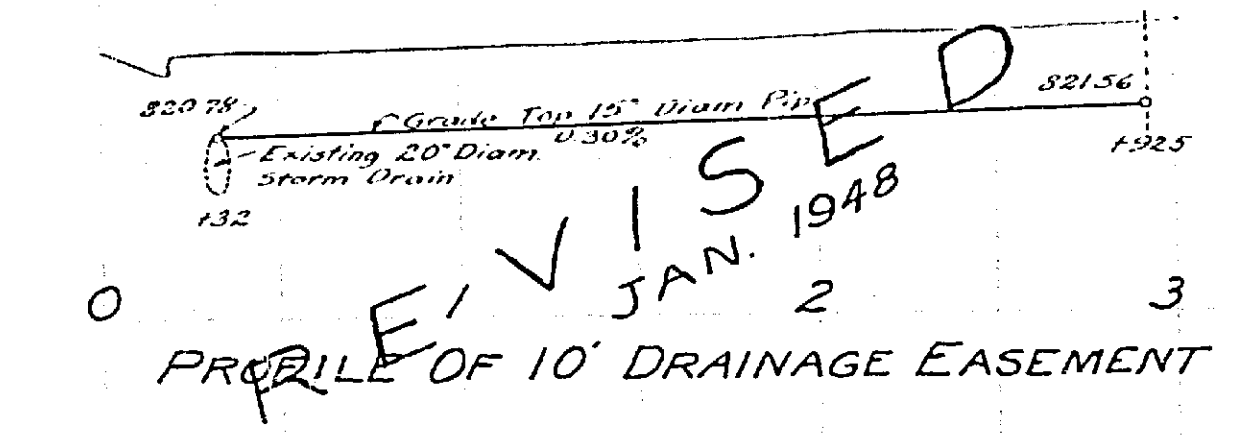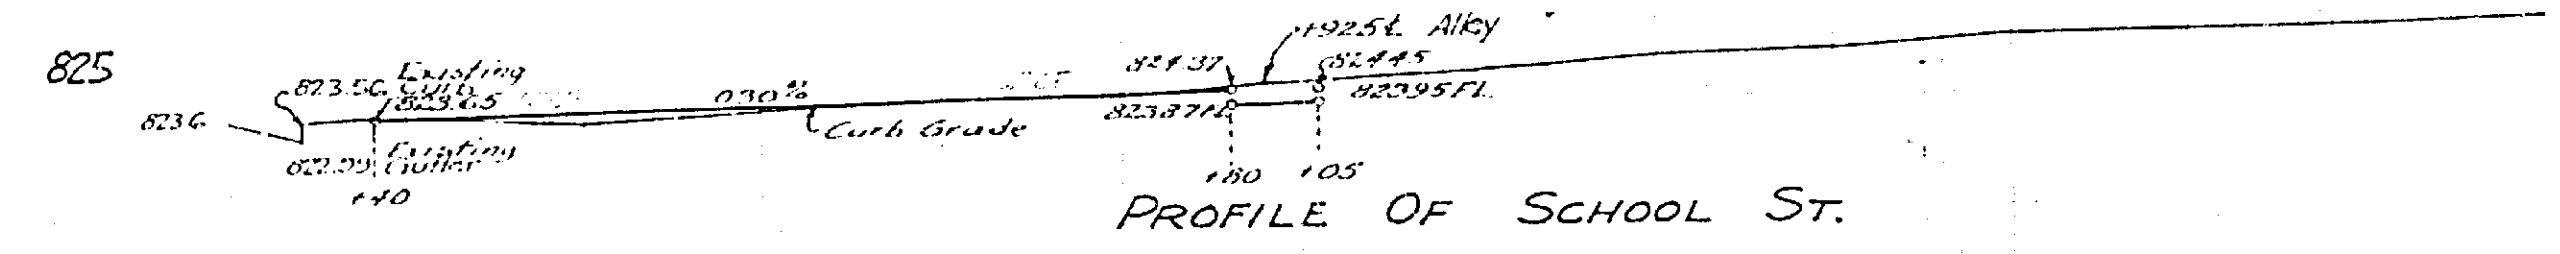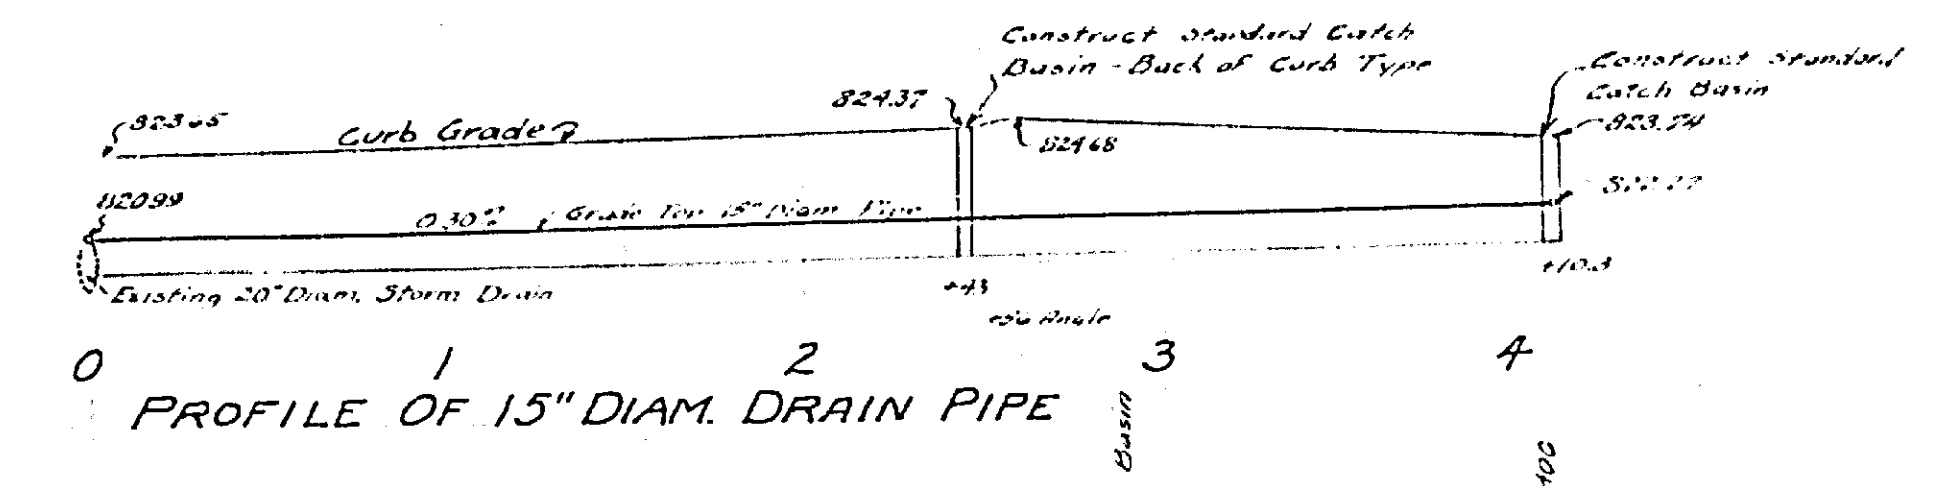

STREET PROFILES OF 'H.C. PETERS TRACT'
 IN THE CITY OF RIVERSIDE. JULY, 1947.

SCALES: 1" = 50' HOR.; 1" = 5' VERT.
 ELEVATIONS - CITY DATUM
 F.B. 353-55.

J.F. DAVIDSON, C.E.

Approved *[Signature]*
 City Engineer.

814

0 1 2 3 4 5 6 7 8 9 10