

34

55

11

11

82

82

11

11

55

22

11

11


8.5

8.5

11

17

22

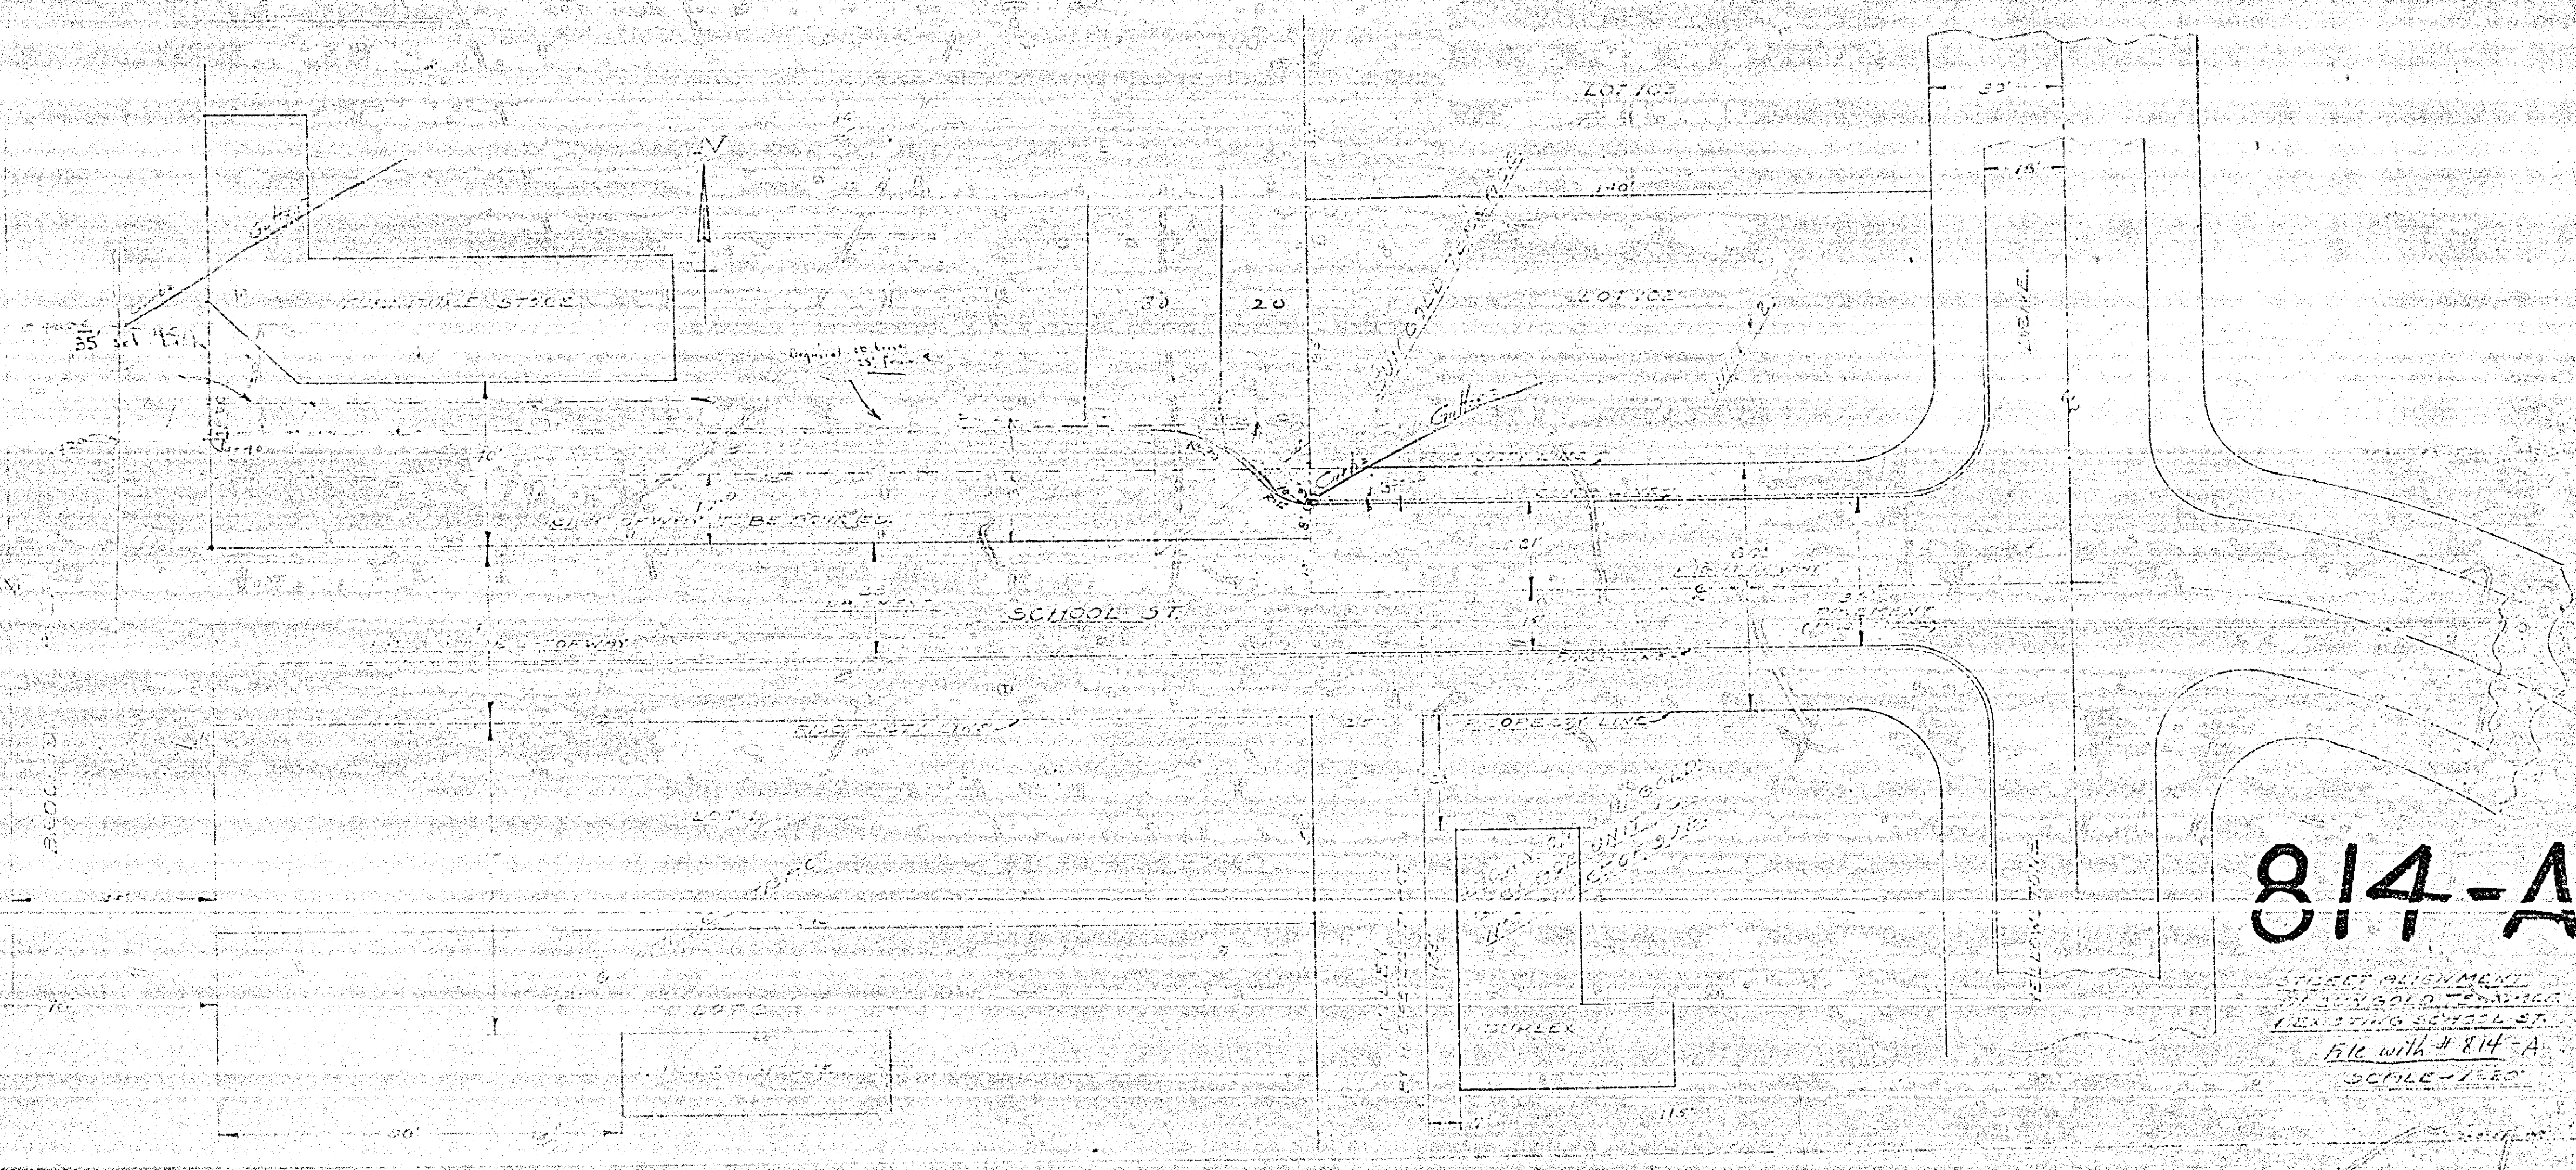

814-A

STREET ALIGNMENT
 FILE WITH # 814-A
 SCALE = 1" = 20'