


North E. of Lots 38 & 39 Rivero Tract.  
BK 365, P 6.  
11-17-38

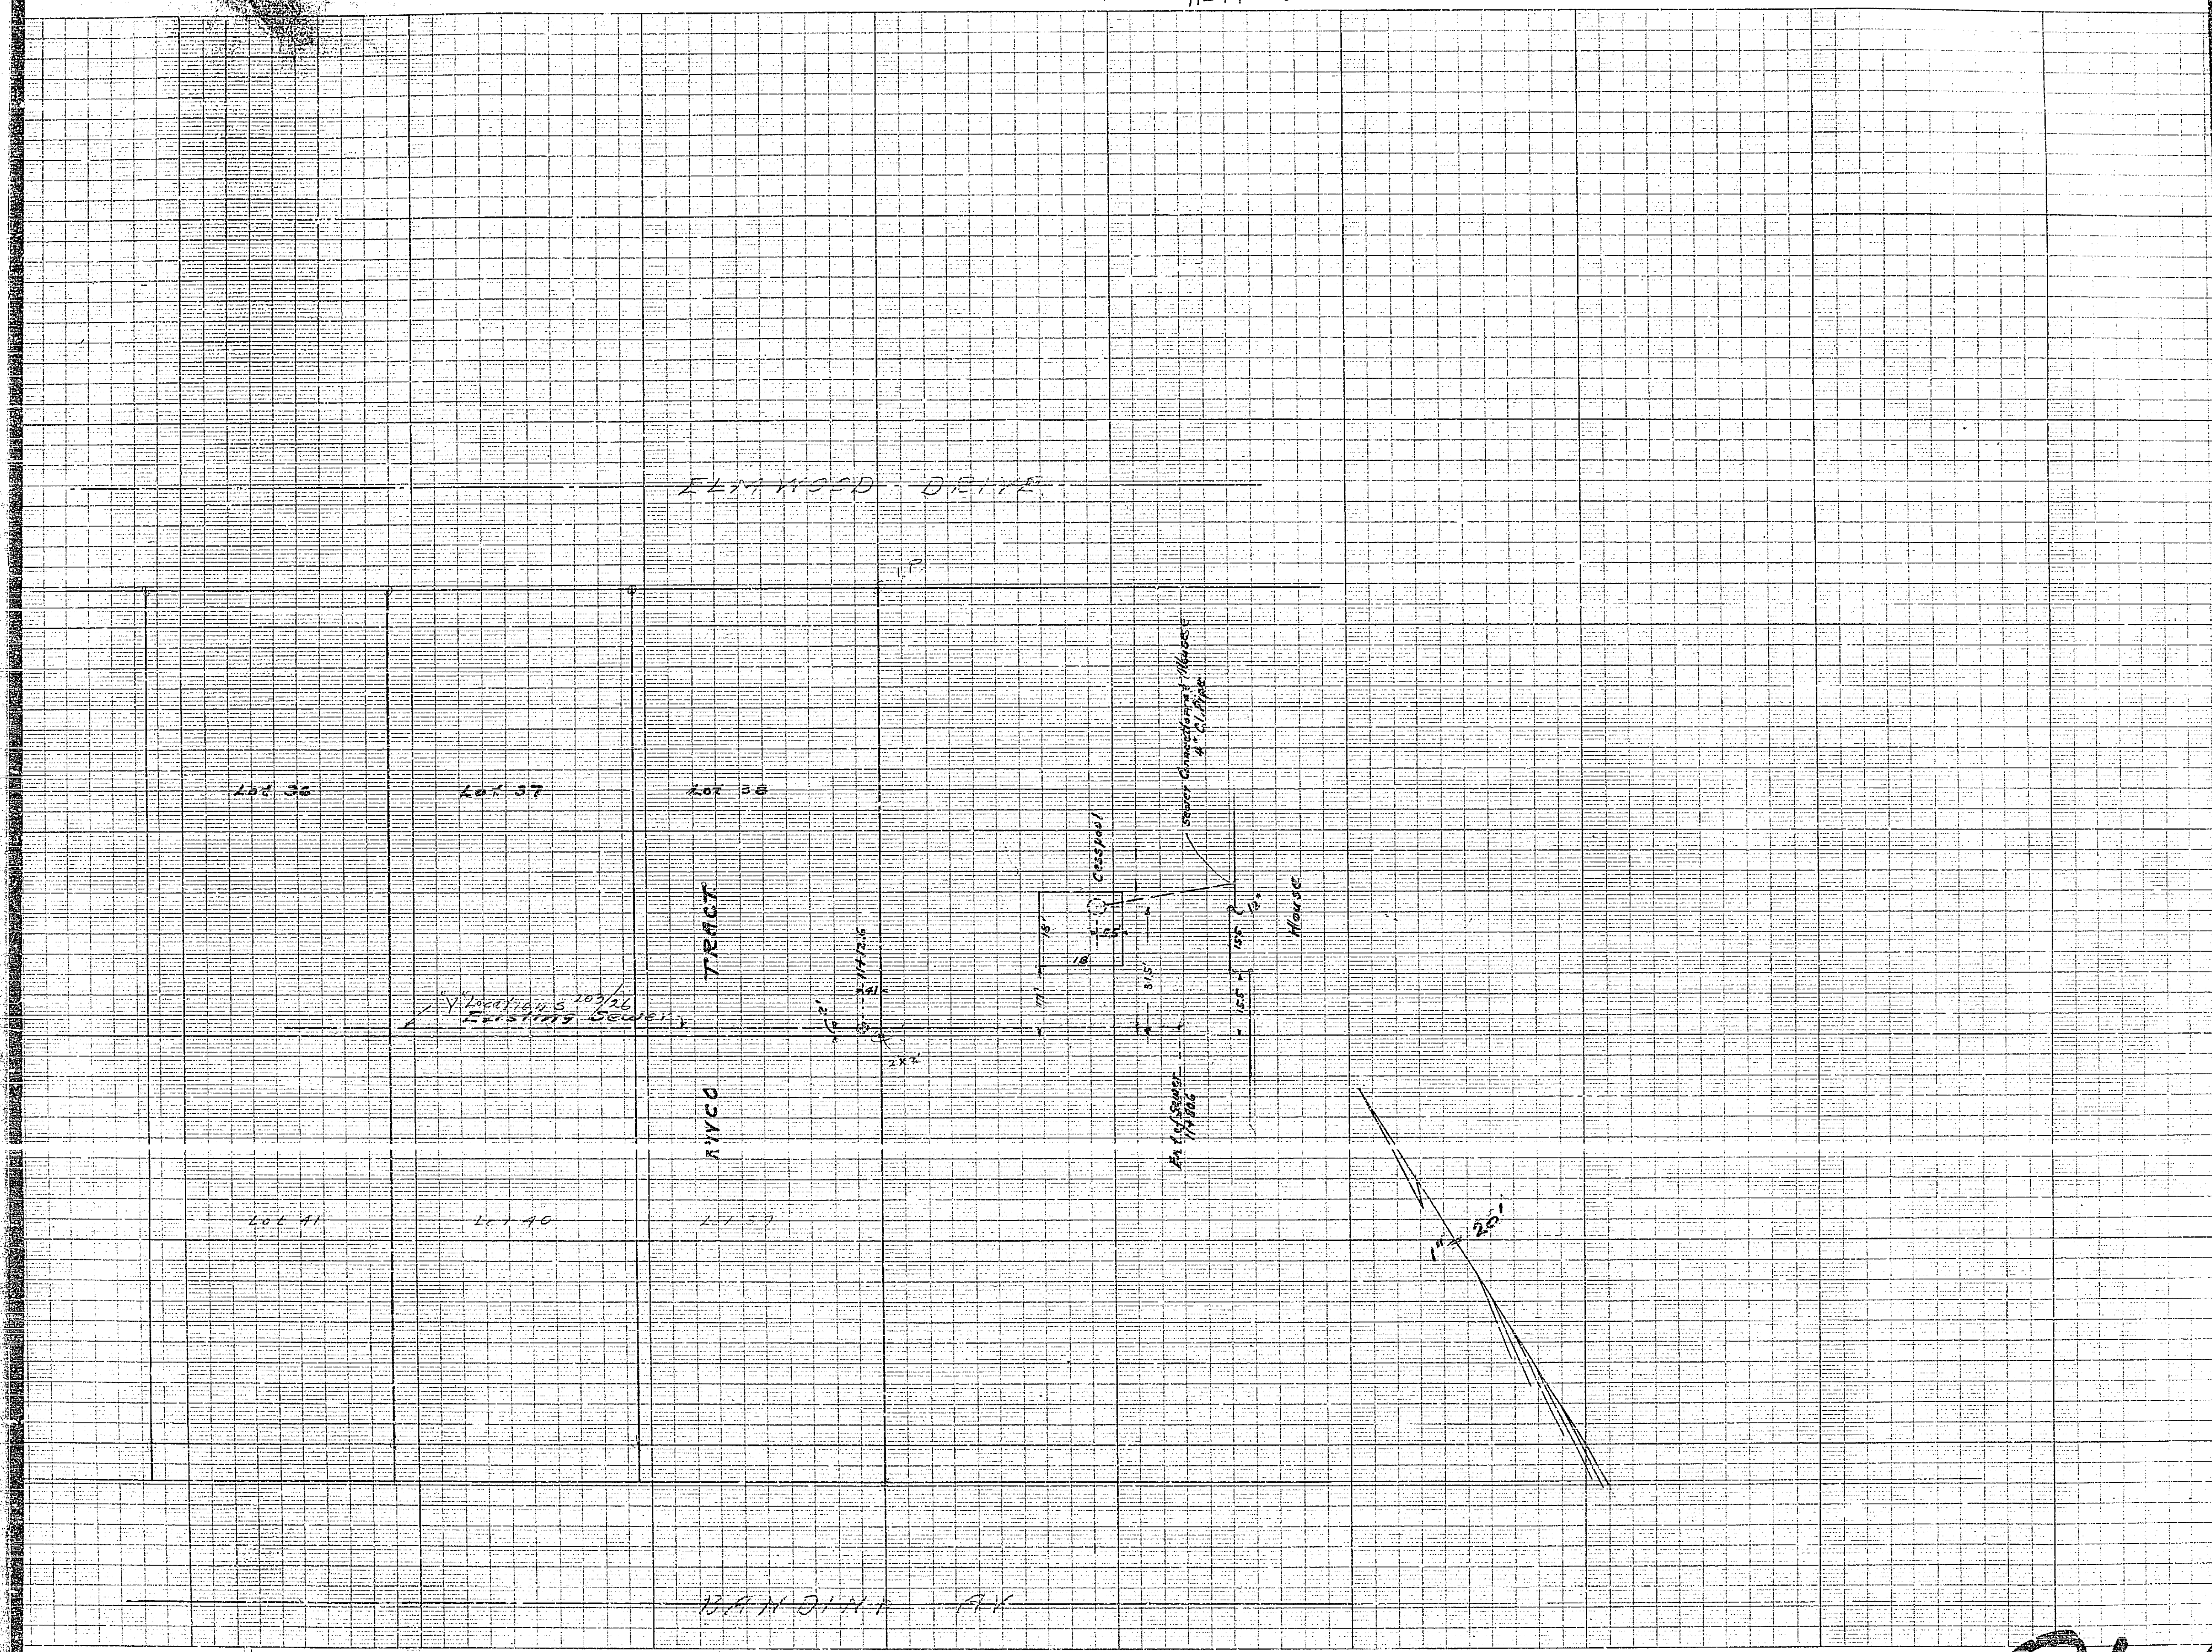

81-A