THIRD ST. & PACHAPPA AVE. DRAINAGE			
DRAWING NUMBER	SHEET NUMBER	TOTAL SHEETS	FIELD BOOKS
84	1	1	
DRAWN BY	CHECKED BY	APPROVED BY	

PROFILE

SCALE: VER. 1"=4'
HOR. 1"=40'

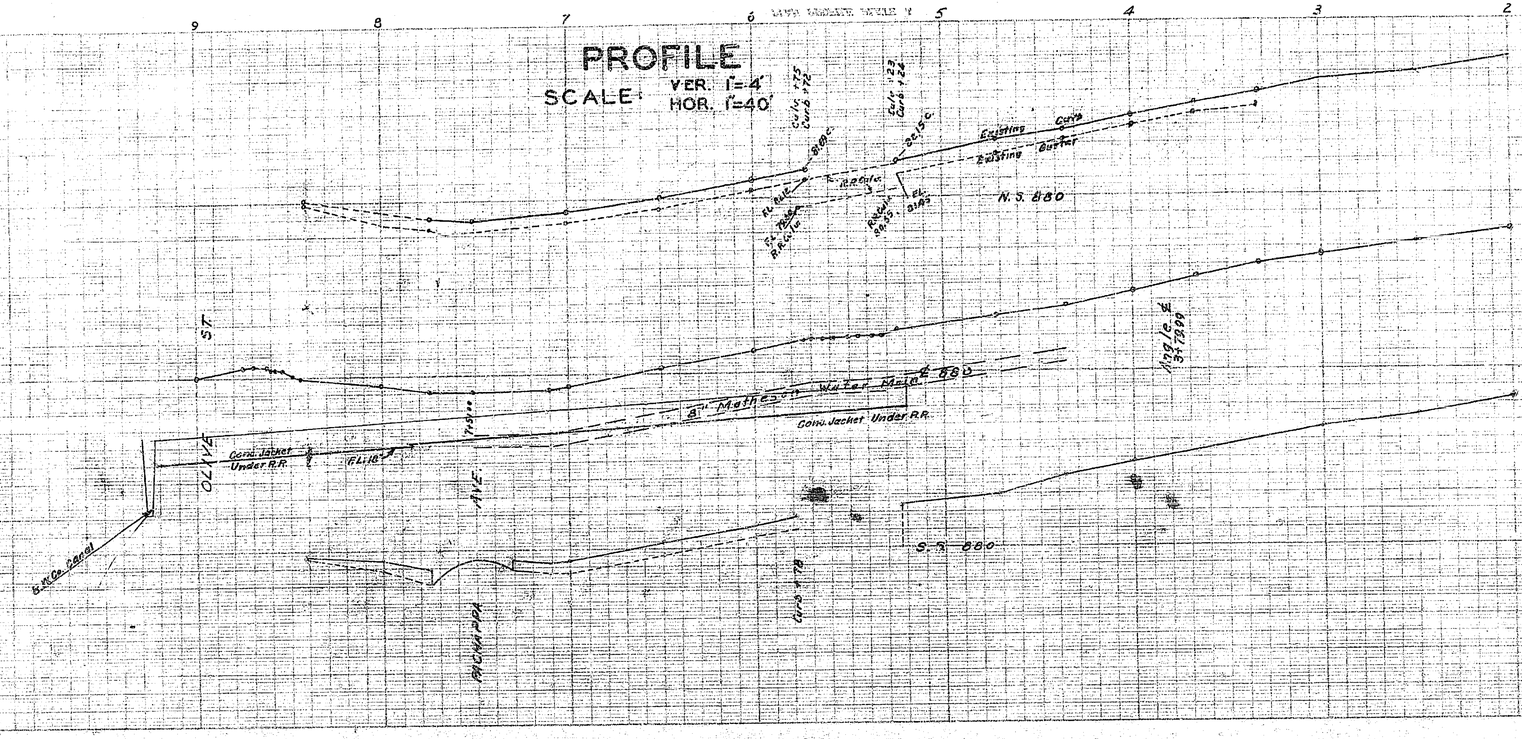

PLAN

SCALE: 1"=40'

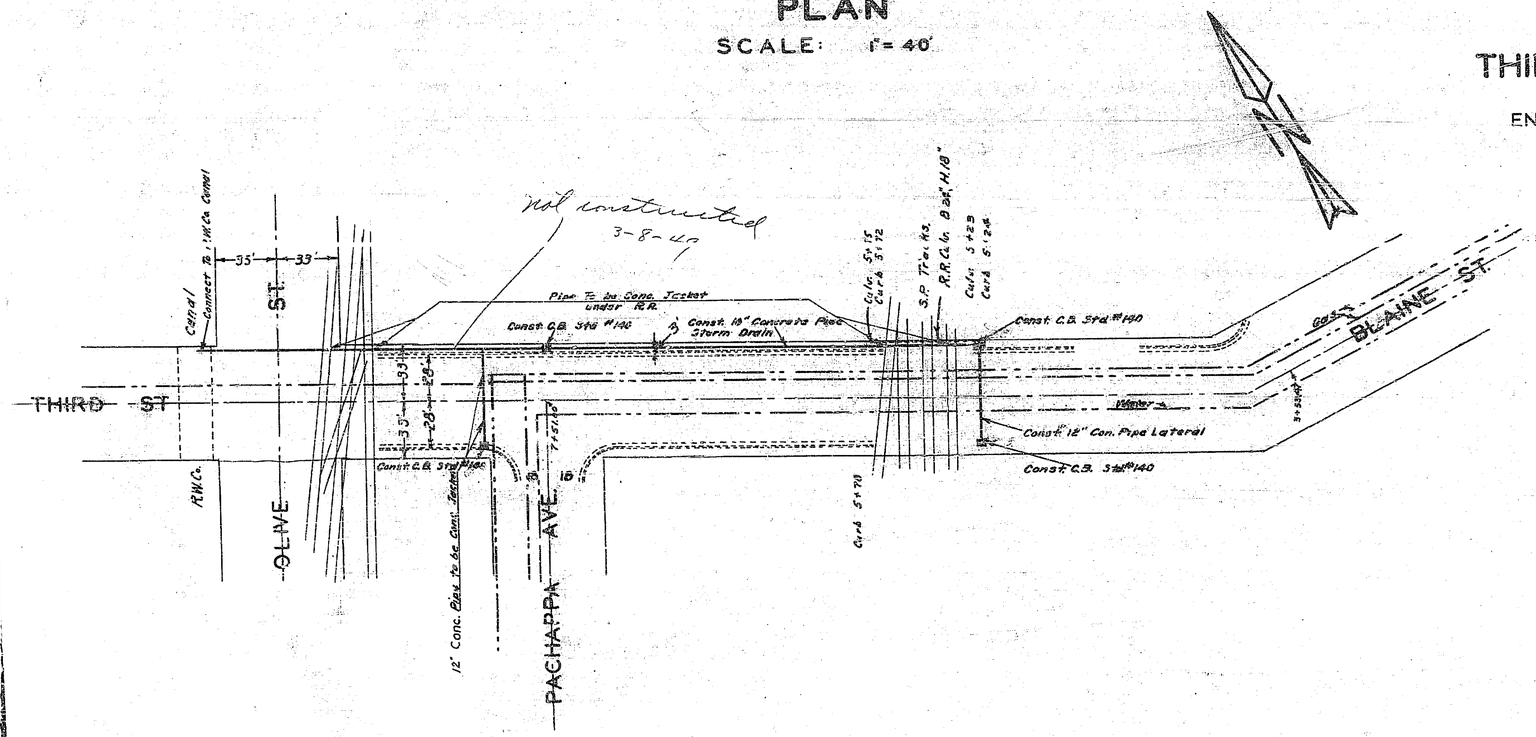

THIRD ST. AND PACHAPPA AVE. DRAINAGE

ENGINEERING DEPT CITY OF RIVERSIDE

APPROVED _____
CITY ENGINEER
REG. ENG. NO. 1312

84-B