
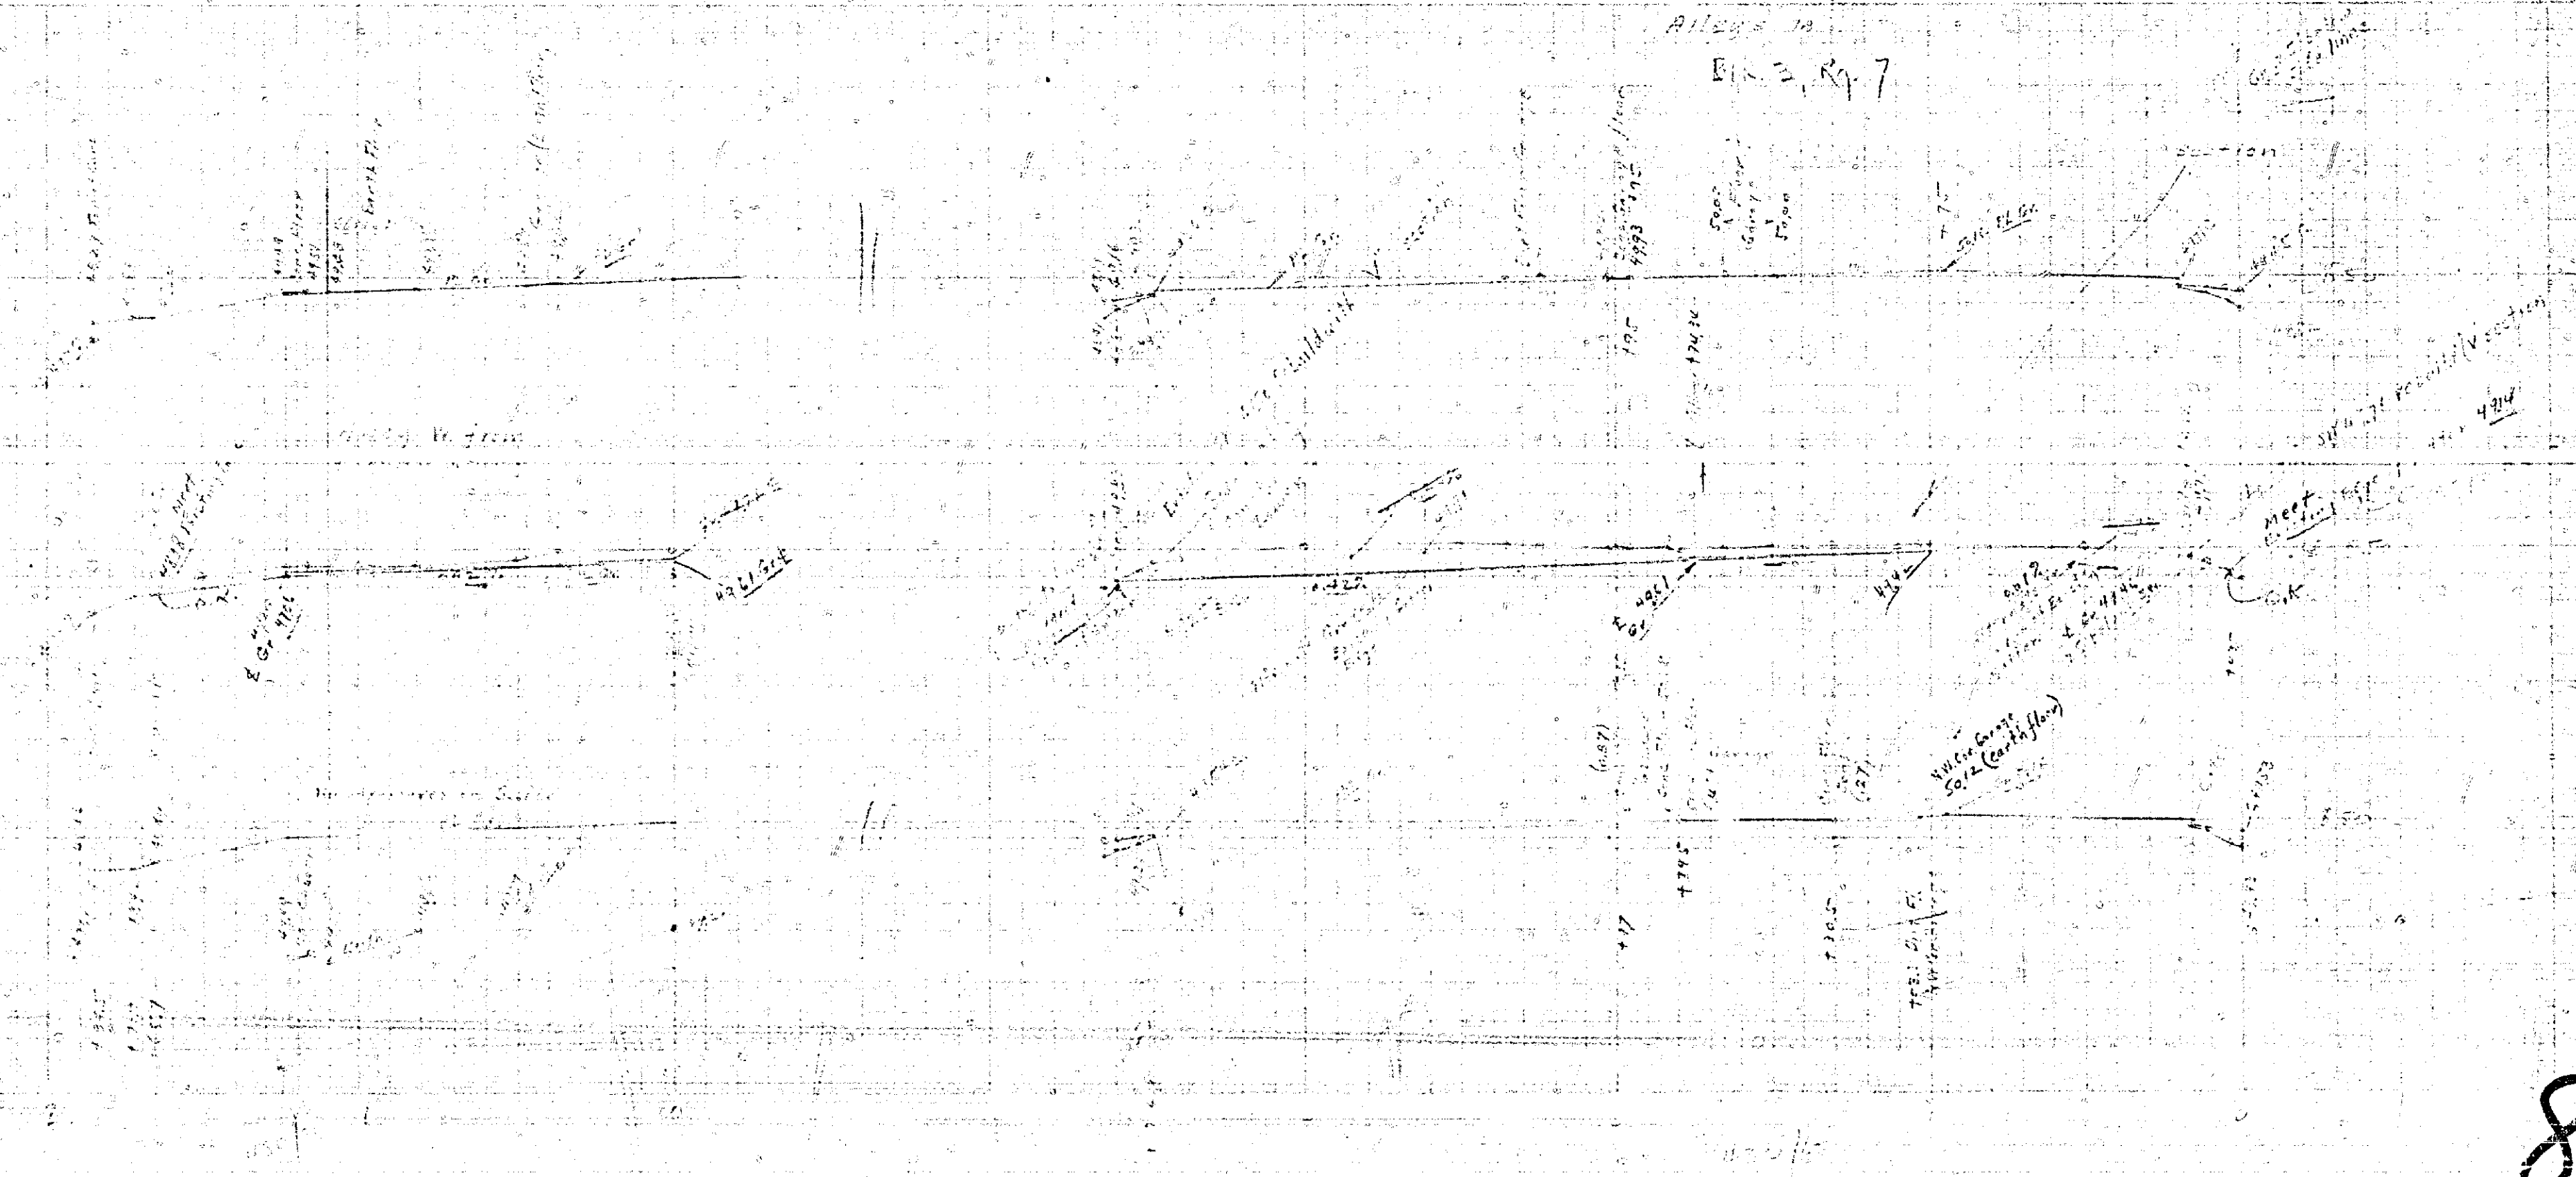


22"  
17"  
11"  
8.5"  
8.5"  
11"  
17"  
22"

22"  
17"  
11"  
8.5"  
8.5"  
11"  
17"  
22"

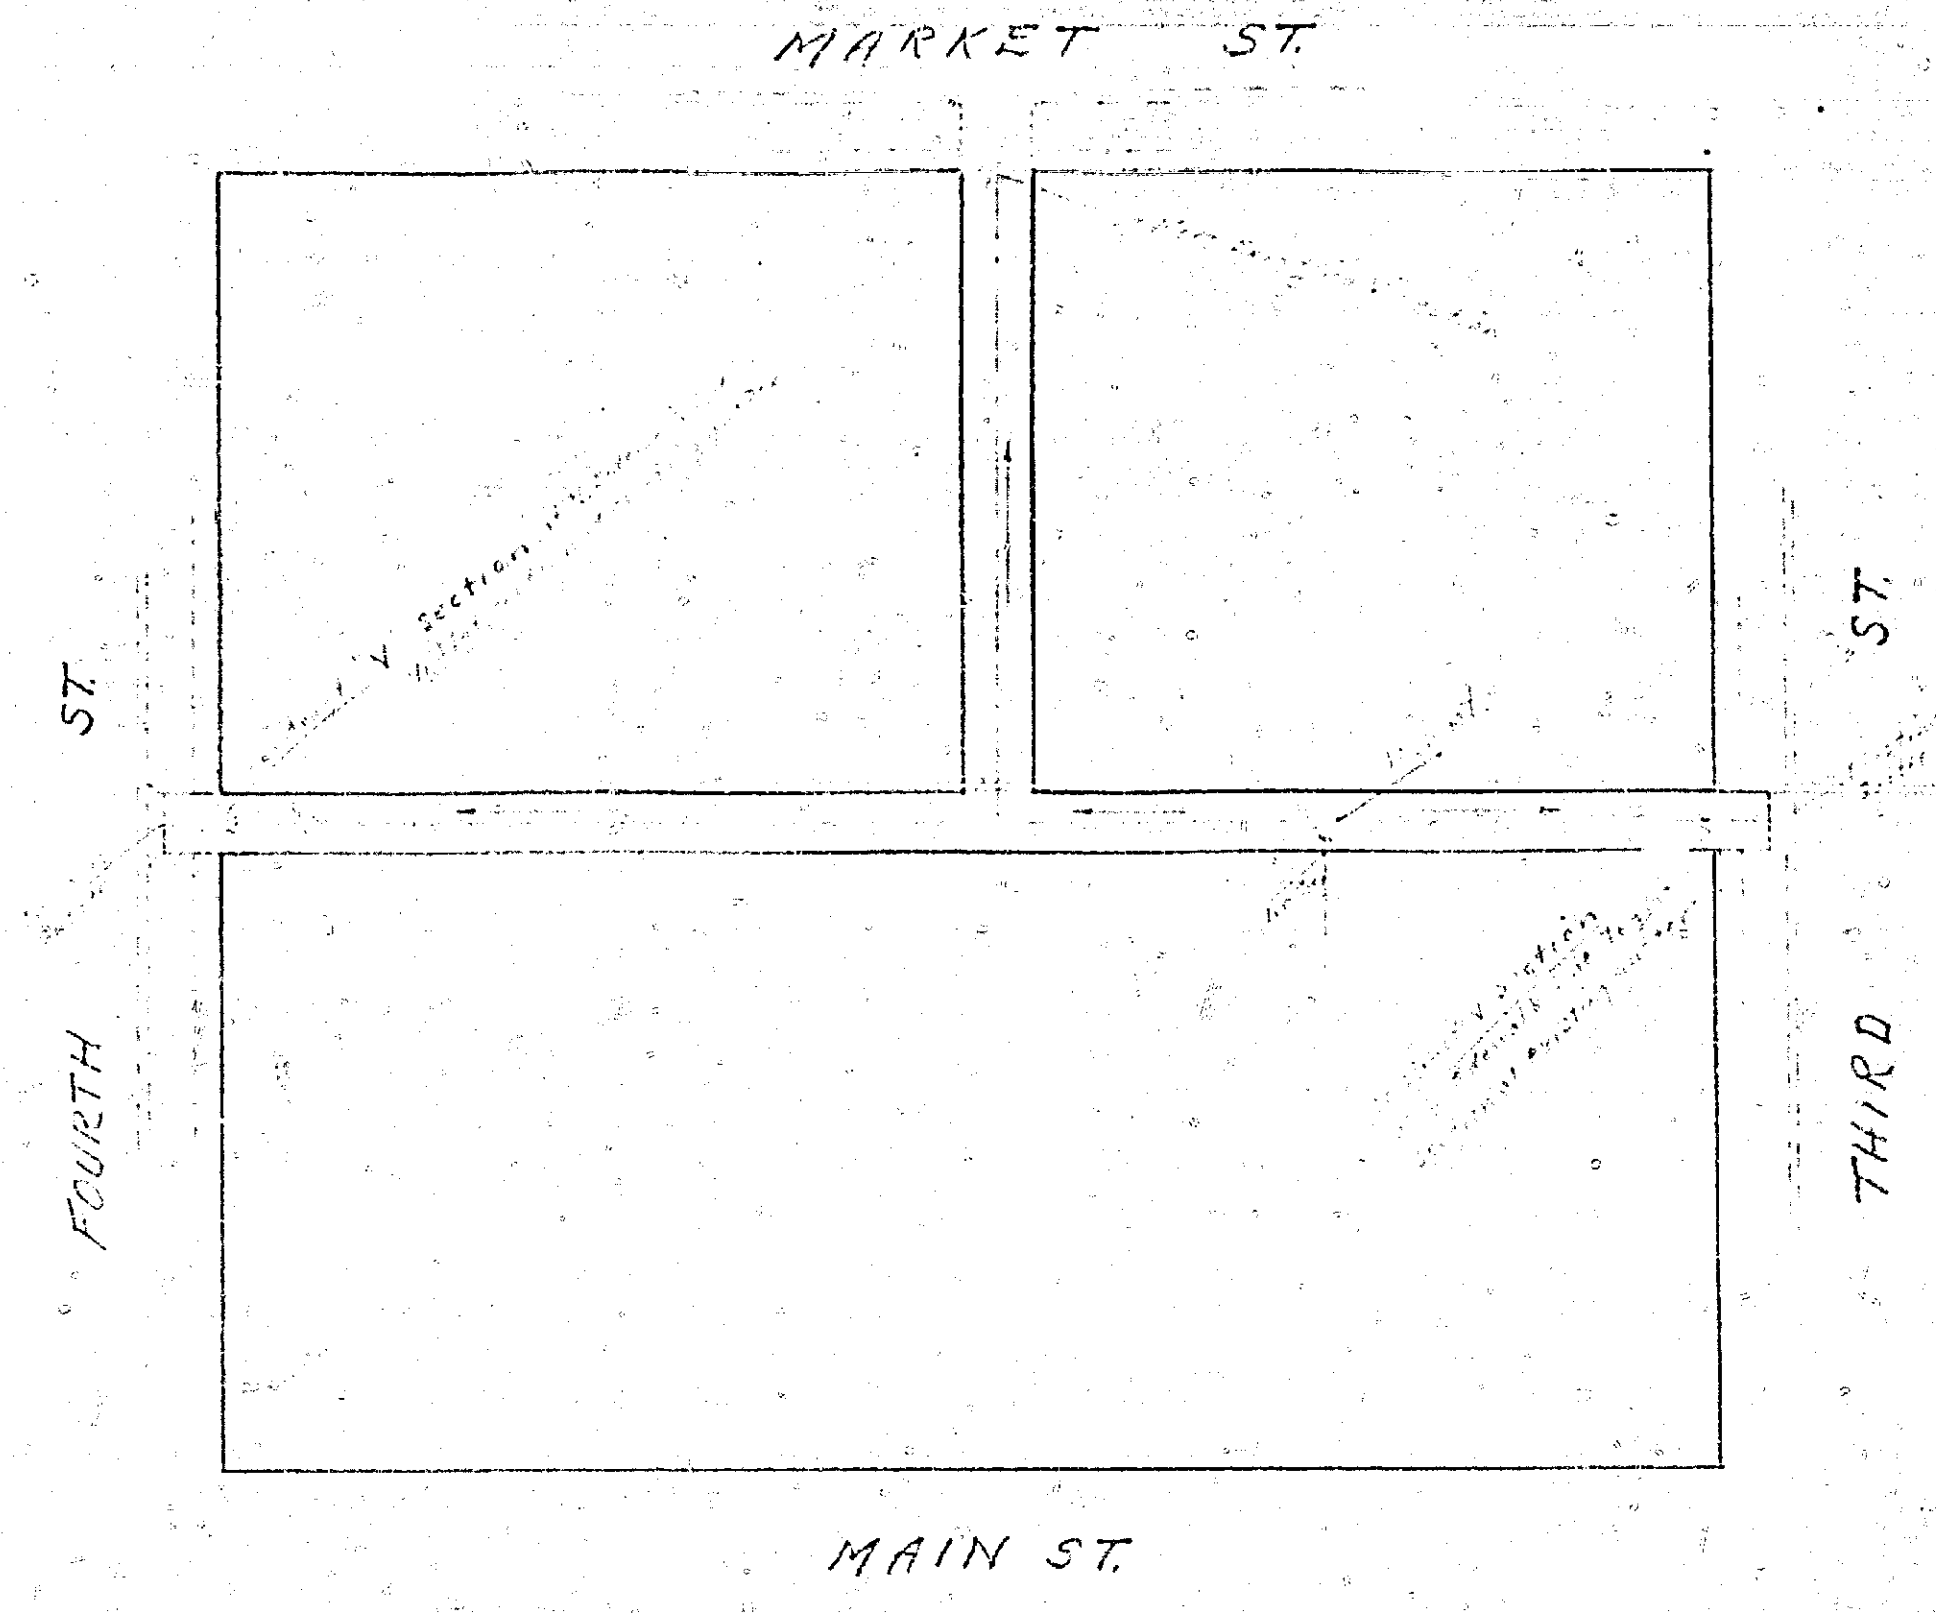

858