MAP No 872

MAP OF PROPOSED SEWER
SYFORD'S BUSINESS BLOCK ADDITION AND A PORTION OF LOT 154 S.C.C.A. LANDS.

A.P. CAMPBELL CITY ENGINEER 1926

SCALE 1in = 100ft

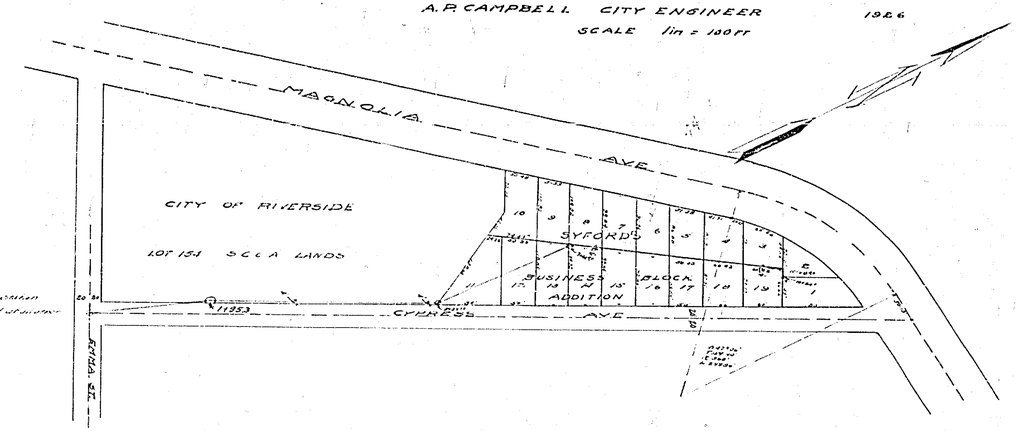

Note:
See Standard Manhole Cast Iron Cover Type "A" Drawing No 853 Approved by the Mayor and Common Council of the City of Riverside June 30, 1925

Note:

Cover to weigh not less than	180 lbs.
Frame	200 "
Run	50 "

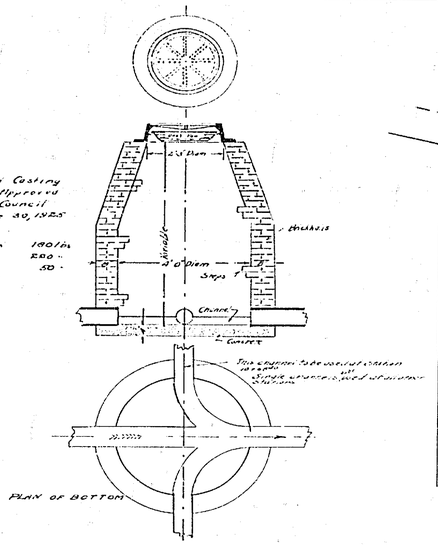

DETAIL OF TYPE "A" MANHOLE

LEGEND

Vitrified Sewer to be constructed	shown thus	
"Y" Branches	"	"
Type "A" Manholes	"	"
Cleanouts	"	"
Sewer already constructed	"	"
Type "A" Manholes	"	"

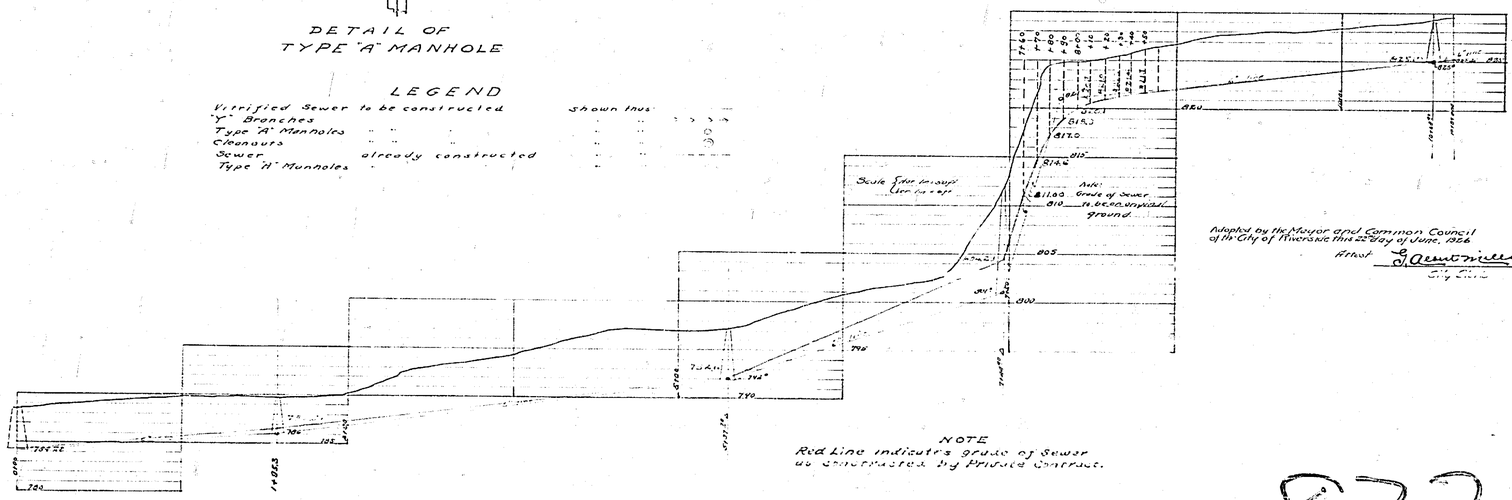

872

MAP No 872