

BROCKTON AVE. 10 in. C.I. Pipe

MAP OF BEECHWOOD PLACE
Showing Location of Domestic Water Lines
Now in Place, and Proposed Extension.
Scale 1 in = 50 Ft. October 1926.

Cut 10" C.I. Main
Set in 10" dia. CI Cross
2'-6" dia. manhole
1'-4" dia.

Proposed 4" C.I. Pipe 677' ±





BEECHWOOD PLACE. 618' of 4" Pipe in Place

Beechwood Pl.

BATTLES ELMWOOD TRACT.

199
208

198
209

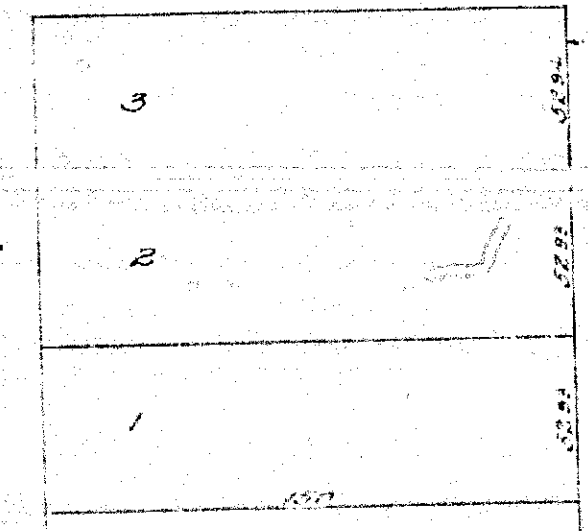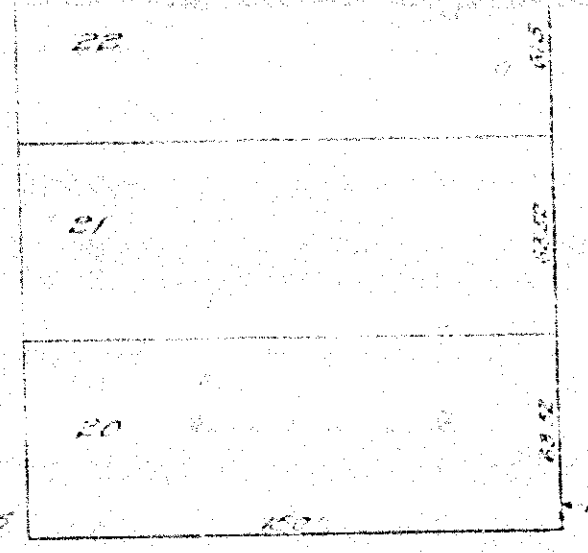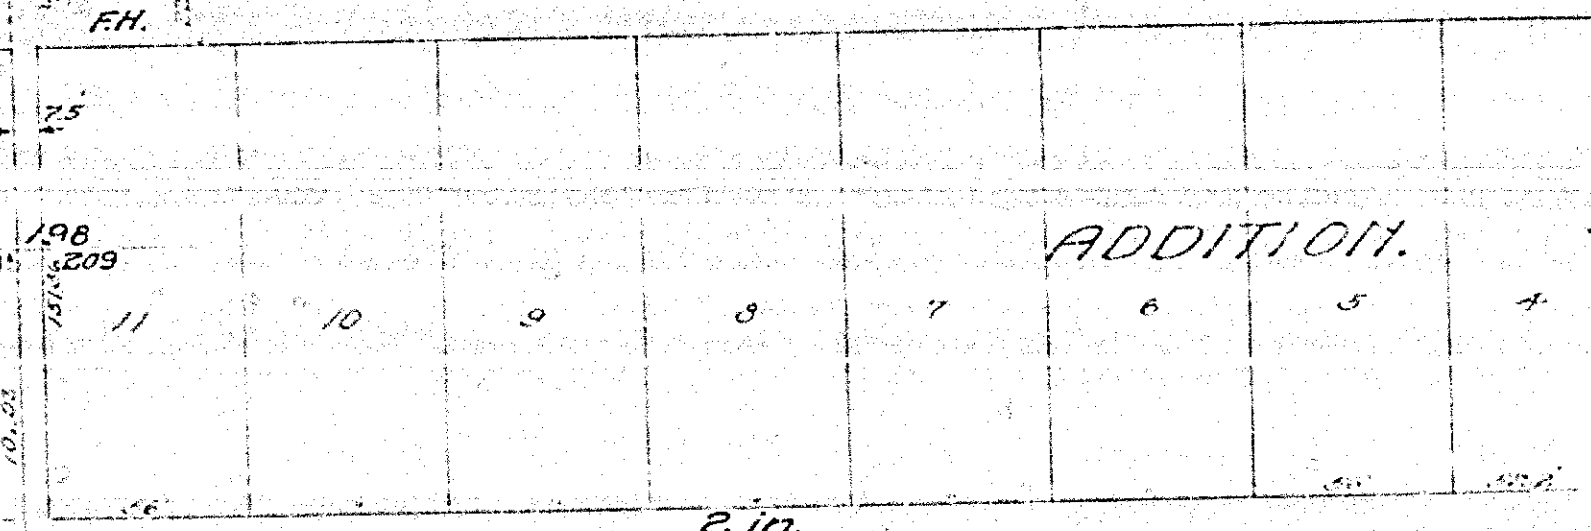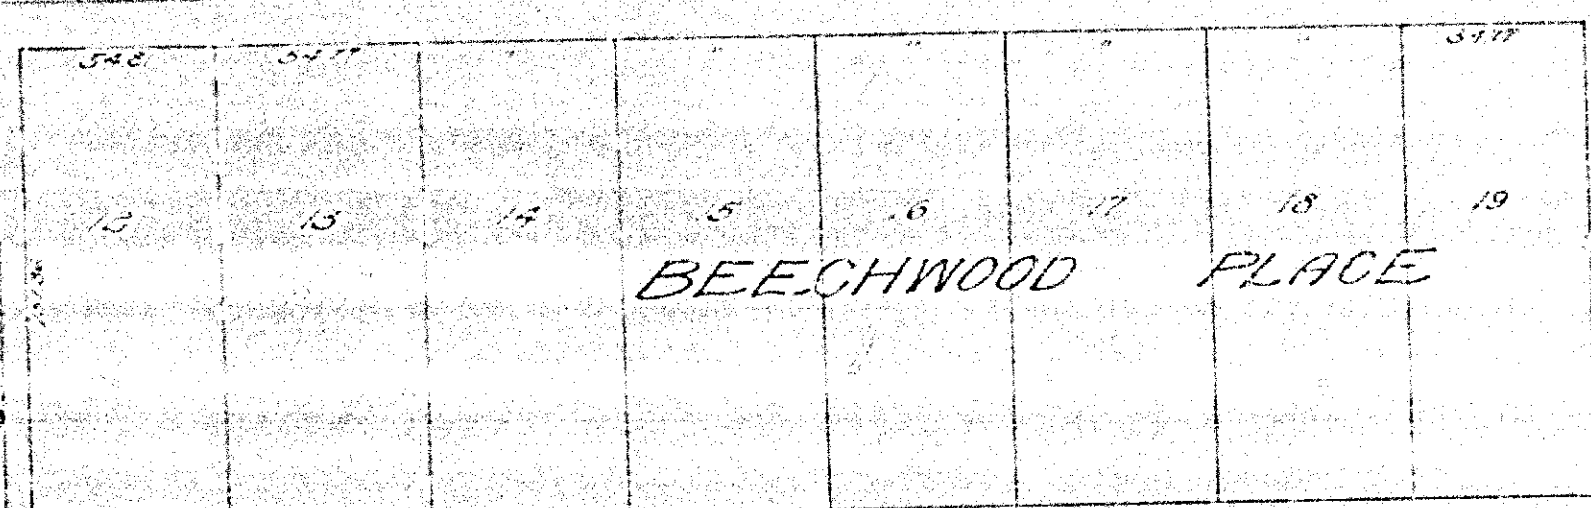

NEW MAGNOLIA AVE.

NEW MAGNOLIA AVE.

887A

A 288