

File with # 895-A

# PLAN AND PROFILE

OF THE PROPOSED IMPROVEMENT OF

## ELMWOOD COURT


BETWEEN MAGNOLIA AVE. & BROCKTON AVE.

ENG. DEPT. CITY OF RIVERSIDE 1935.


CITY (U. S. G. S.) DATUM PLANE

FIELD BOOK 307. PAGES 12-18.

Aug. 1935  
Constructed by Street Dept. 1936

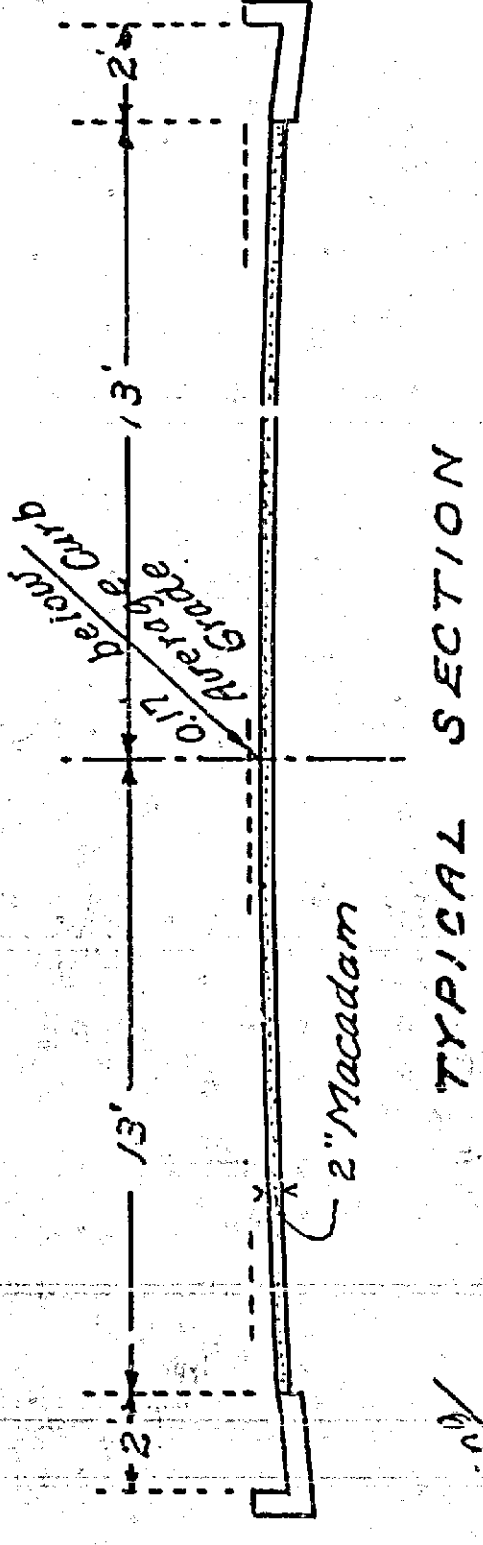

SCALE HOR. 1"=40'  
VER. 1"=4'

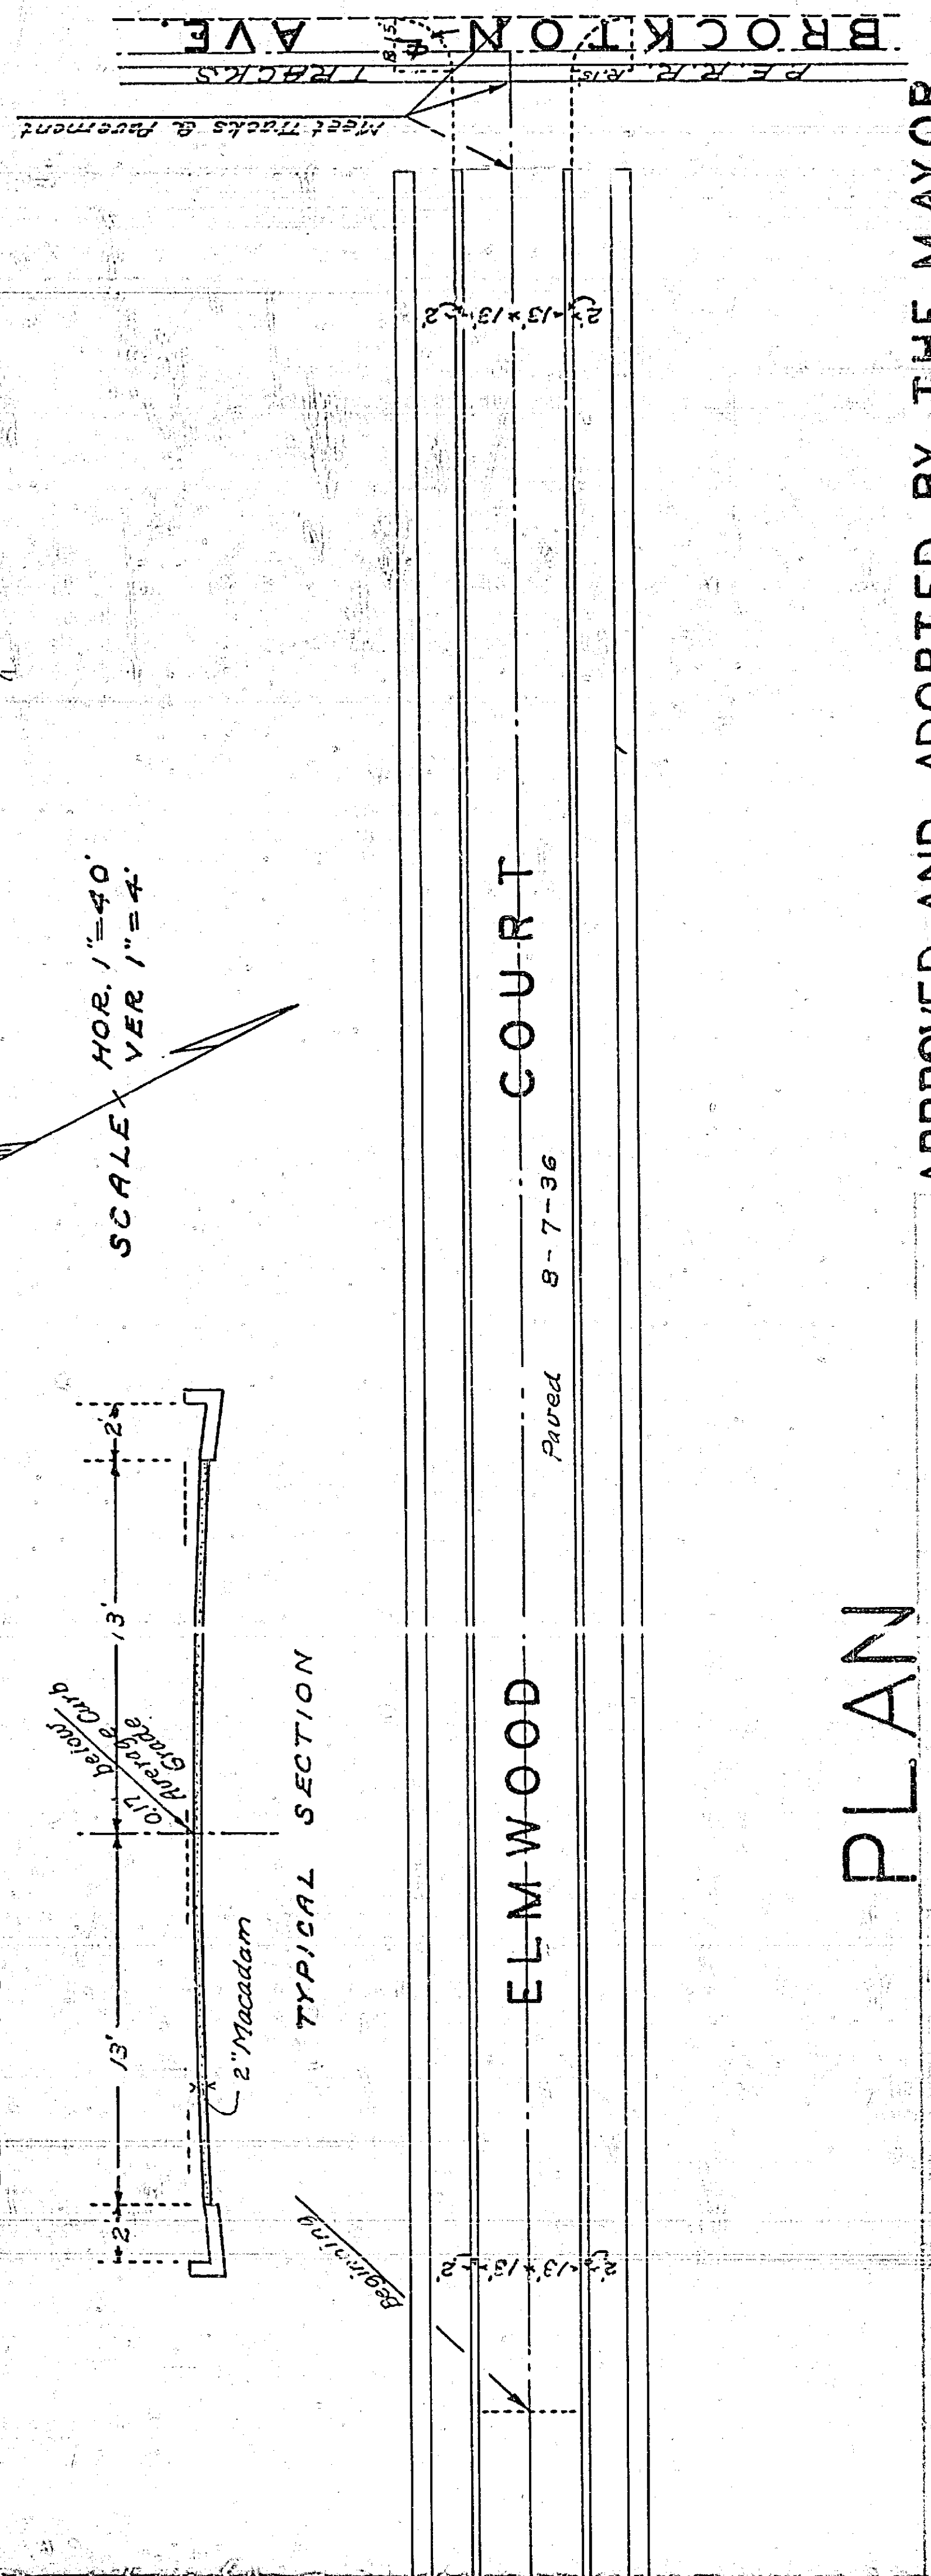


## PLAN

APPROVED AND ADOPTED BY THE MAYOR  
AND COUNCIL OF THE CITY OF RIVERSIDE  
THIS 25TH DAY OF JUNE 1935.

*J. O. Stevens*  
CITY CLERK. CITY OF RIVERSIDE.

## PROFILE

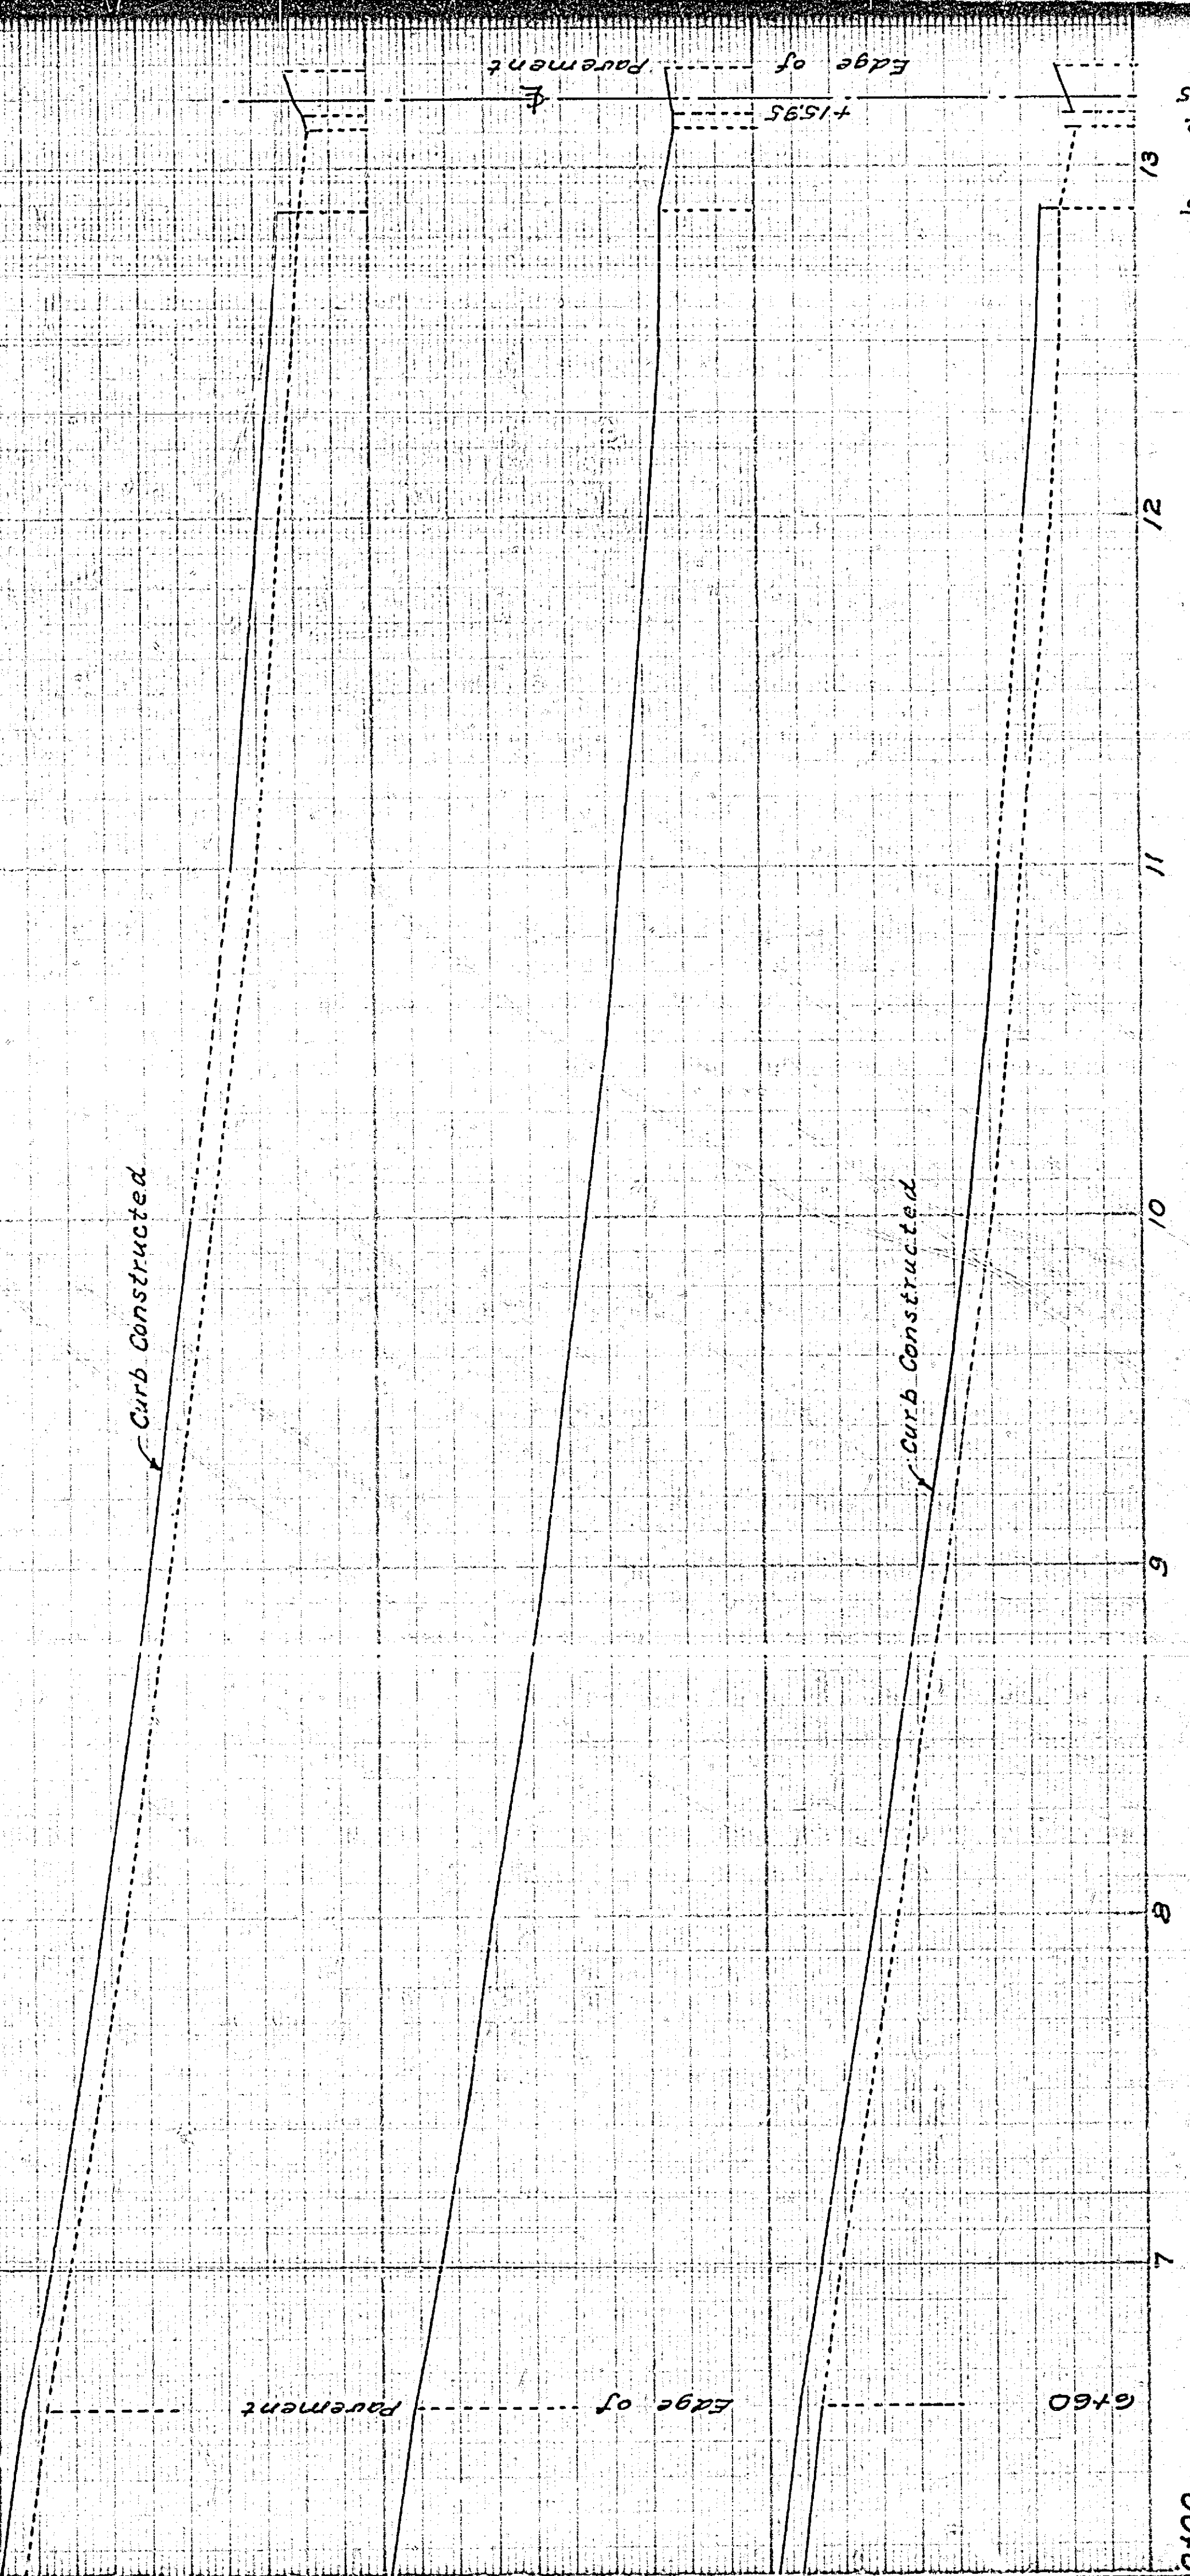

0100  
MAGNOLIA AVE.

+106.85  
+112.2  
+119.85  
+129

7 8 9 10 11 12 13

6460

Edge of Pavement

Curb Constructed

Curb Constructed

895-A

333

333

333