



22"  
17"  
11"  
58"  
8.5"  
11"  
17"  
22"

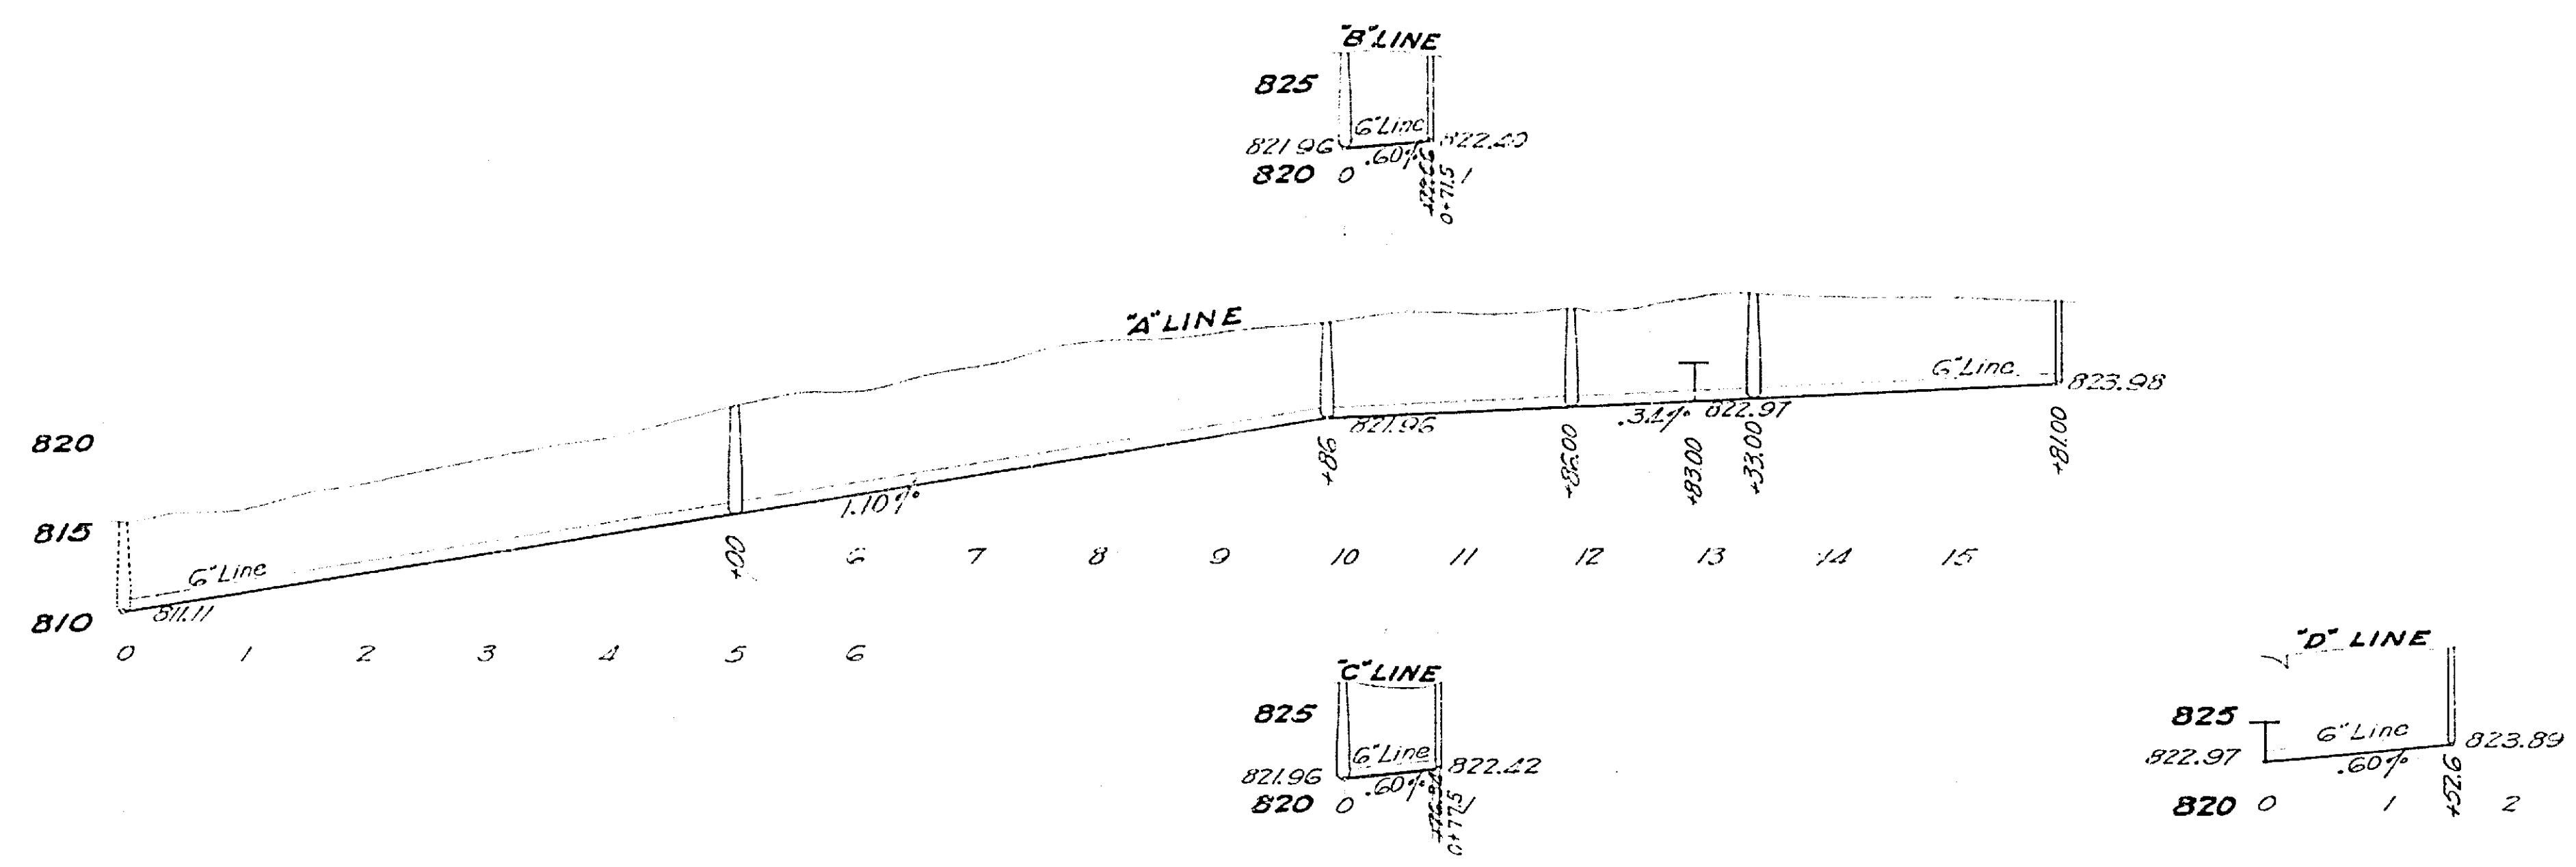

CITY OF RIVERSIDE ENG. DEPT.  
 PLAN AND PROFILE OF  
**RUBIDOUX CENTRAL SEWER EXTENSION**  
 MAY 1935  
 F. B. 309 5-10

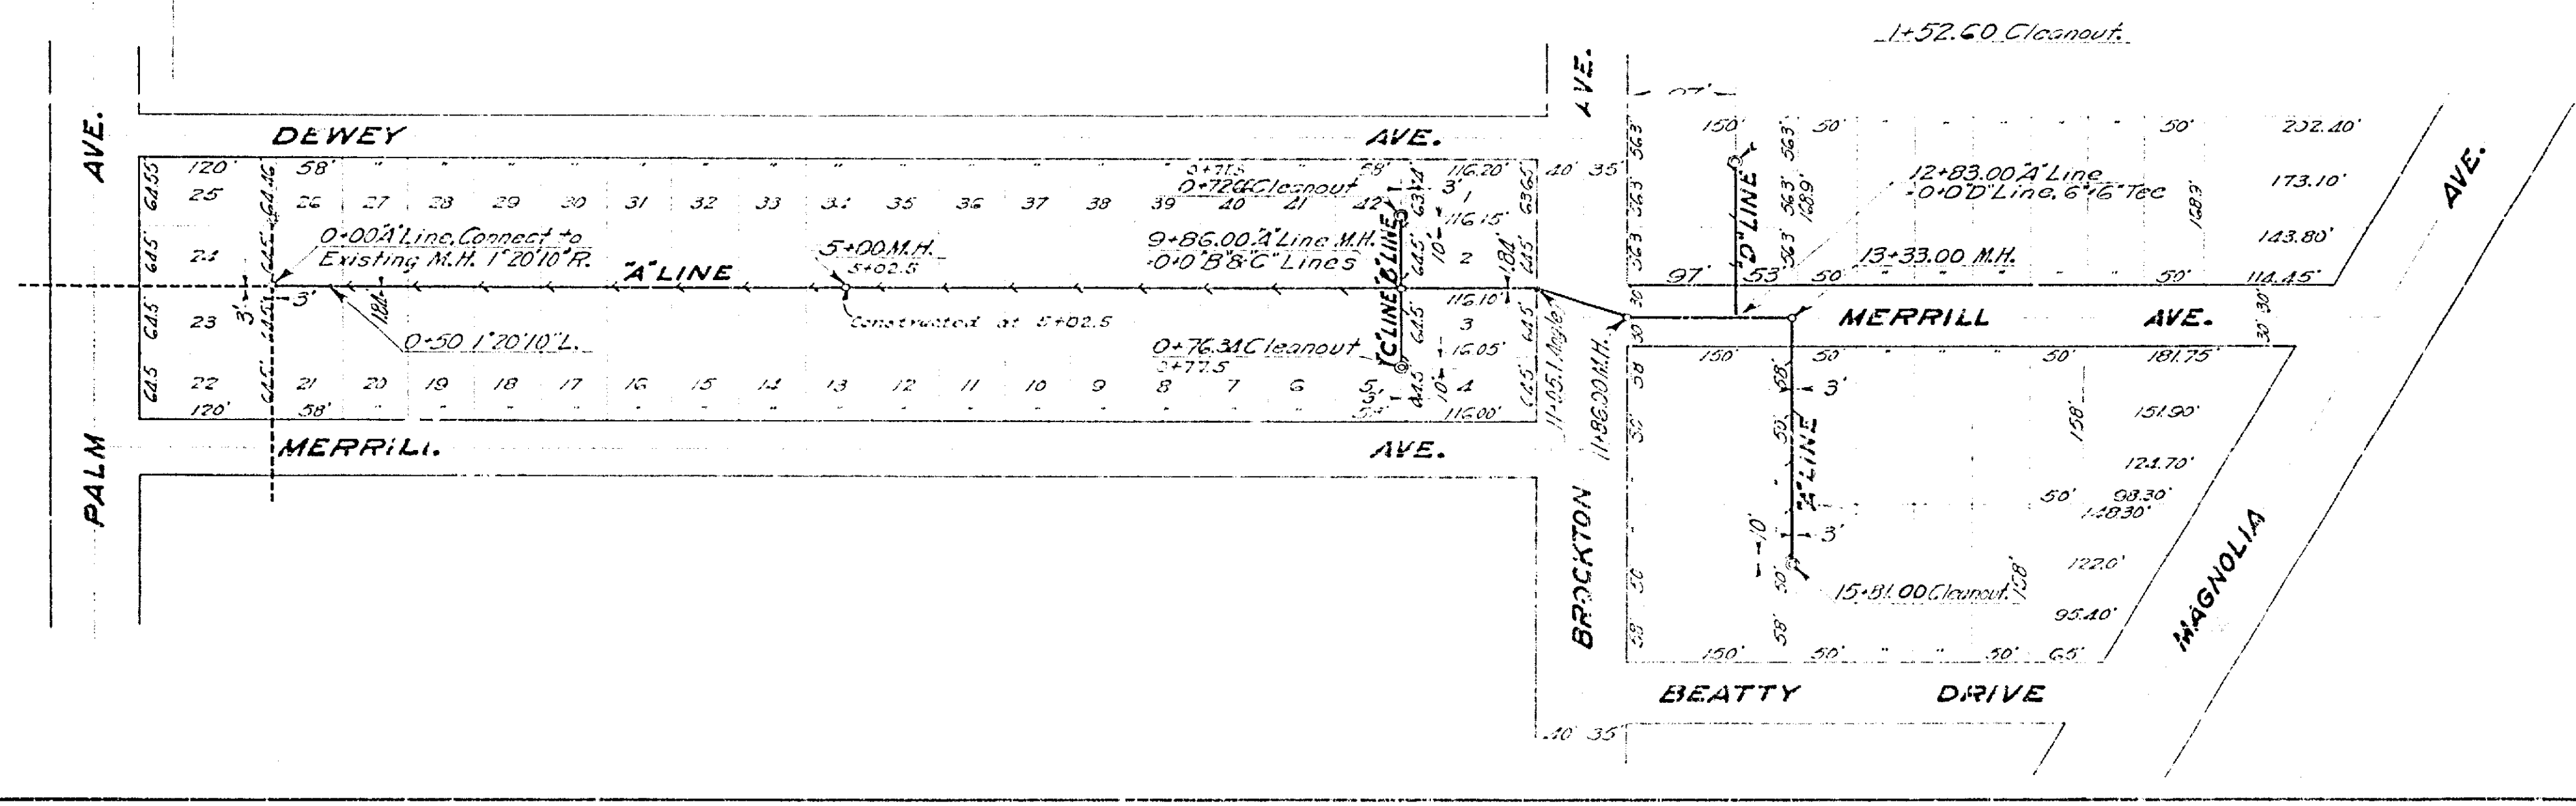

908A

35"  
11"  
82"  
28"  
11"  
21"