


22"  
11"  
11"  
8.5"  
11"  
8.5"  
6

Profile: Coolidge Ave. Drainage between Washington St & Mary St.  
Scale 1" = 50' F.B. #03, P. 20. Sept. 28, 47. M.L.


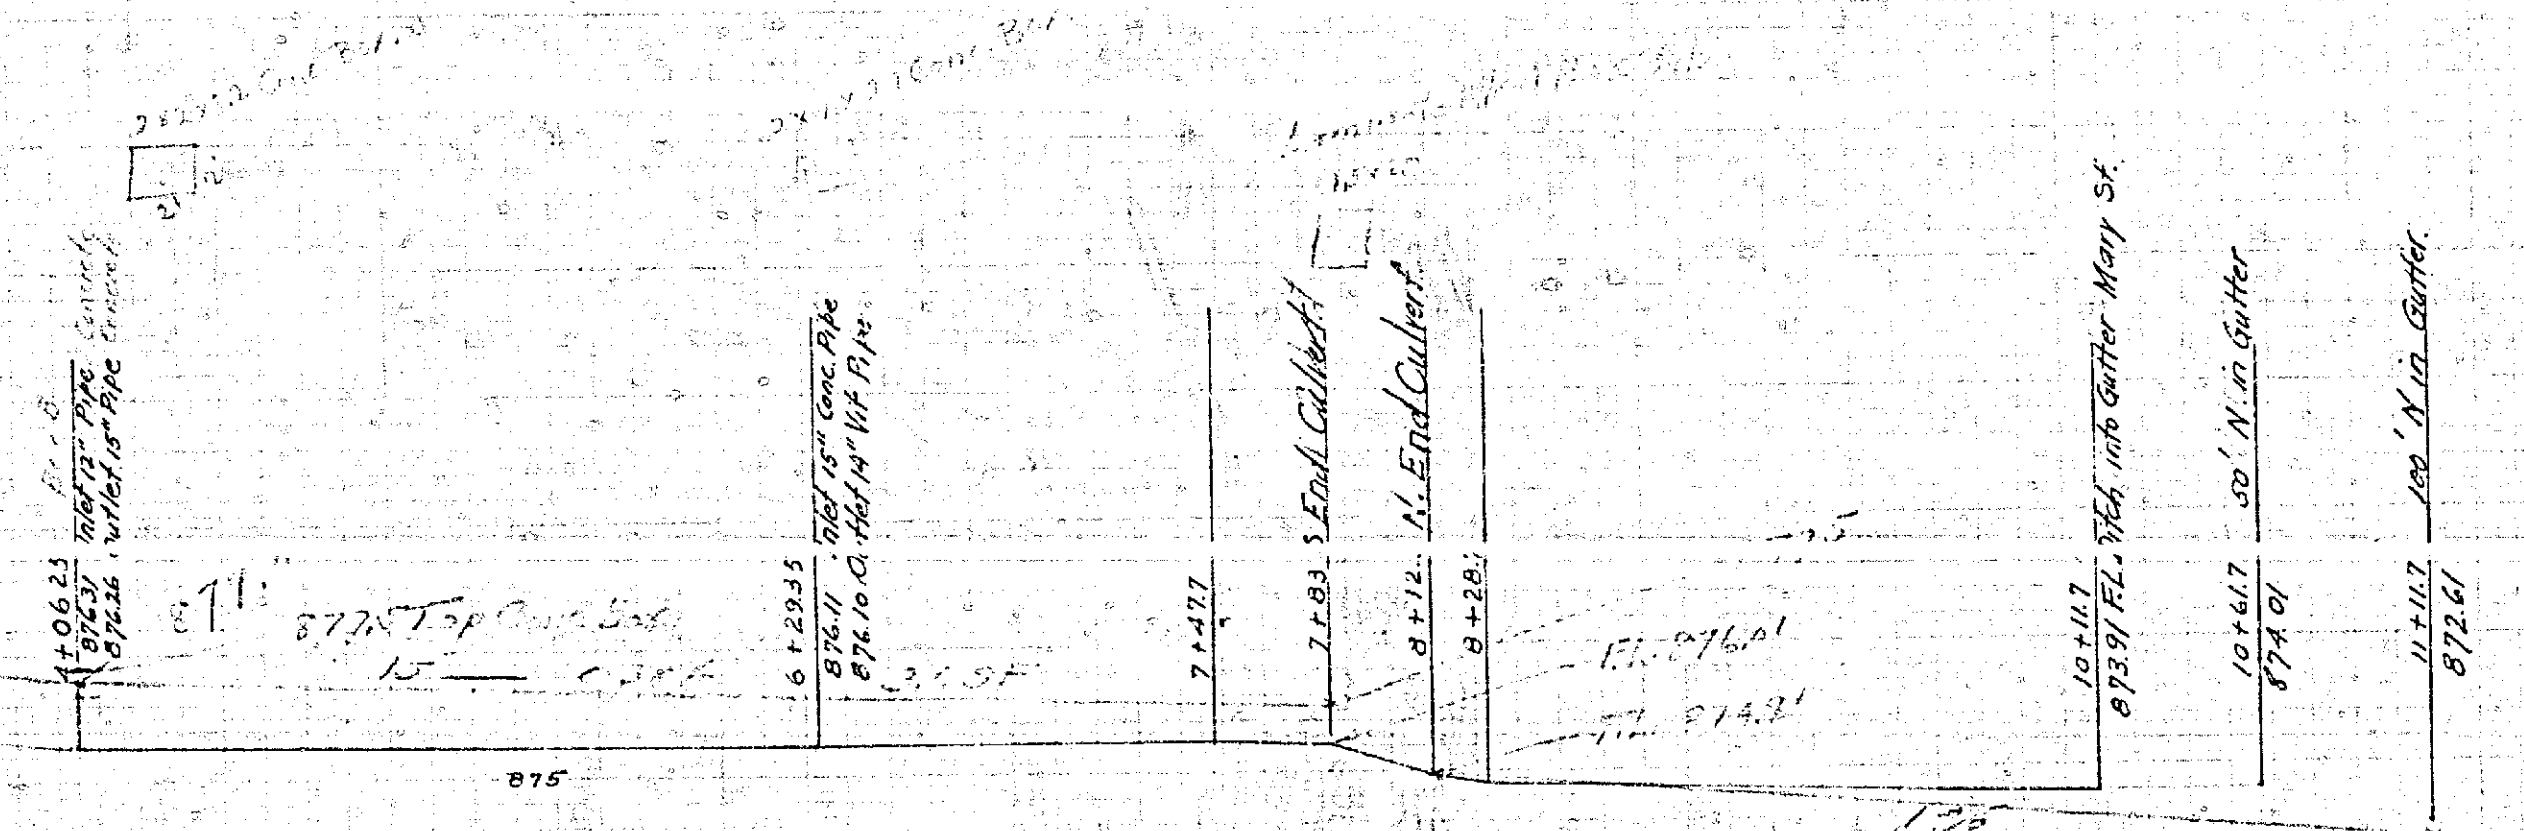

913A