


22"  
17"  
11"  
9.8"  
8.5"  
11"  
17"  
22"

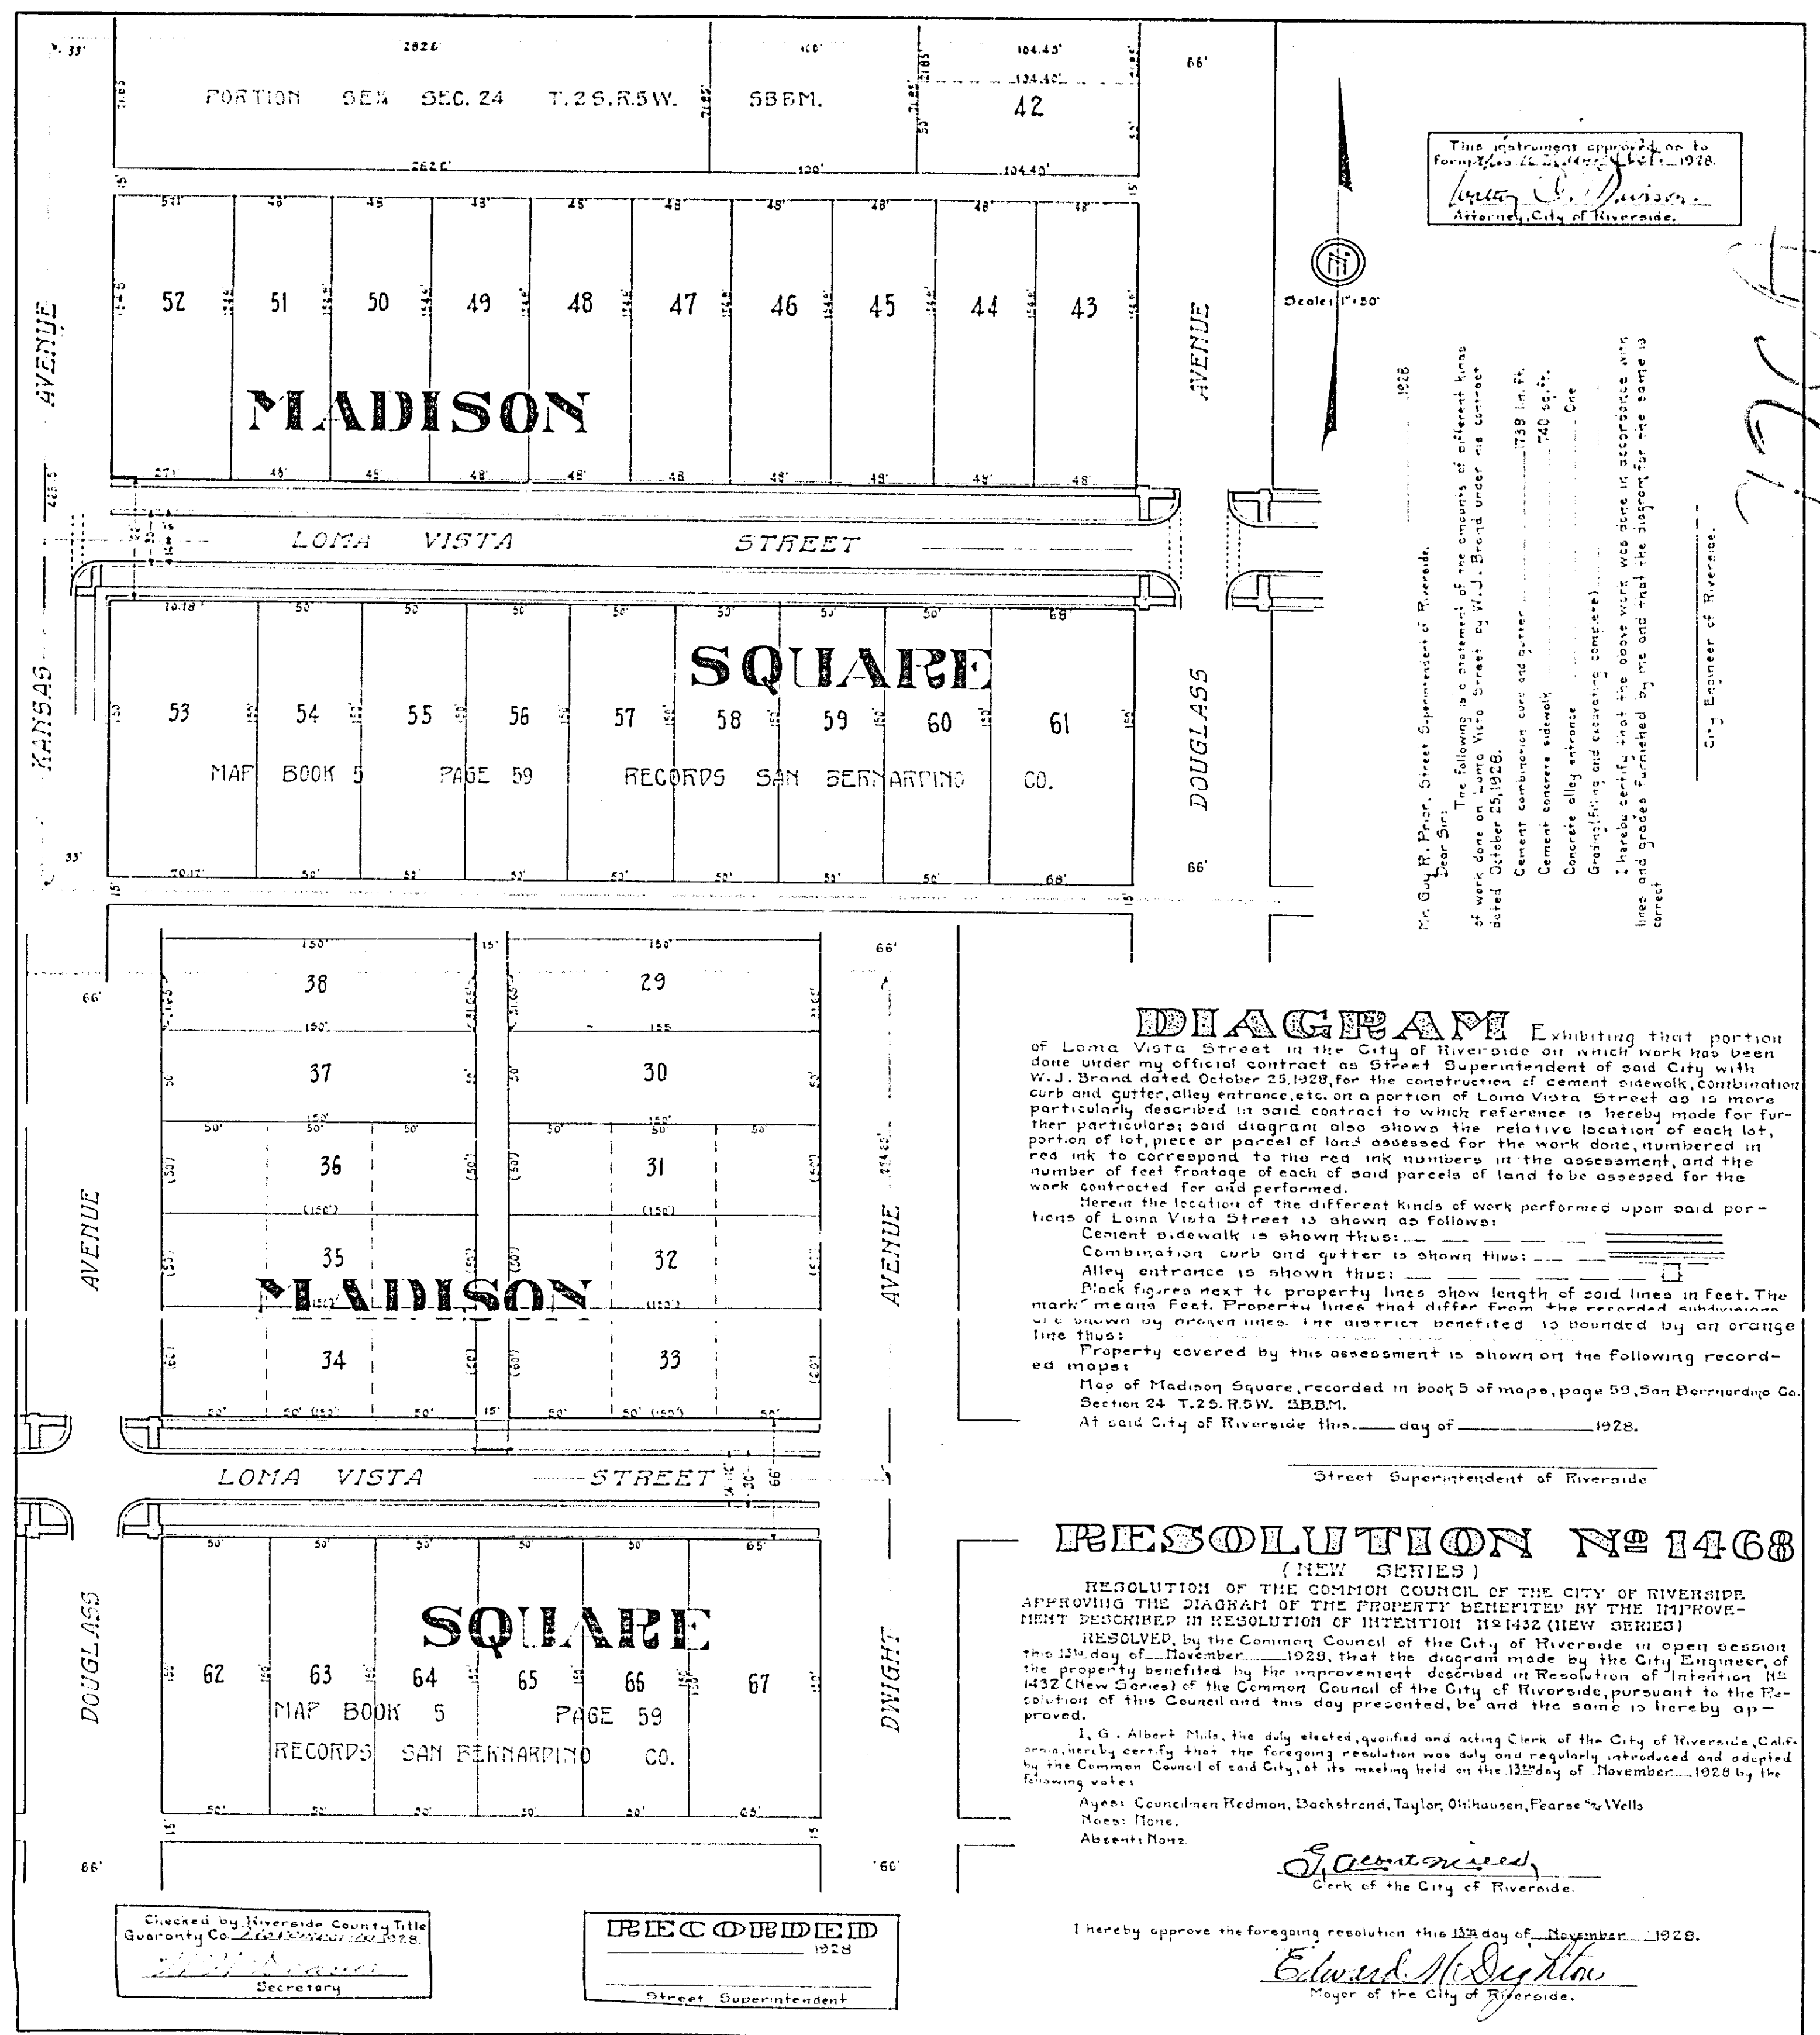

720A

33"  
11"  
8.2"  
11"  
11"  
11"