PROFILE

SCALES: HOR-1"=40'
VERT-1"=4'

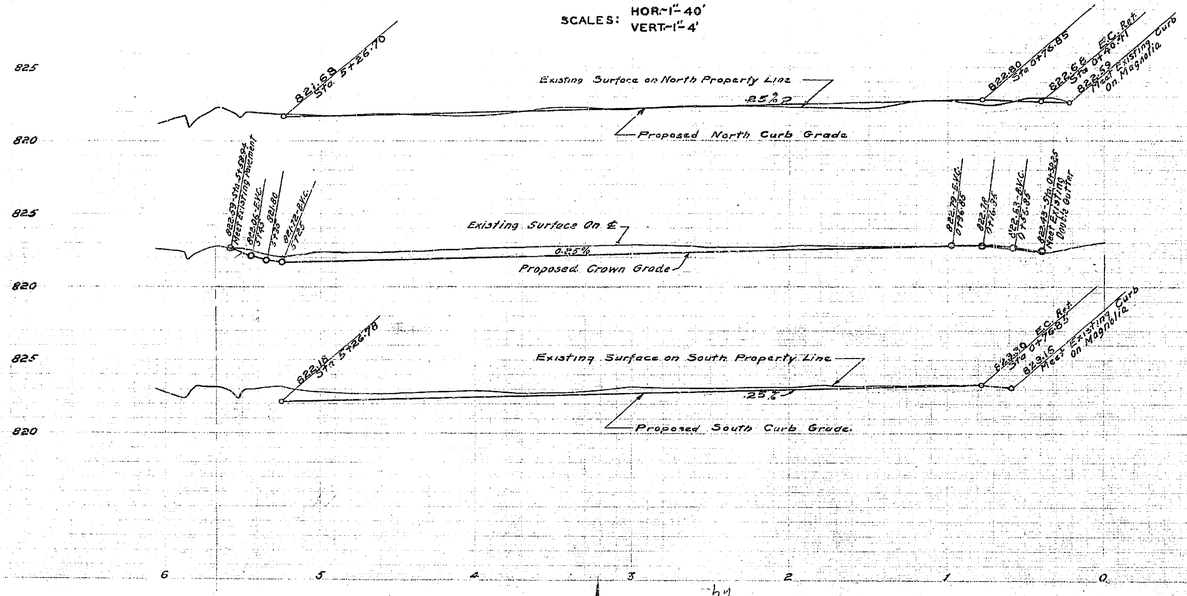

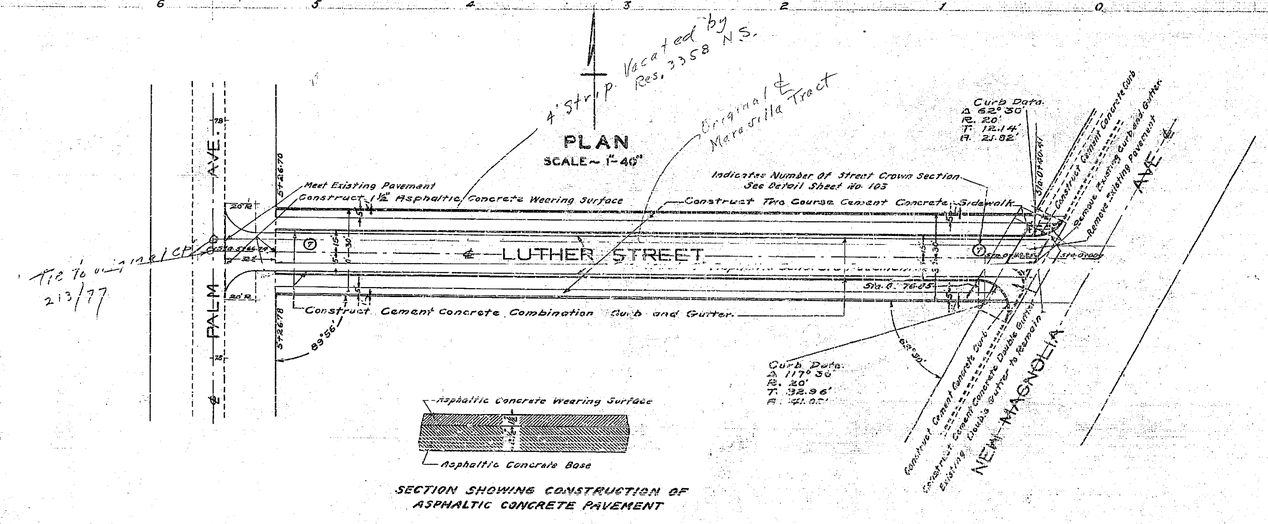

SECTION SHOWING CONSTRUCTION OF ASPHALTIC CONCRETE PAVEMENT

PLANS AND PROFILES

OF THE PROPOSED STREET IMPROVEMENT OF

LUTHER STREET

BETWEEN NEW MAGNOLIA AVENUE AND PALM AVENUE

AND PORTIONS OF

NEW MAGNOLIA AVENUE AND PALM AVENUE

ENGINEERING DEPARTMENT, CITY OF RIVERSIDE JULY 1930

Constructed by Contractor 1930.

PLANS PROFILES AND MAPS NUMBER 952 CONSISTING OF 2 SHEETS

SHEET NUMBERED 1 STREET IMPROVEMENT OF LUTHER STREET BETWEEN NEW MAGNOLIA AVENUE AND PALM AVENUE AND PORTIONS OF NEW MAGNOLIA AVENUE AND PALM AVENUE

SHEET NUMBERED (170) MAP OF THE DISTRICT TO BE ASSESSED FOR THE IMPROVEMENTS

INSTRUCTIONS TO CONTRACTOR

FOLDER CONTAINING INSTRUCTIONS TO CONTRACTOR AND DETAIL PLANS NUMBERED 103 108 ARE A PART OF THESE PLANS AND SPECIFICATIONS

ELEVATIONS SHOWN HEREON ARE U.S.G.S. DATUM.

FIELD BOOKS

BOOK 213 PAGES 59 TO 72

ADOPTED BY THE MAYOR AND COUNCIL OF THE CITY OF RIVERSIDE
THIS 9th DAY OF JULY 1930

CITY CLERK, CITY OF RIVERSIDE

952

SHEET NO 1