




PLAN No. 965-E
 FOR THE CONSTRUCTION OF
 CURBS & GUTTERS
 ON
ANNA STREET
 RIVERSIDE, CALIFORNIA
 OCTOBER 1954
 SCALES: Hor. 1/4" = 50 FT.
 Vert. 1/4" = 5 FT.
 F.B. 552-13
 APPROVED: *M. H. Irvine*
 M. H. IRVINE-REG. C.E. 3011
 CITY ENGINEER

Revised 3-2-58 to show construction for Hope Lutheran Church wdg.

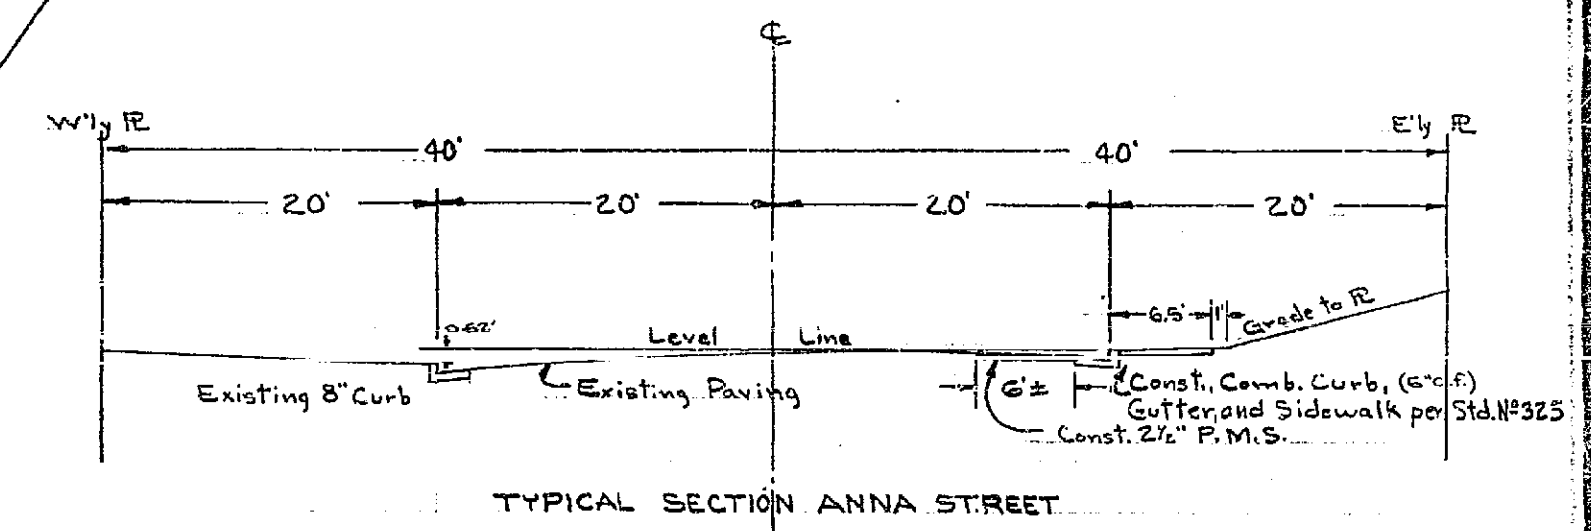

B.M. EL. 94417 Spike in Wly HW Culvert on Sly Side of Lincoln F.B. 560-35

B.M. EL. 930.8 X ON HINGE NO. SIDE 48\"/>

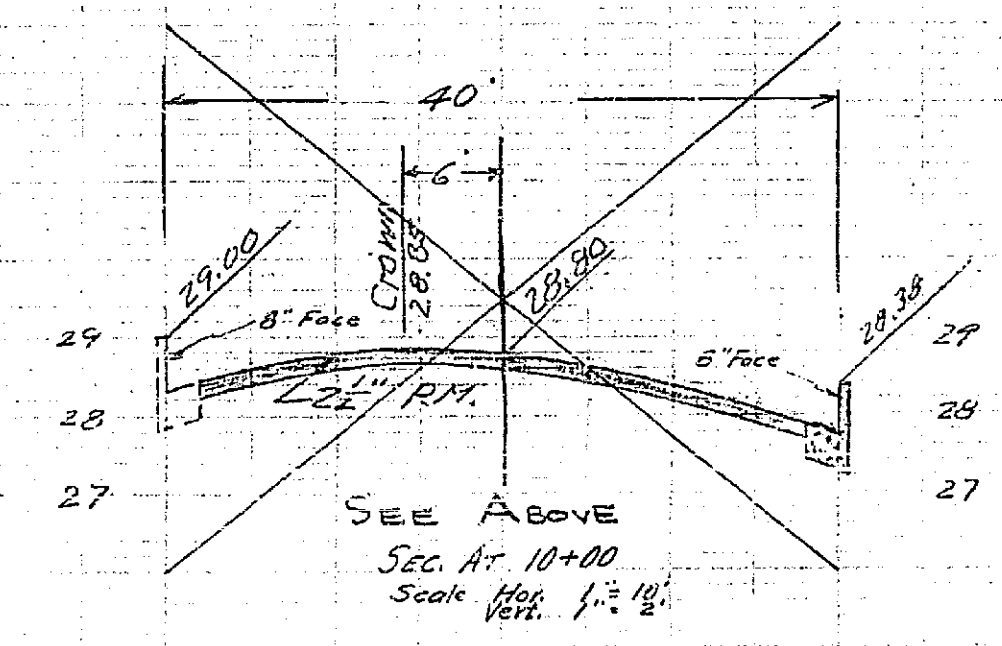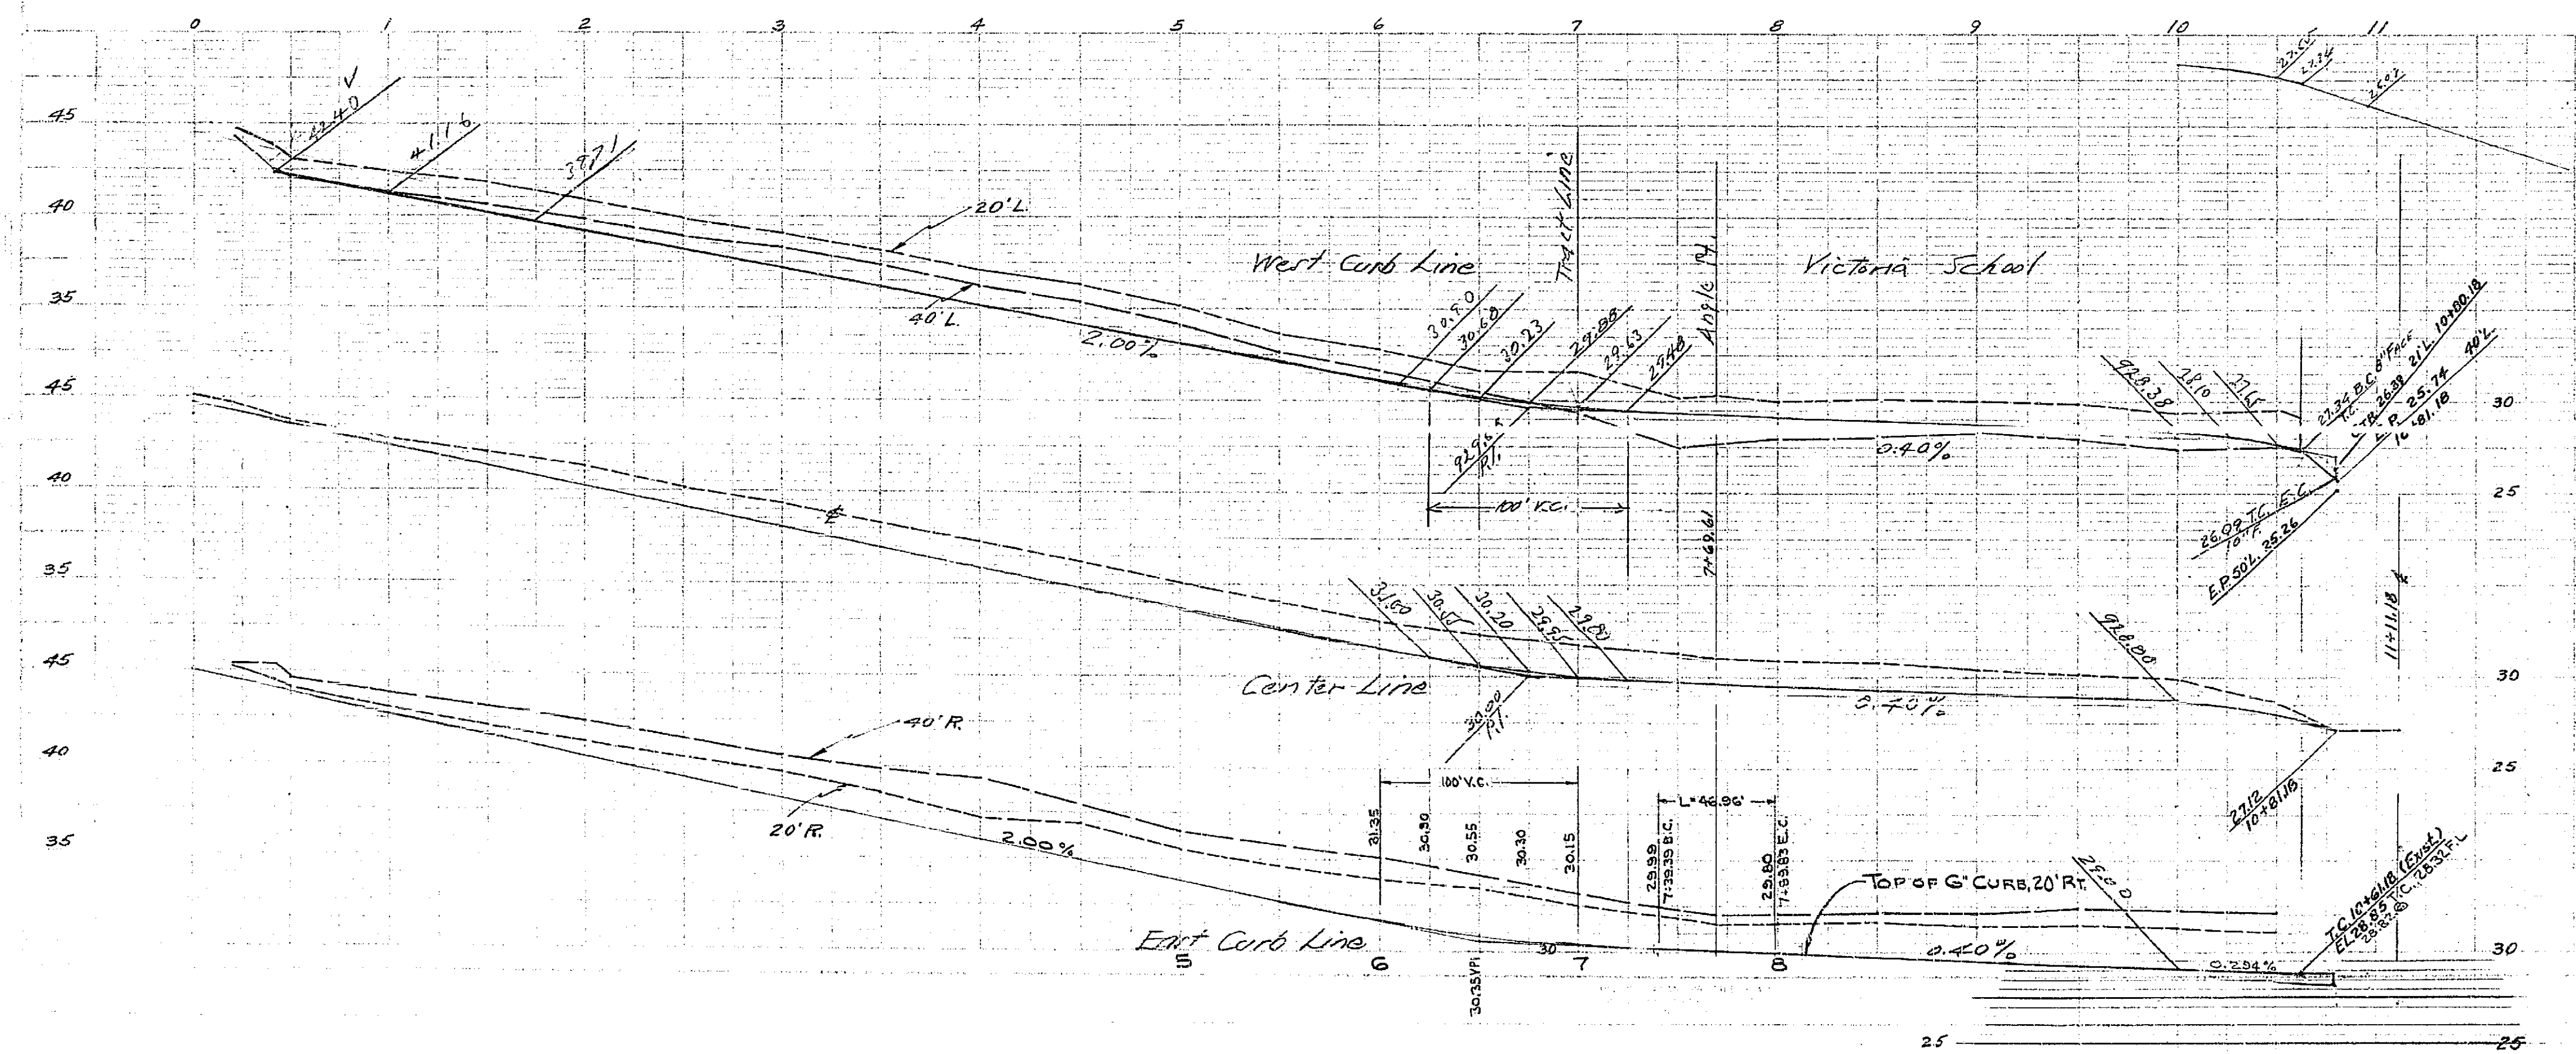

965E