
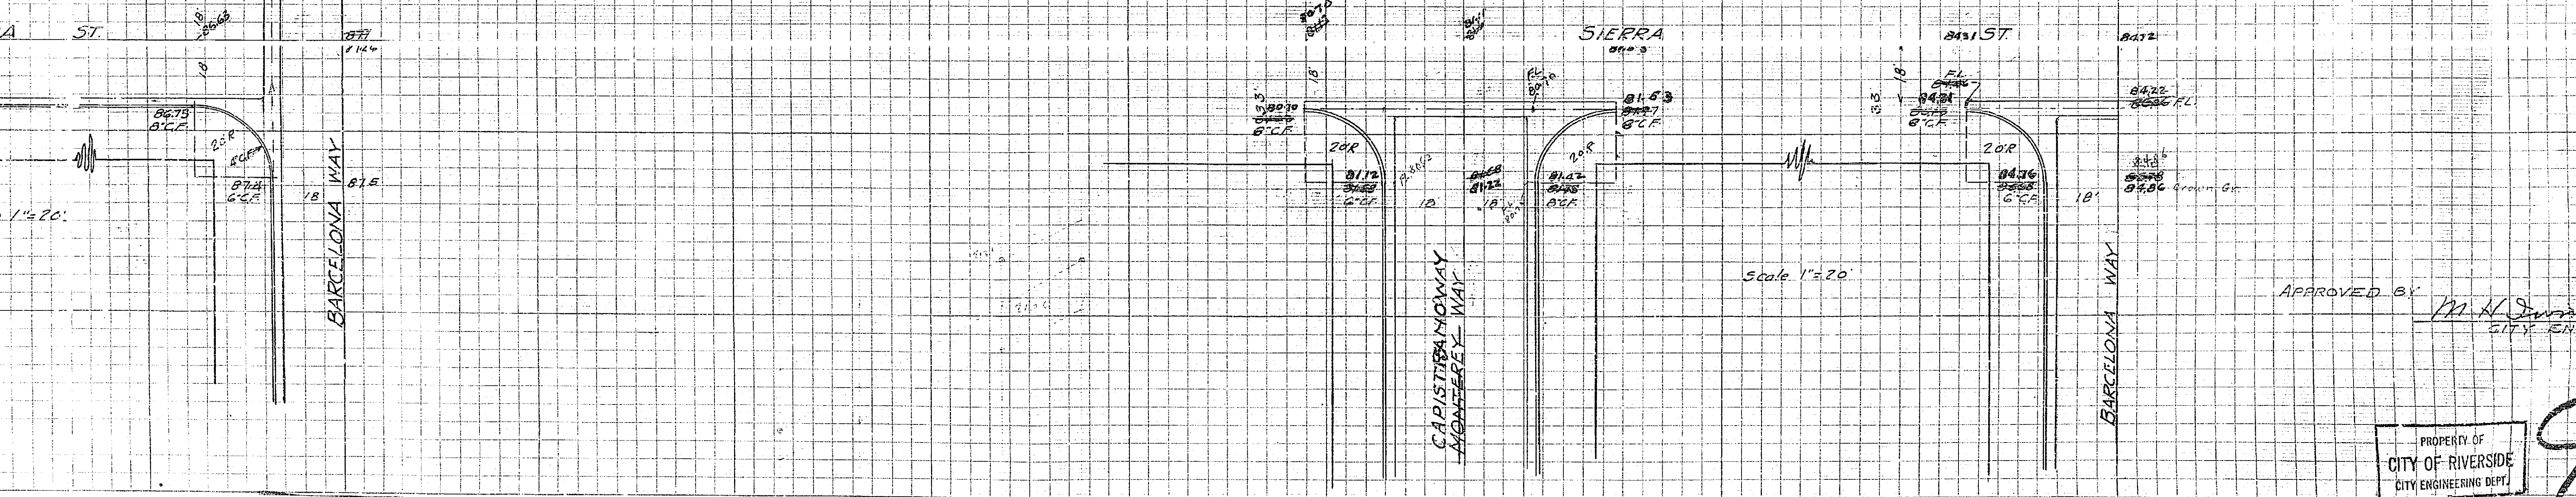


HARDMAN TRACT  
STREET LAYOUT  
Sheet #1

PROPERTY OF  
CITY OF RIVERSIDE  
CITY ENGINEERING DEPT.

PROFILE SIERRA ST.

Scale 1"=40' Hor.  
1"=4' Vert.

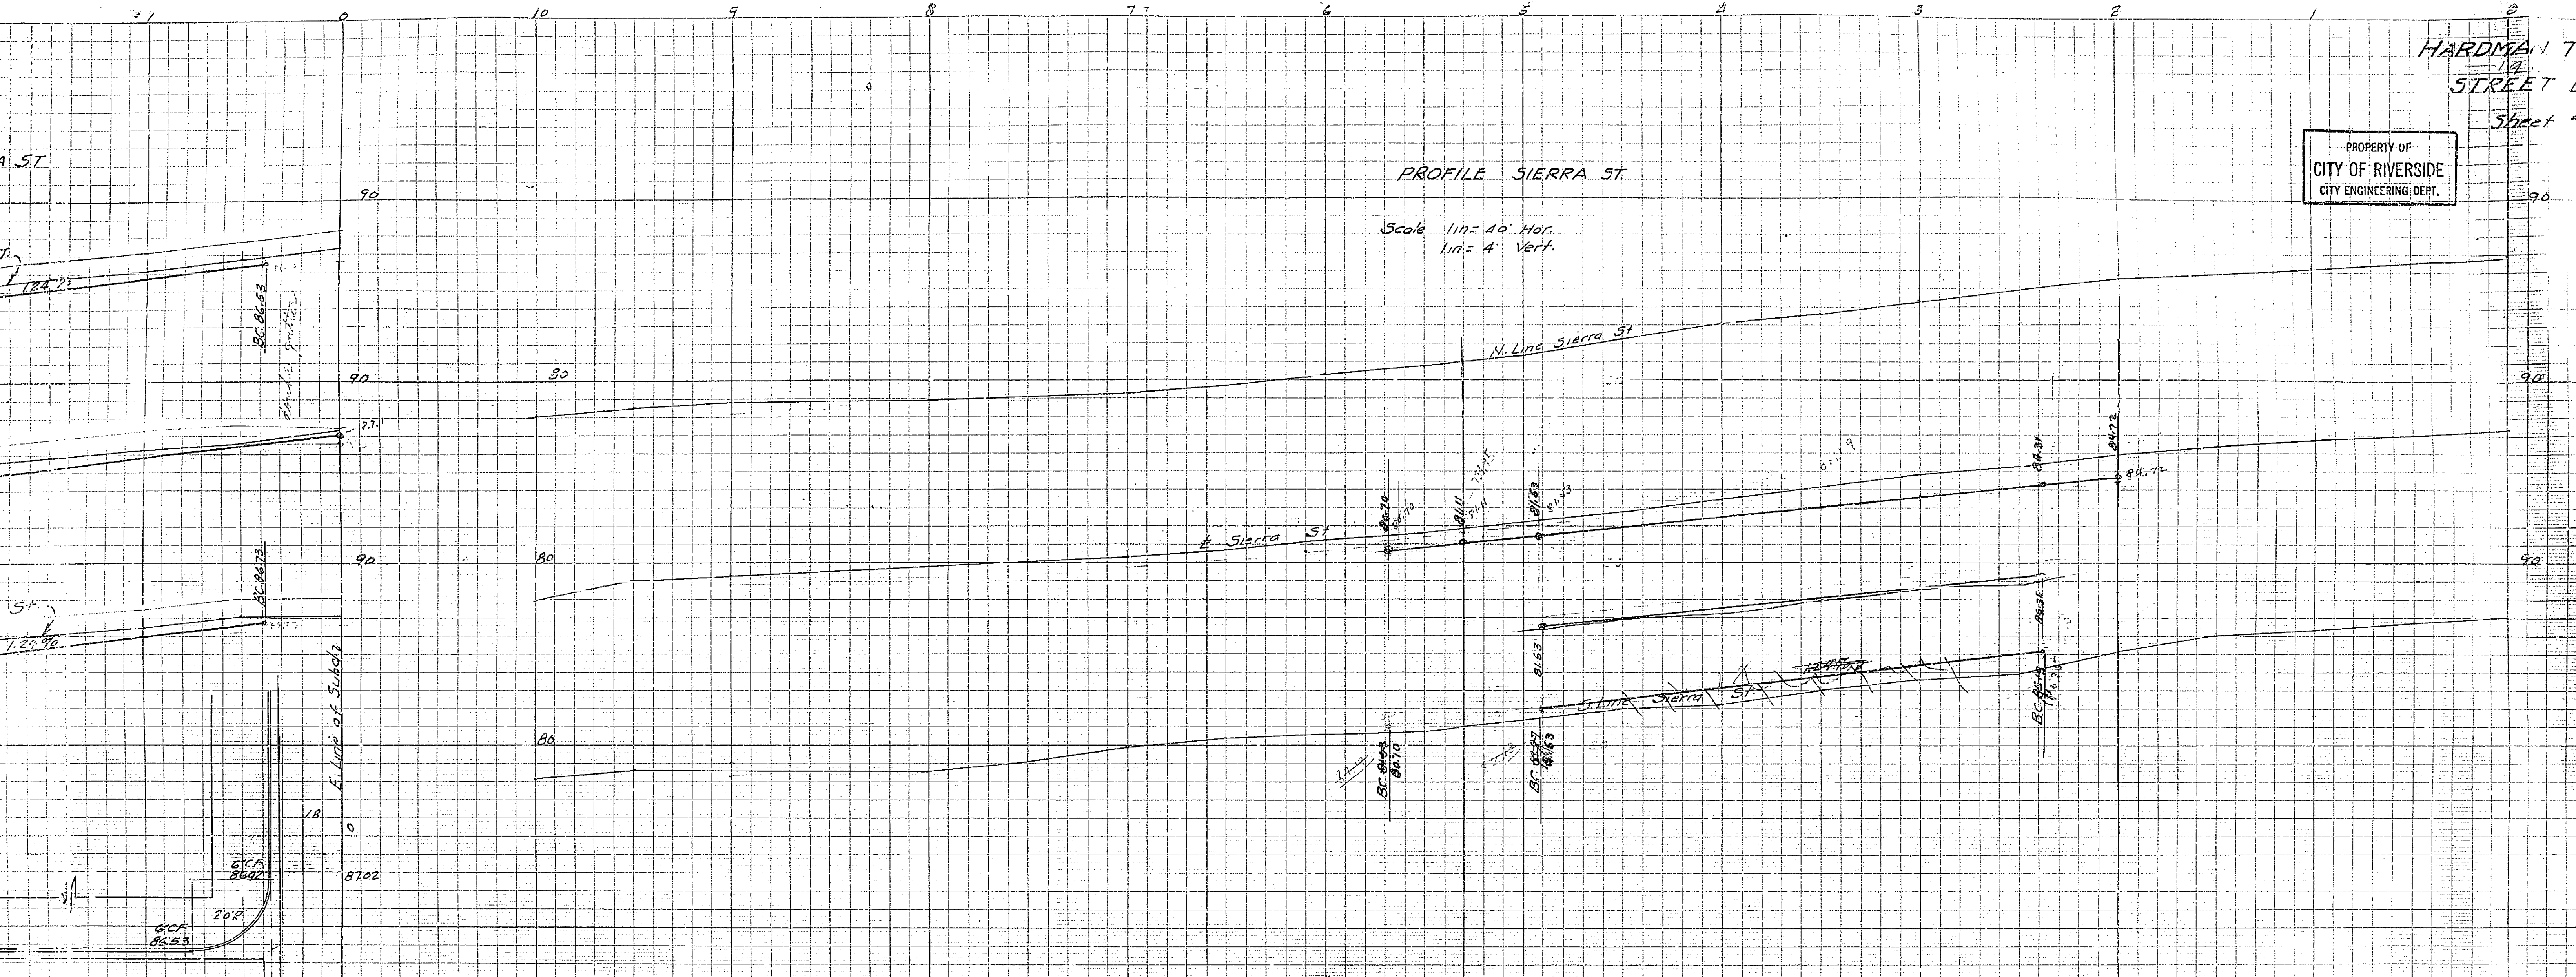

APPROVED BY: *M. H. Swann*  
CITY ENGINEER

PROPERTY OF  
CITY OF RIVERSIDE  
CITY ENGINEERING DEPT.

970




← → FRAME 112

### PROFILE ARLINGTON AVE.

Scale 1" = 40' Hor.  
1" = 4' Vert.

### PROFILE GRANADA

Scale 1" = 40' Hor.  
1" = 4' Vert.

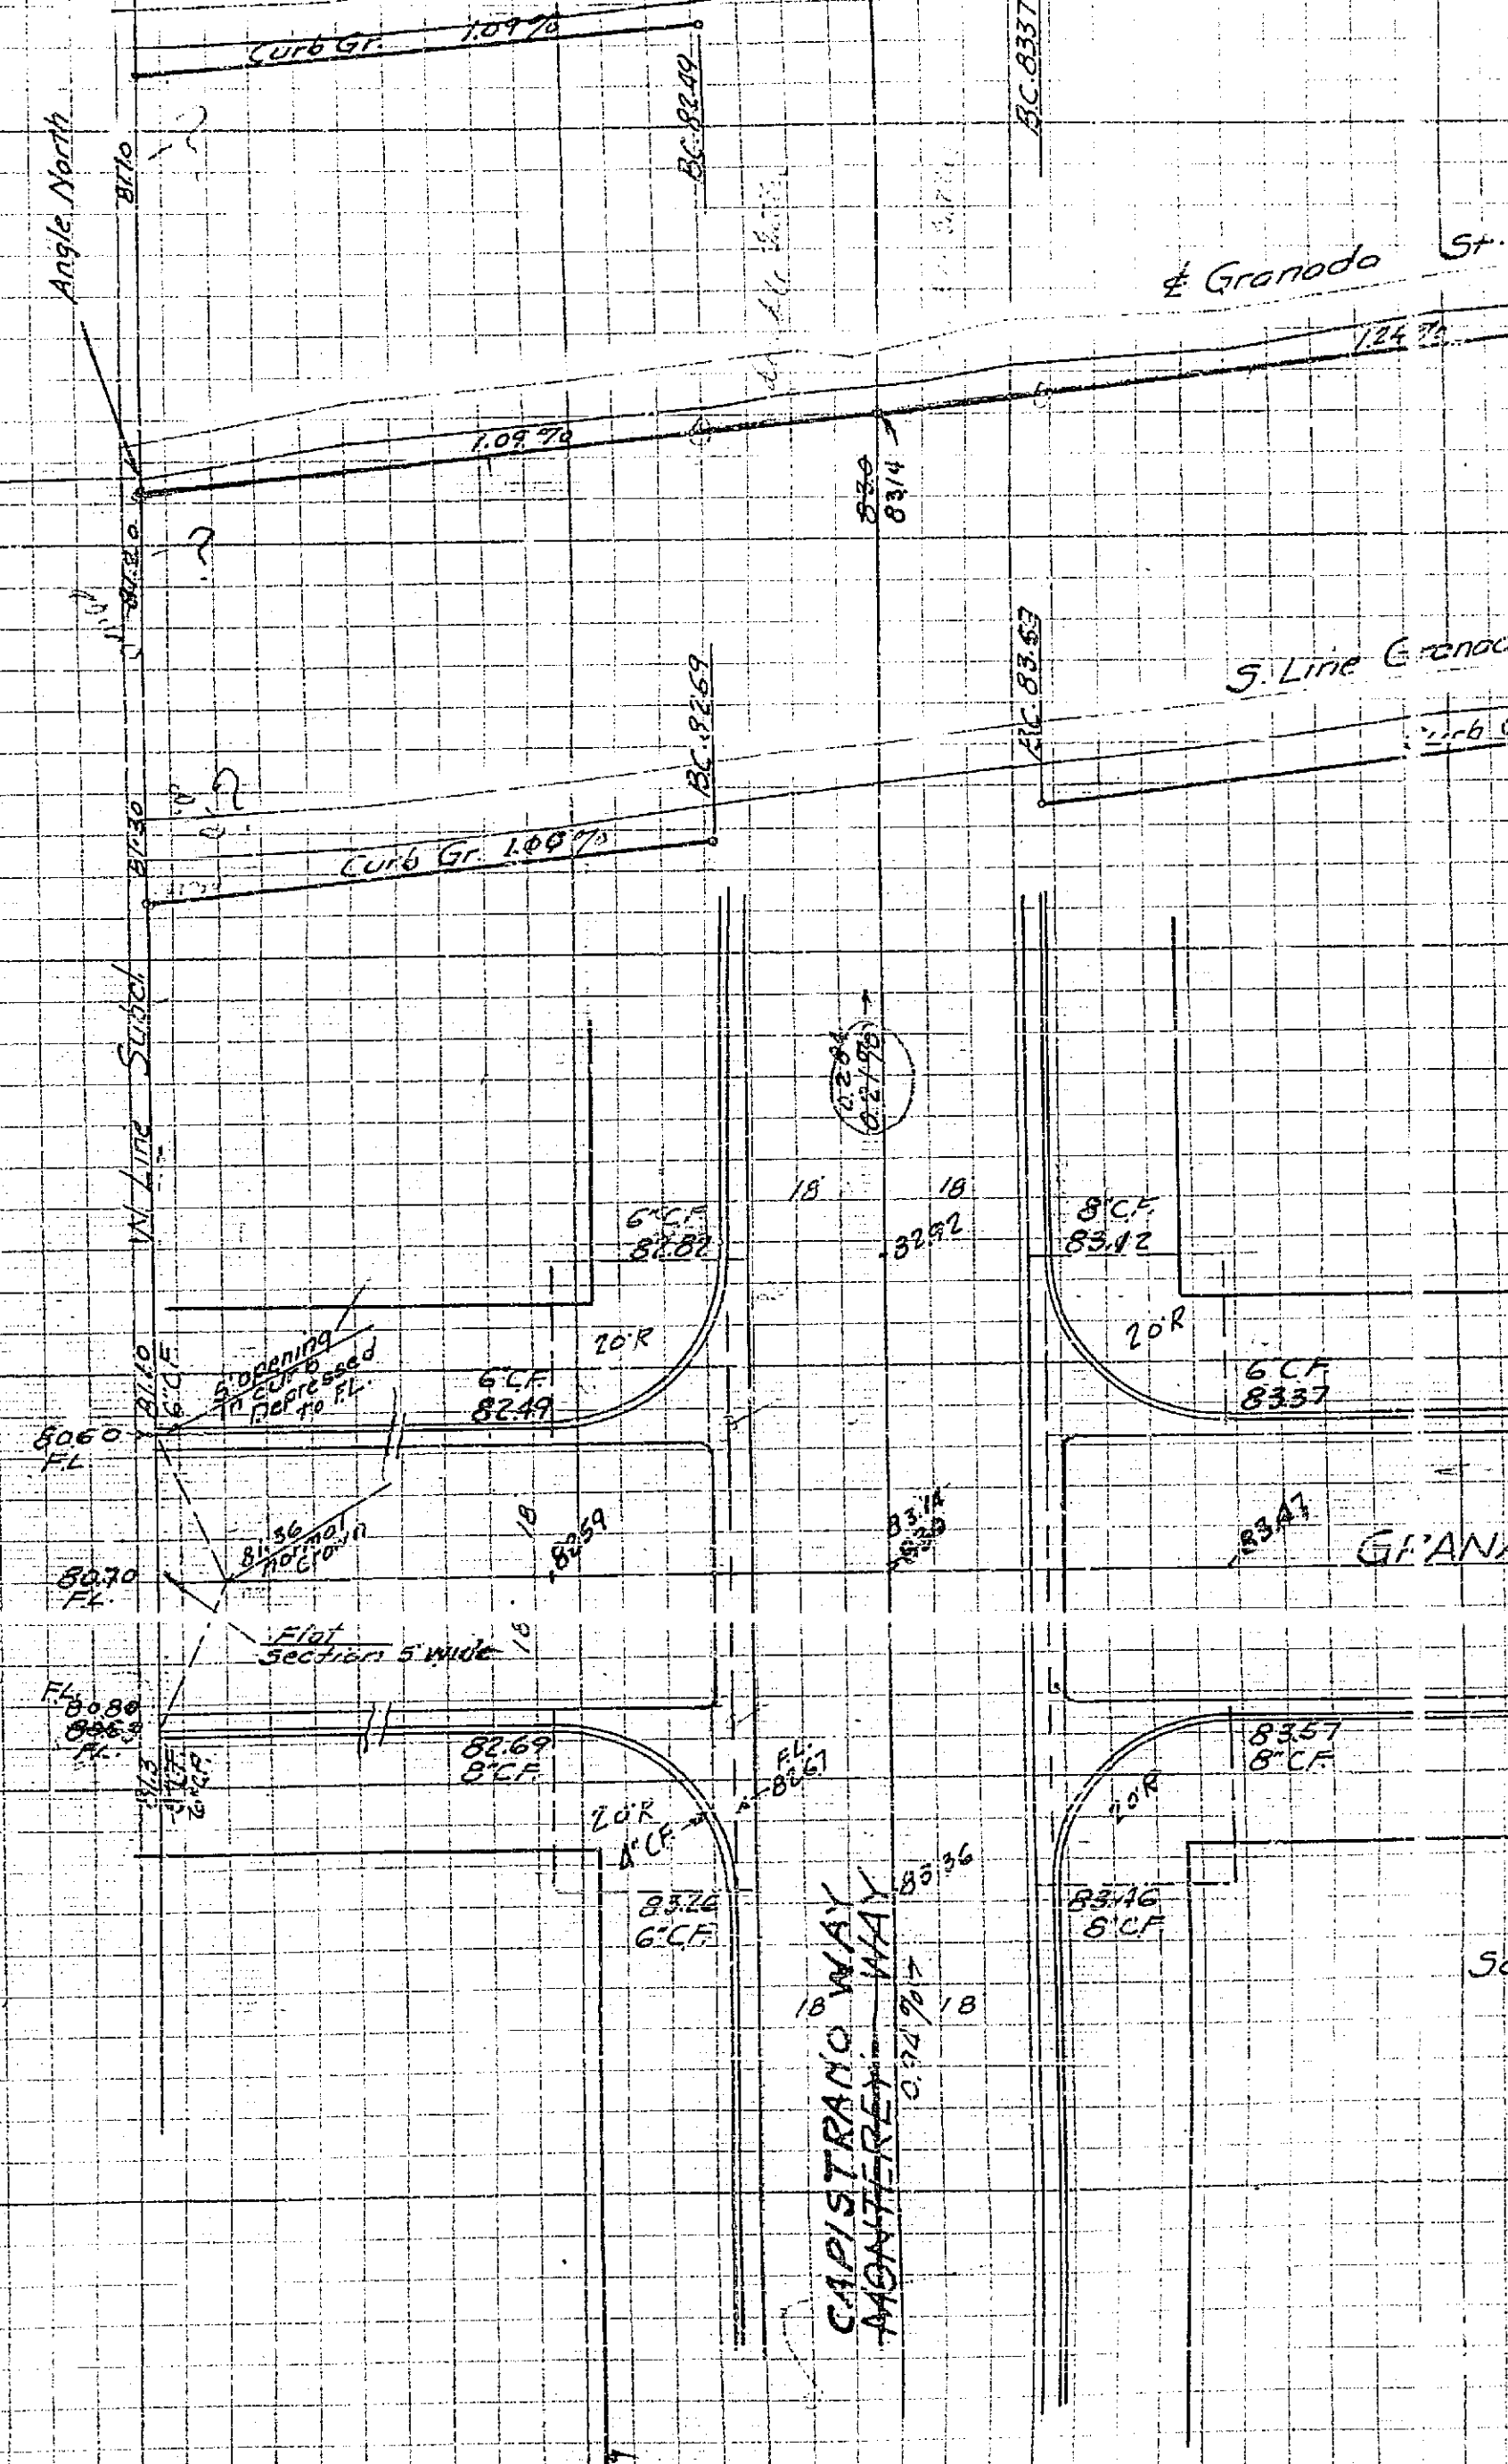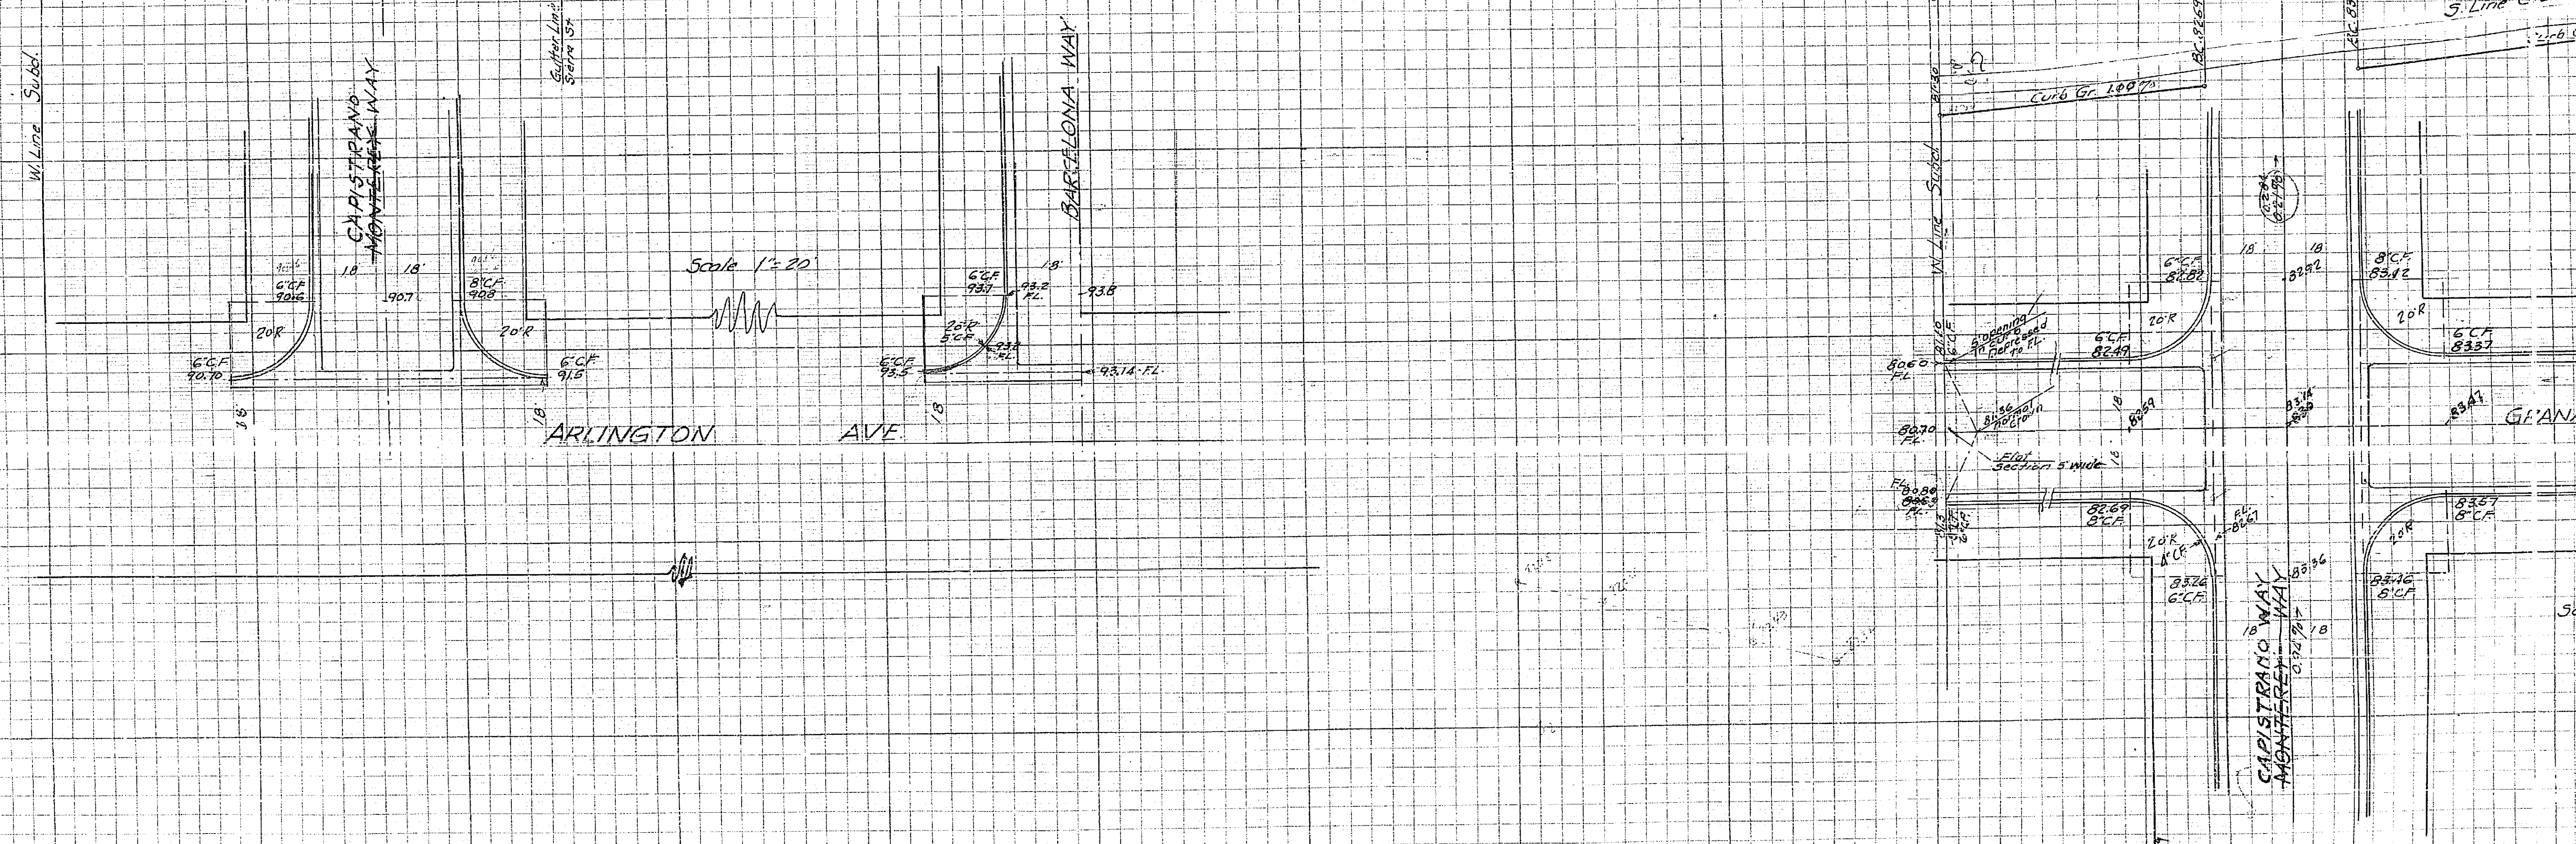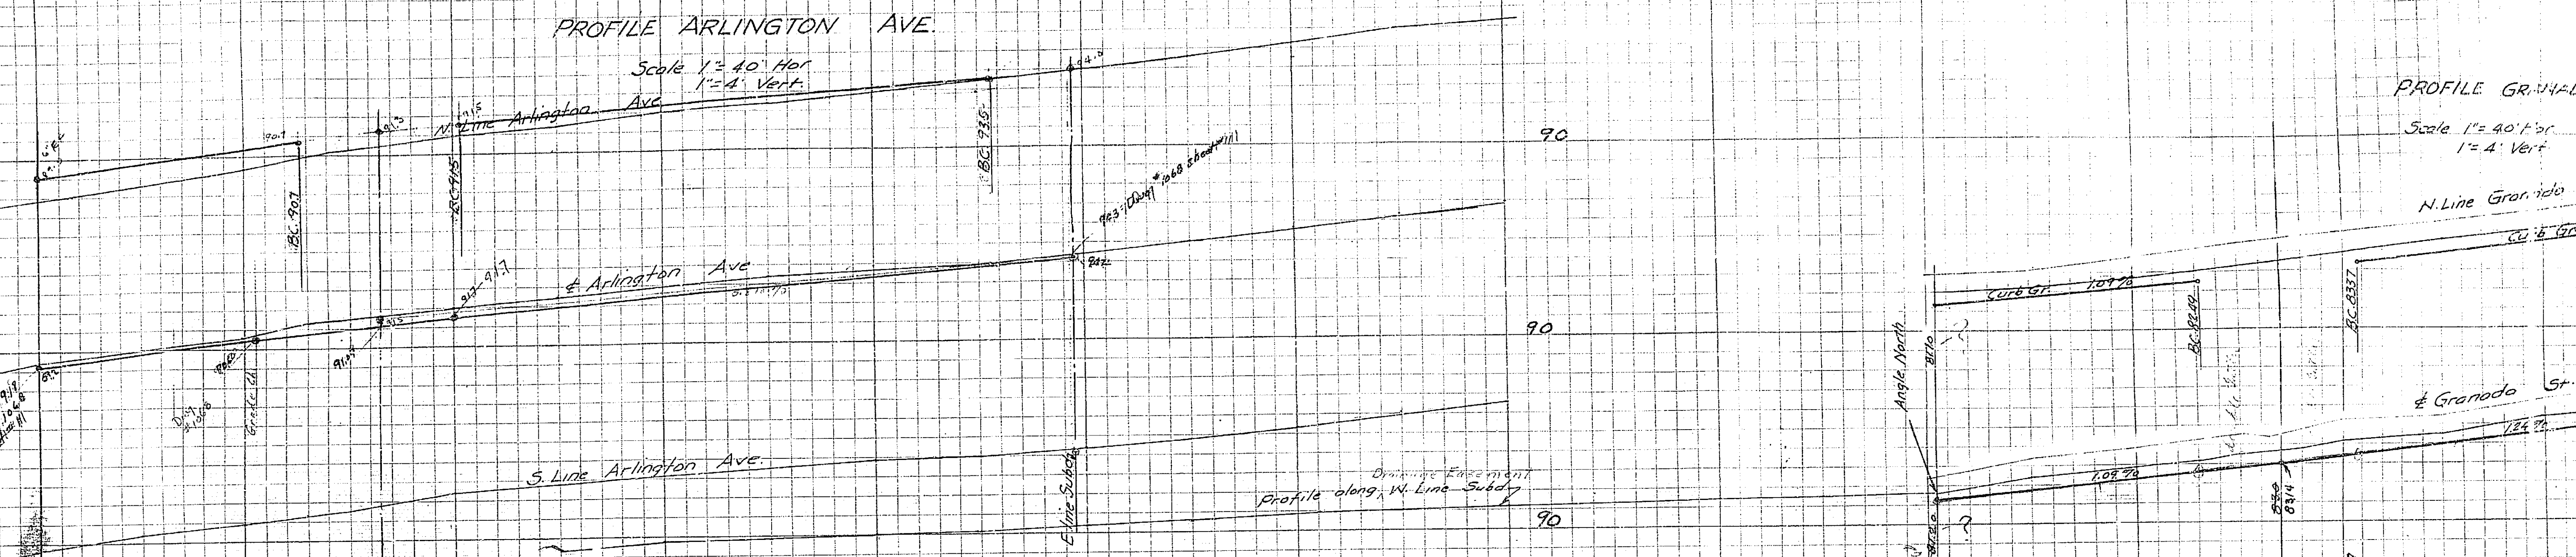

Plan