PROPERTY OF
CITY OF RIVERSIDE
CITY ENGINEERING DEPT.

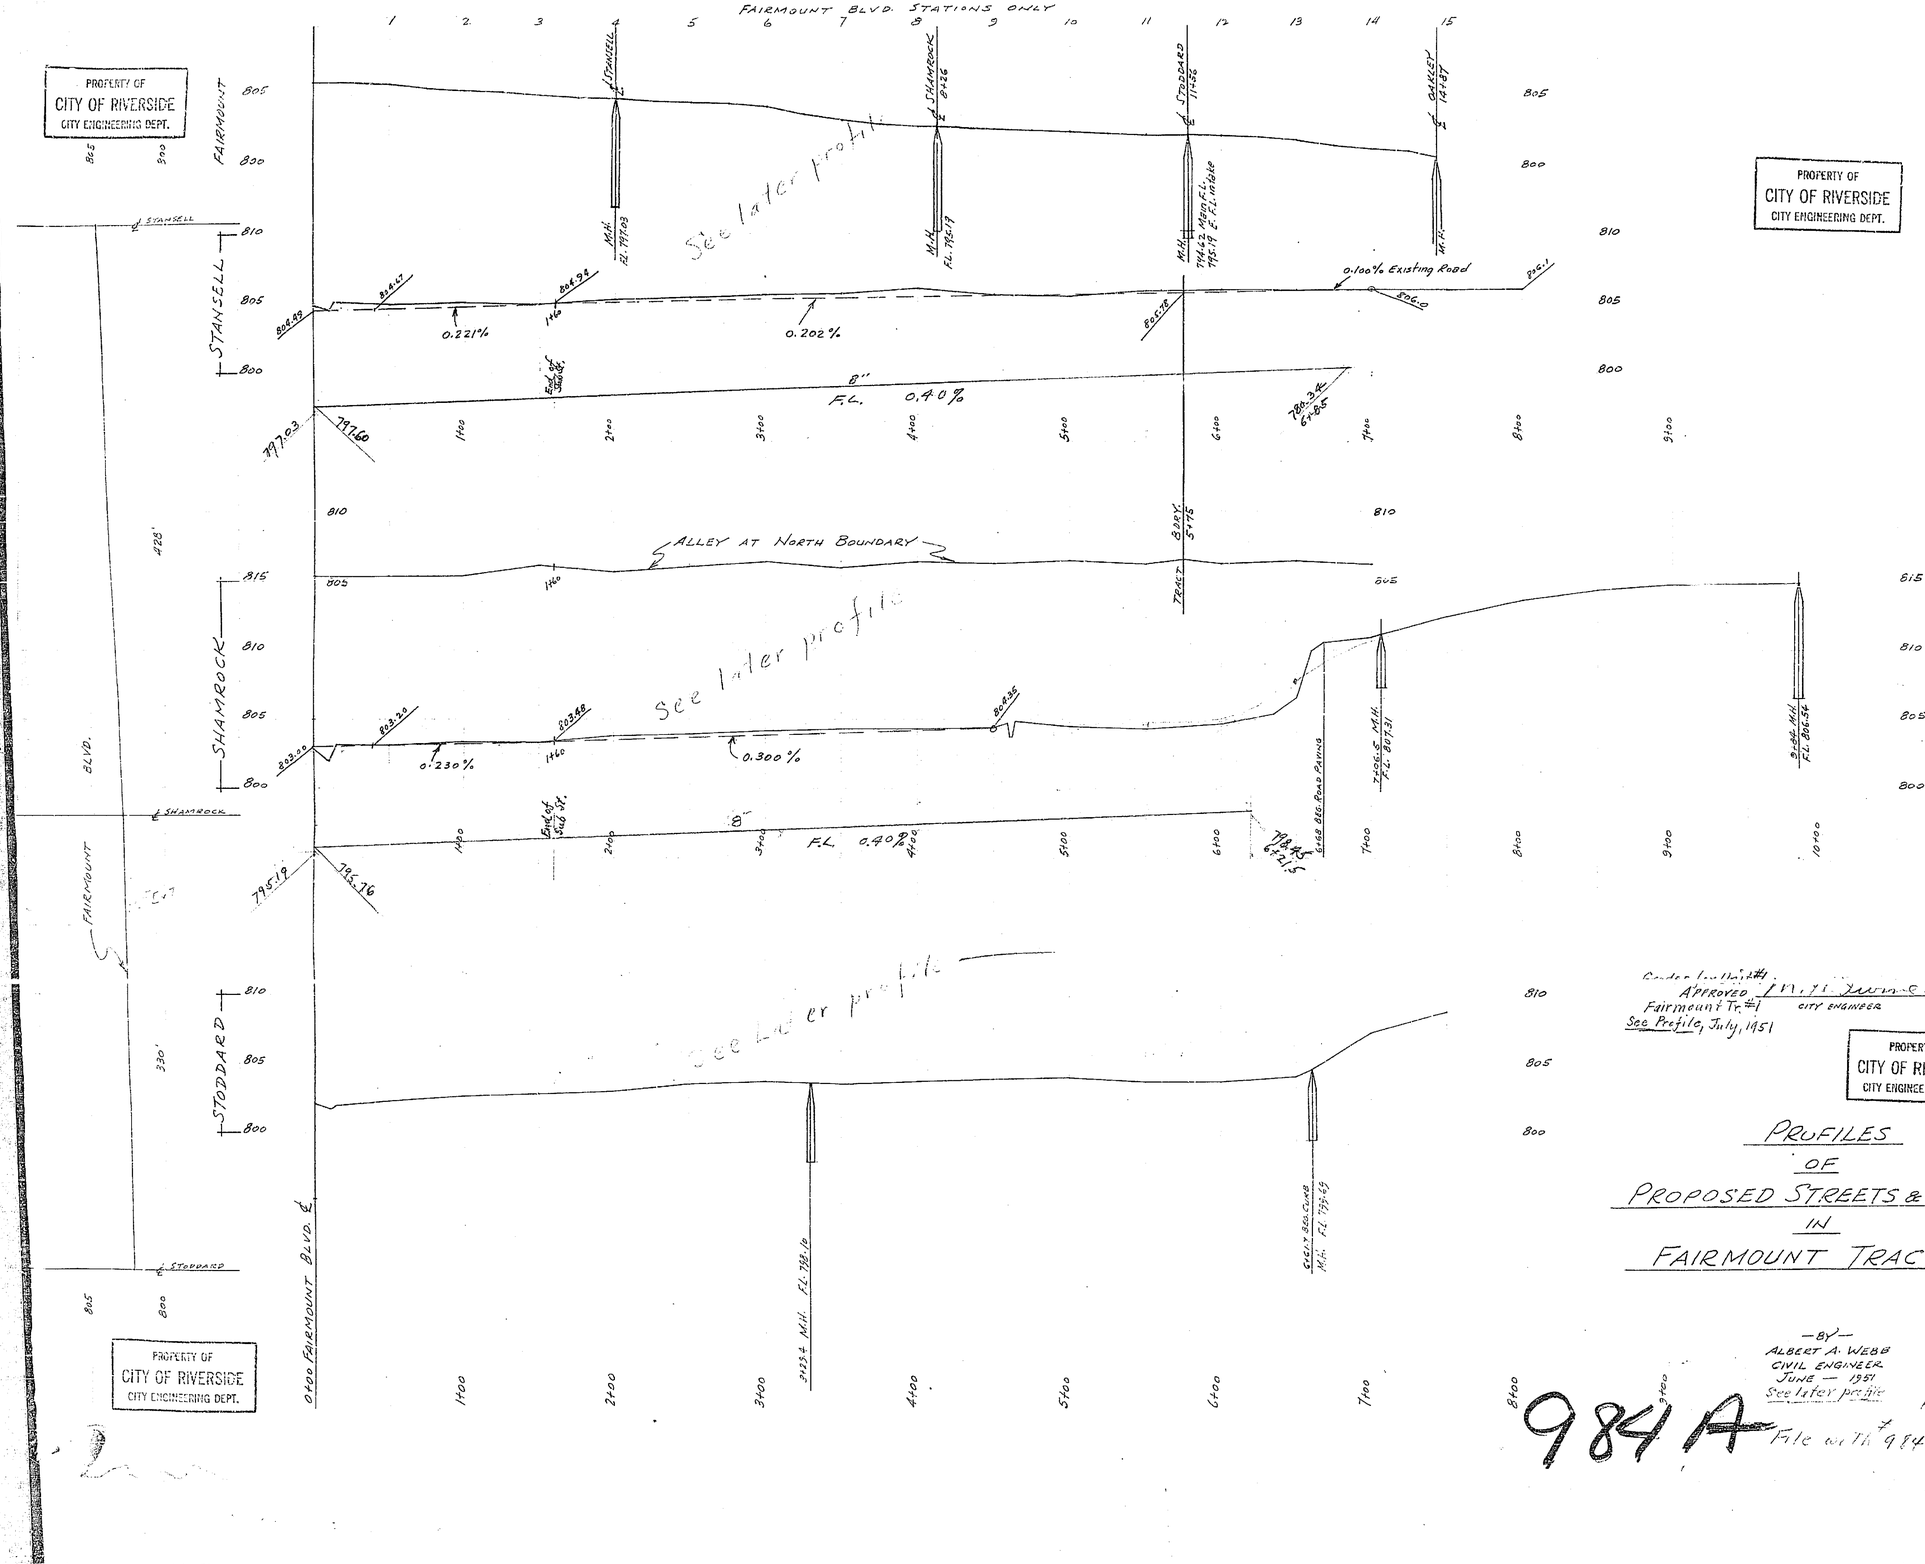

Contract No. 1 #1
Fairmount Tr. #1
See Profile, July, 1951

APPROVED [illegible] June
CITY ENGINEER

PROPERTY OF
CITY OF RIVERSIDE
CITY ENGINEERING DEPT.

PROFILES
OF
PROPOSED STREETS & ALLEY
IN
FAIRMOUNT TRACT

—BY—
ALBERT A. WEBB
CIVIL ENGINEER
JUNE — 1951

See later profile

F.B. 187 W.O. 51-3

984 A File with 984

EA-17