998-A

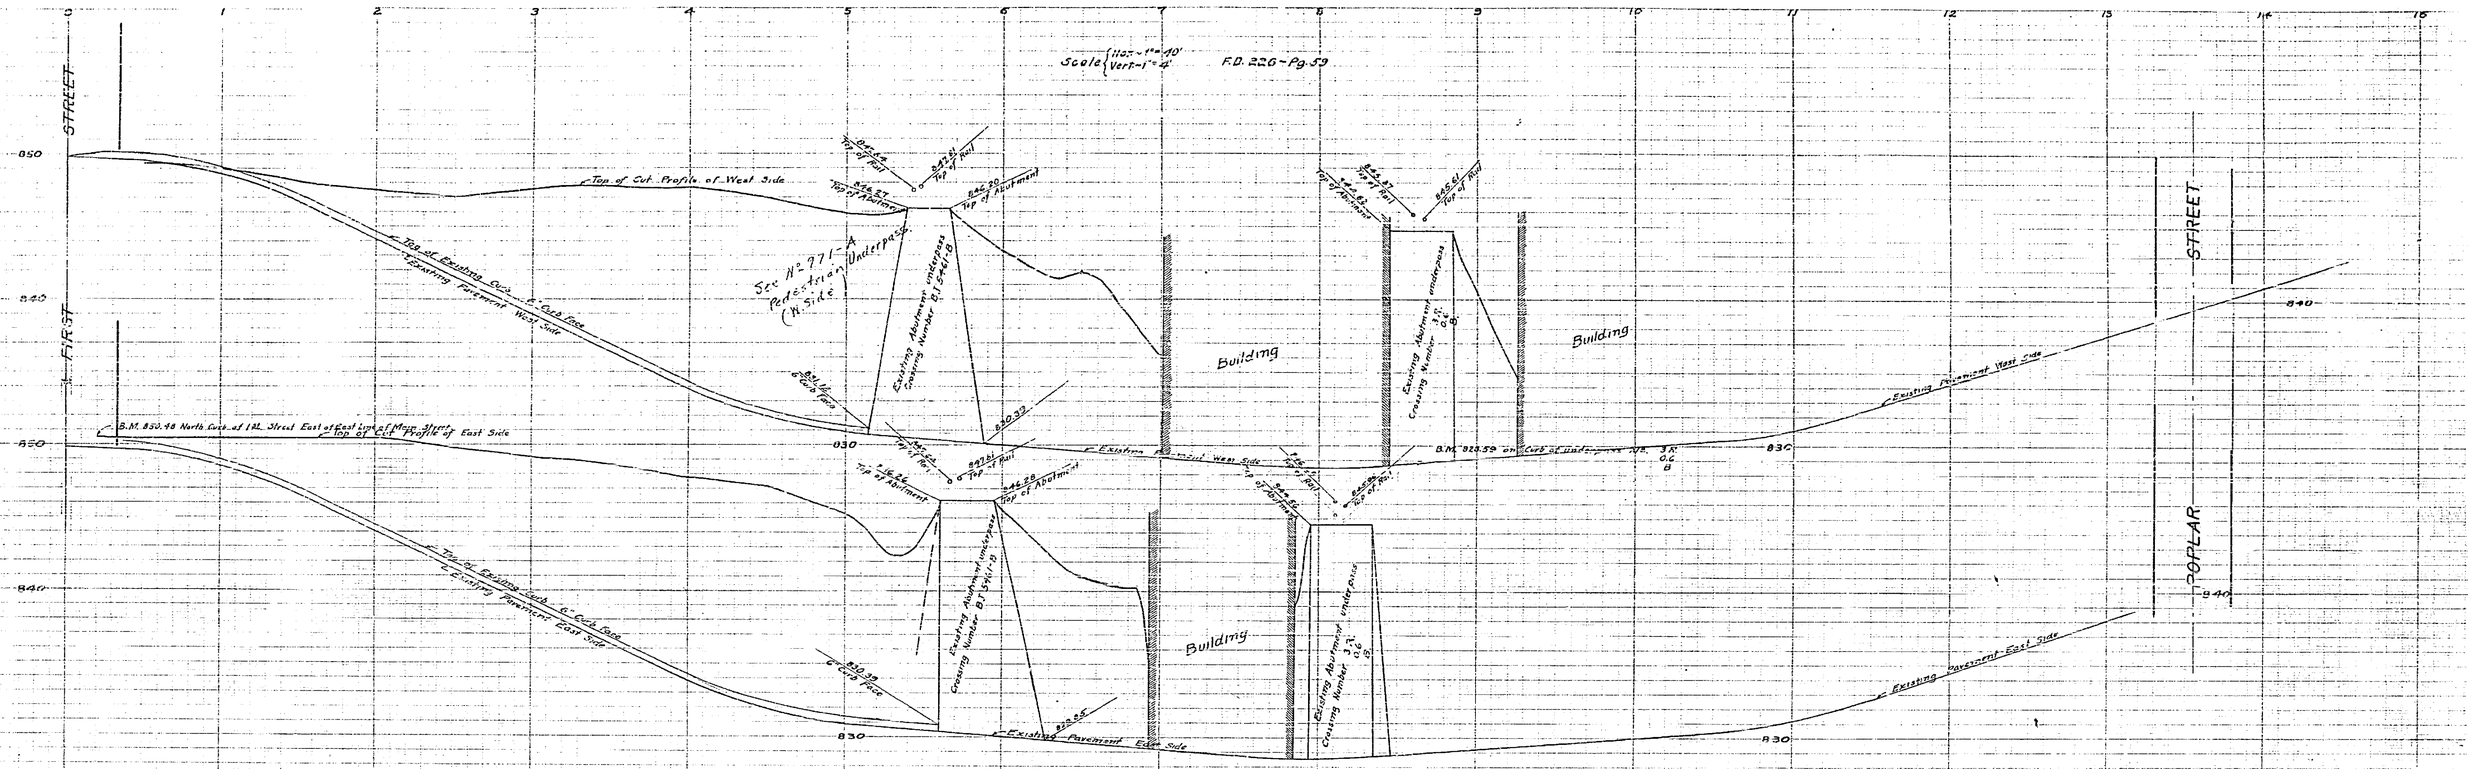

PROFILE
OF
EXISTING GRADE SEPARATION
AT
NORTH MAIN STREET AND SOUTHERN PACIFIC RAILROAD

RAILROAD BRIDGE CROSSING NO. B.J. 5461-B.

ENGINEERING DEPARTMENT — CITY OF RIVERSIDE

EXHIBIT 'H'

998-A